20472 A

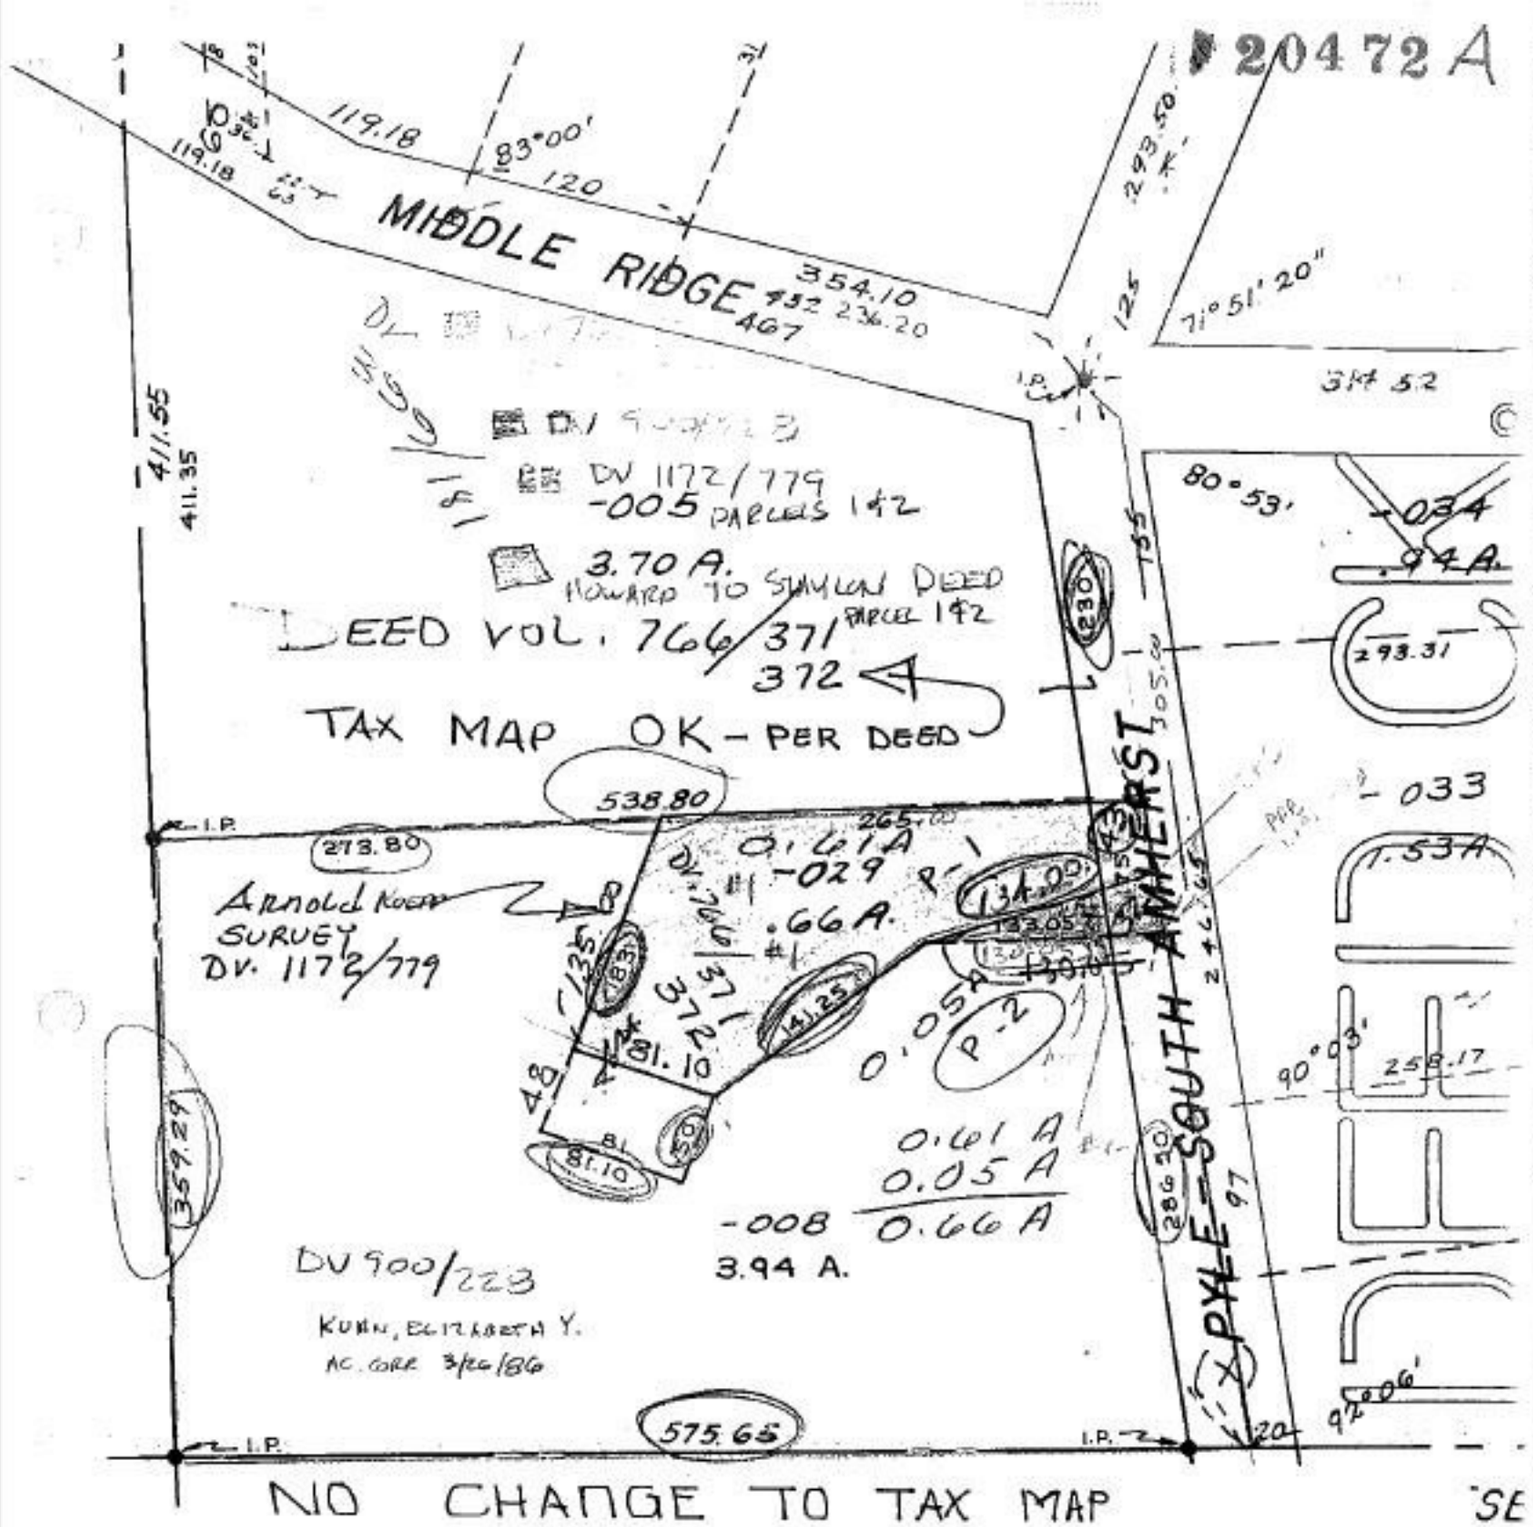

NO CHANGE TO TAX MAP

SE

05-00-015-000-029

LEGAL DISAGREE WITH DV. 766/371

POSSIBLE SPLIT

20472A

APPROVED
LORAIN CO.
MAP DEPT.

DATE 8-13-93

PAGE 5-00-015 A

BY CAROLYN FRANCIS

VOID AFTER # 20472 A