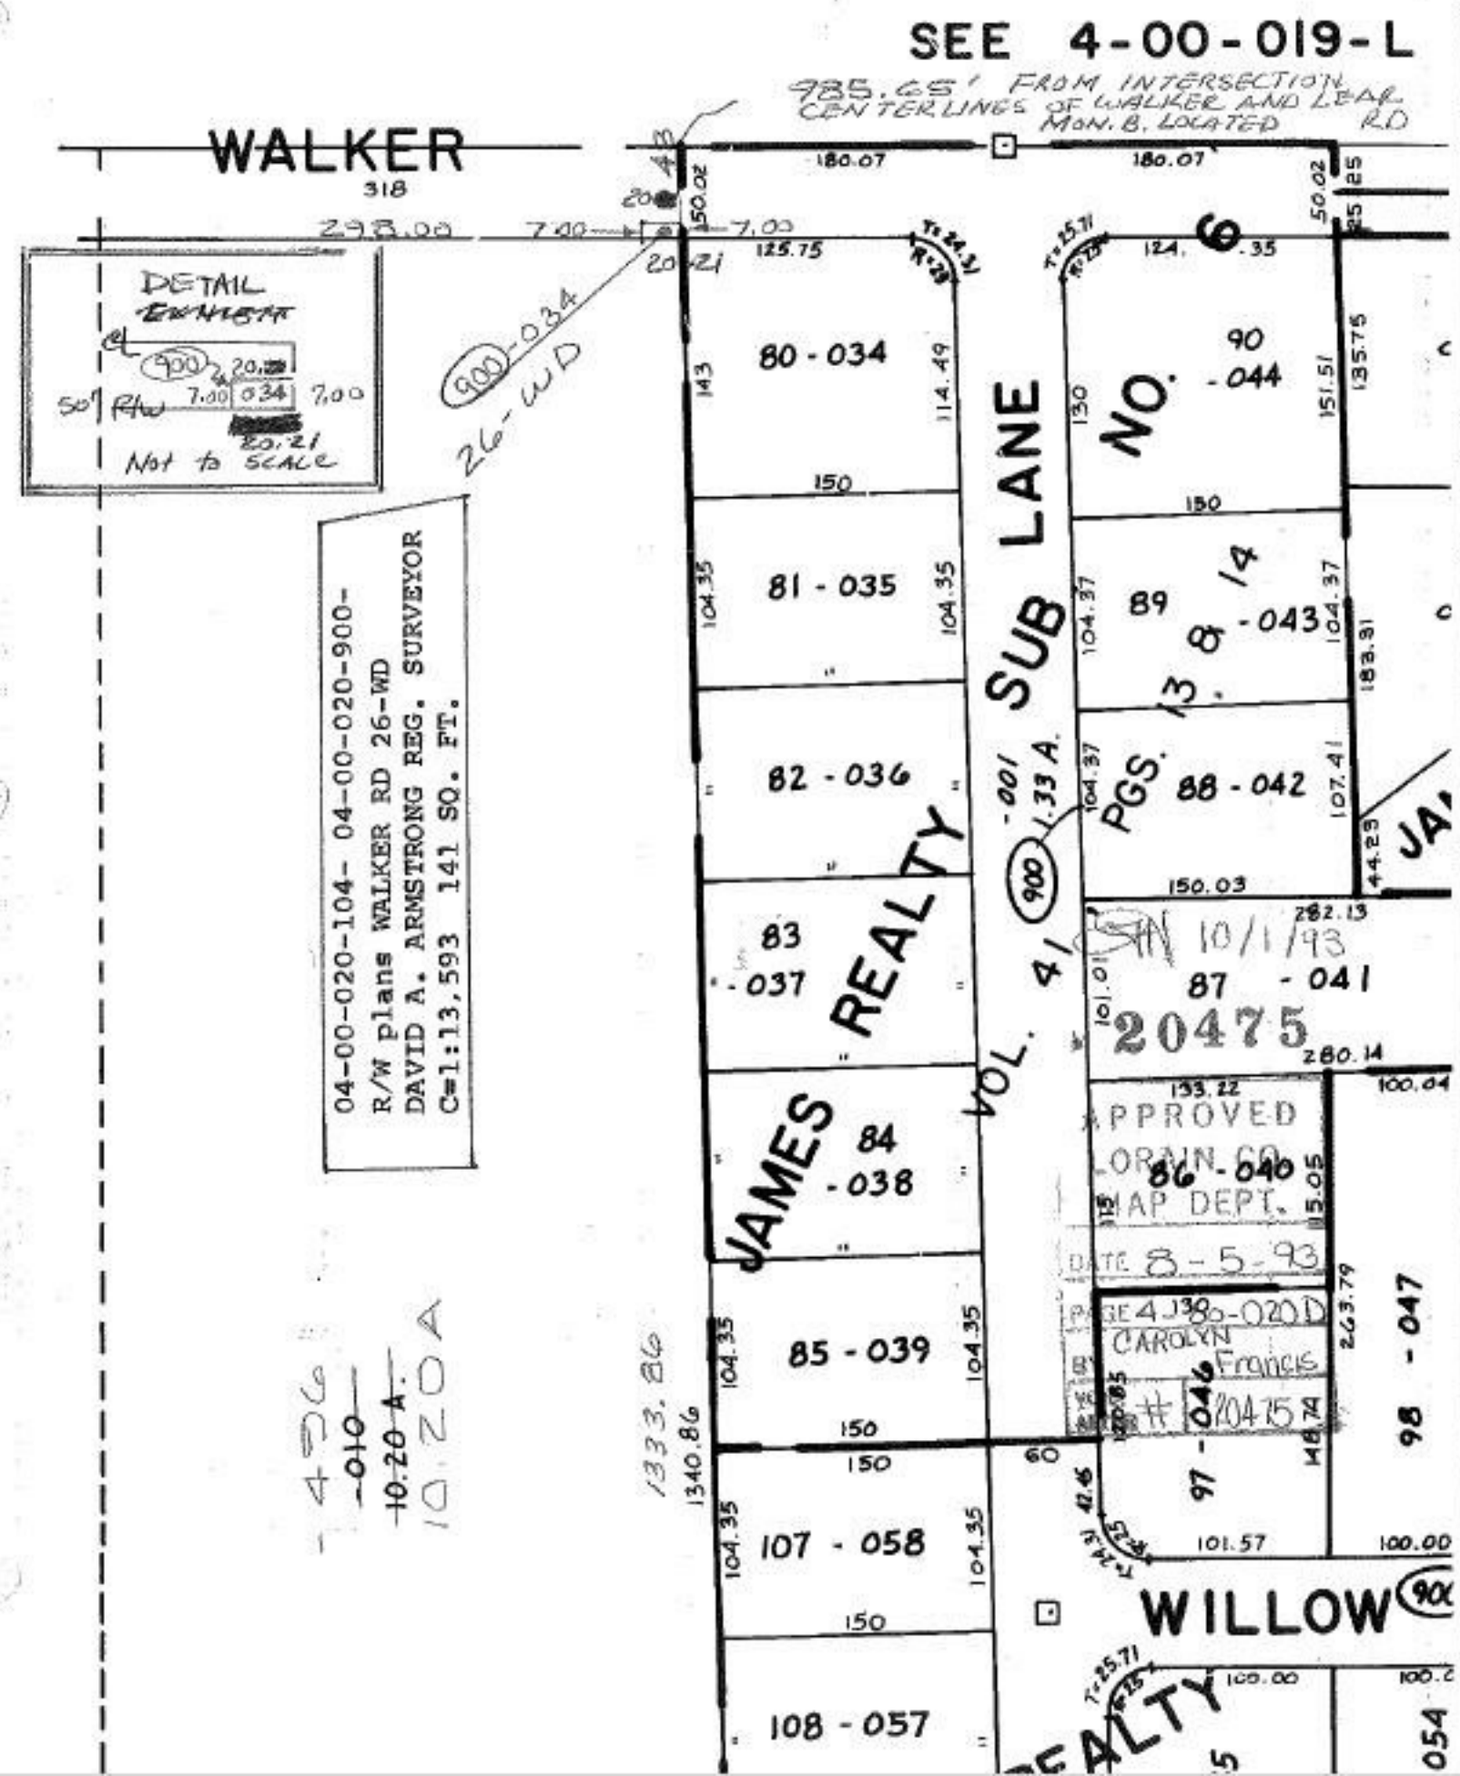
SEE 4-00-019-L
985.65' FROM INTERSECTION CENTERLINES OF WALKER AND LEAR RD MON. B. LOCATED
WALKER
318
298.00
7.00
7.00
DETAIL
Not to SCALE
900-034
26-WD
04-00-020-104- 04-00-020-900-
R/W plans WALKER RD 26-WD
DAVID A. ARMSTRONG REG. SURVEYOR
C=1:13,593 141 SQ. FT.
80-034
81-035
82-036
83-037
84-038
85-039
107-058
108-057
JAMES REALTY
SUB LANE
VOL. 41
PGS. 13 & 14
NO. 6
90-044
89-043
88-042
87-041
86-040
97-046
98-047
WILLOW
20475
APPROVED
LORAIN CO.
MAP DEPT.
DATE 8-5-93
CAROLYN Francis
10/1/93
1333.86
1340.86
10.20 A