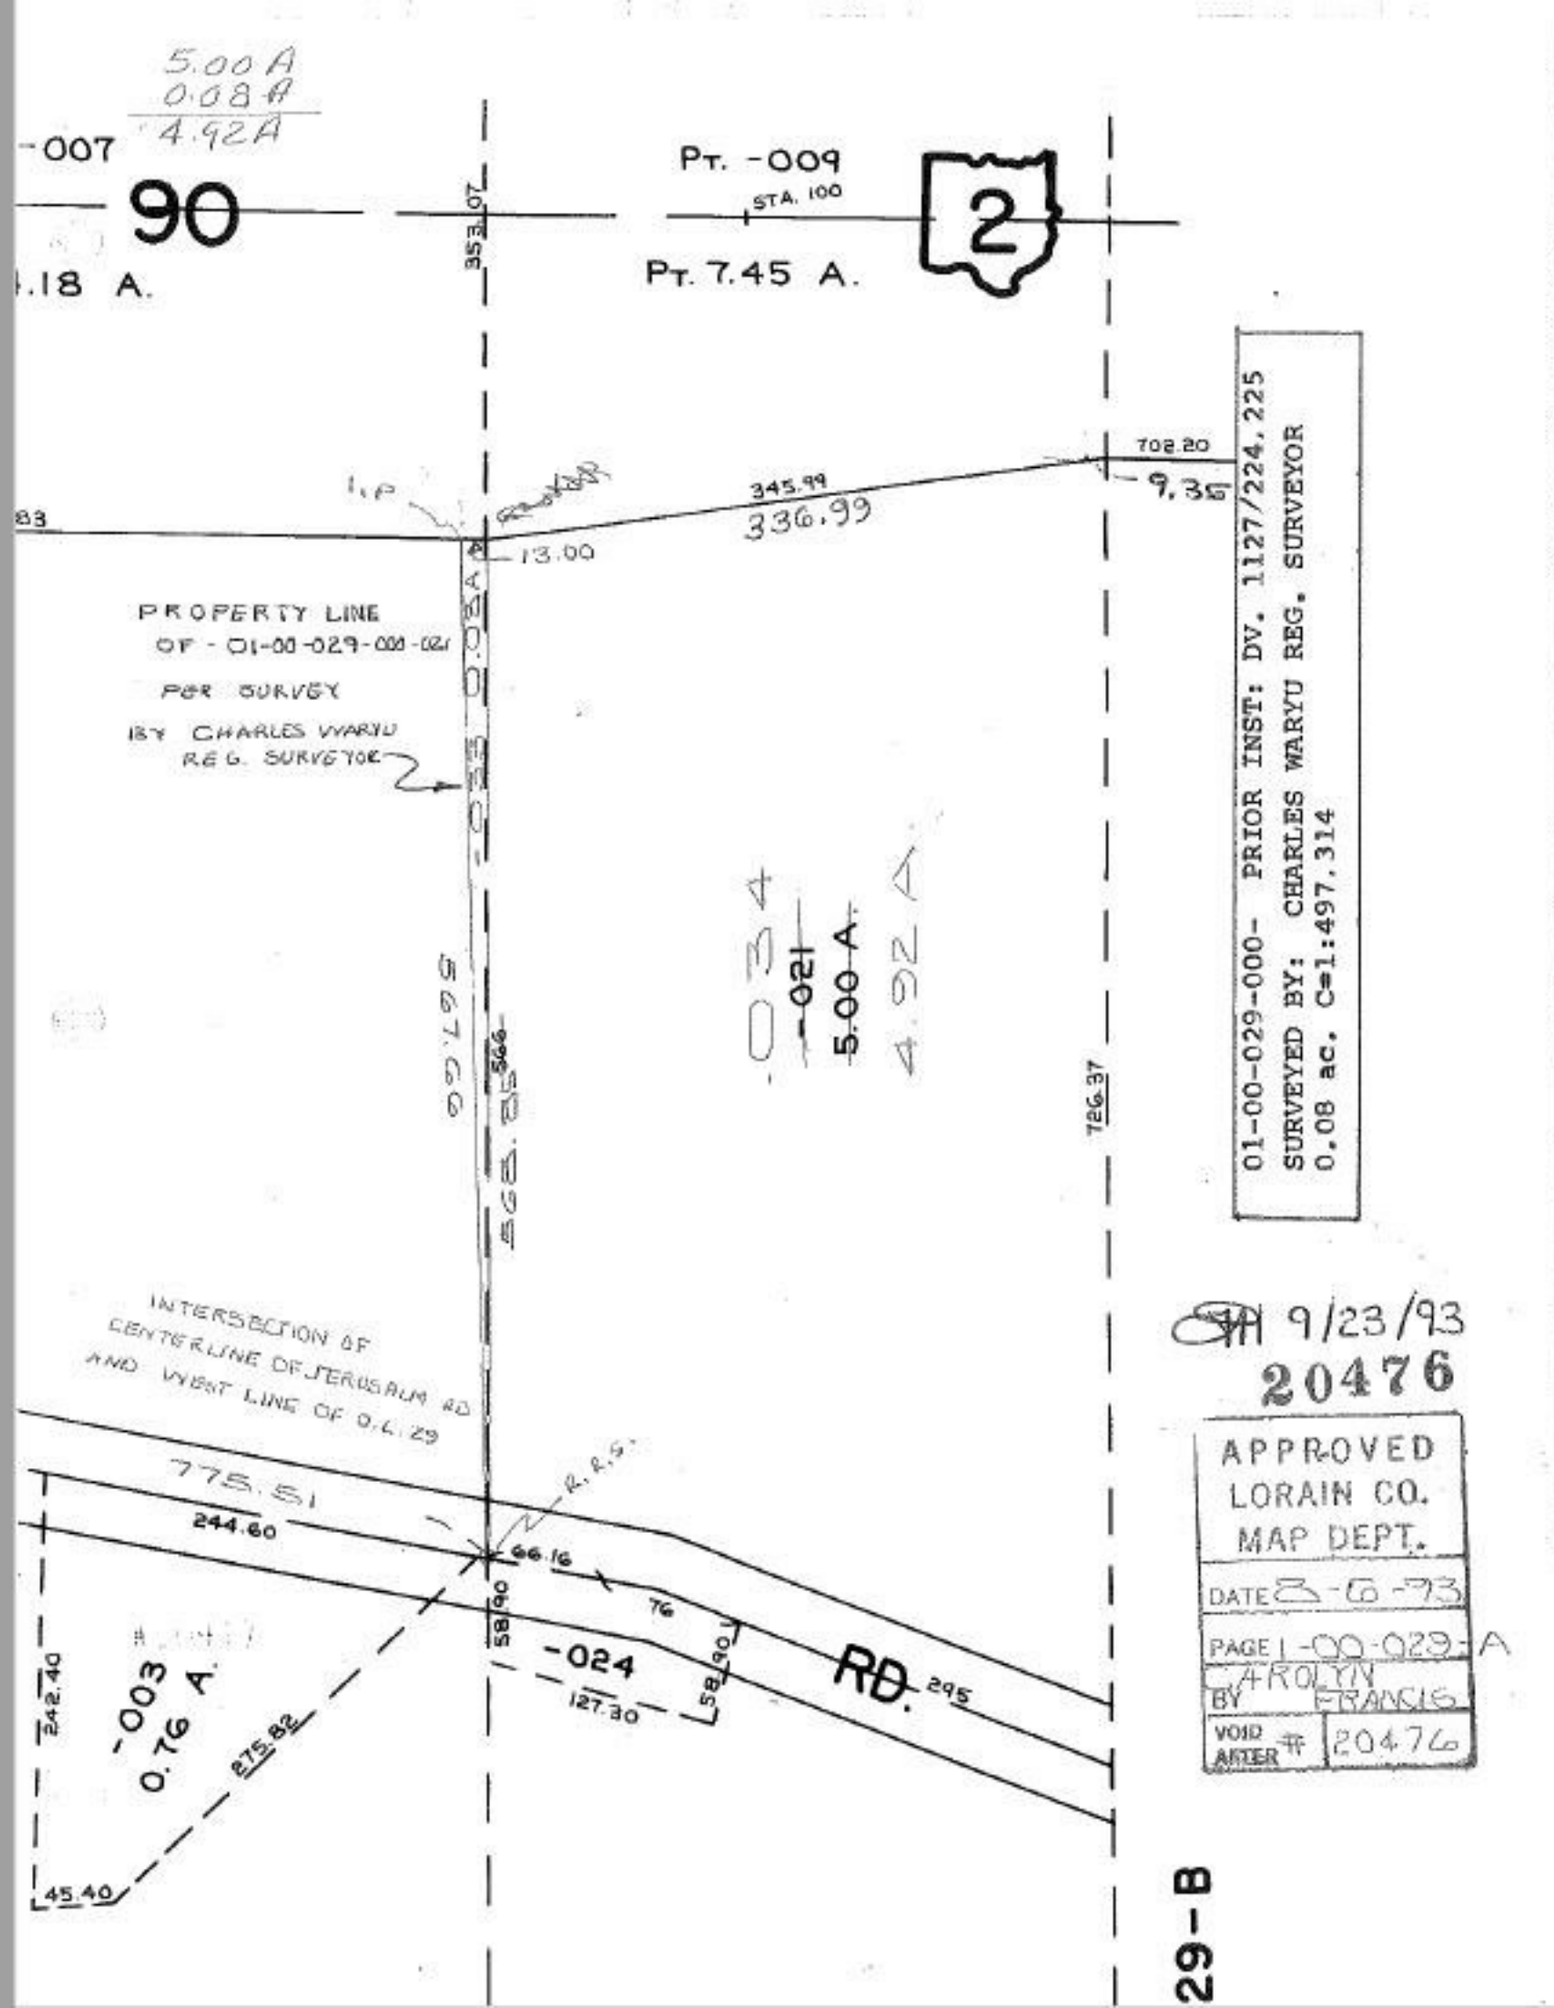
5.00 A
0.08 A
4.92 A
-007
90
.18 A.
353.07
Pt. -009
STA. 100
Pt. 7.45 A.
2
702.20
9.35
345.99
336.99
83
13.00
PROPERTY LINE
OF - 01-00-029-000-021
PER SURVEY
BY CHARLES WARYU
REG. SURVEYOR
-035 0.08 A
567.66
568.85
566
034
-021
5.00 A.
4.92 A
726.37
INTERSECTION OF
CENTERLINE OF JERUSALM RD
AND WEST LINE OF O.L. 29
775.51
244.60
R.R.S.
66.16
76
58.90
-024
127.30
58.90
RD.
295
242.40
-003
0.76 A.
275.82
45.40
01-00-029-000- PRIOR INST: DV. 1127/224,225
SURVEYED BY: CHARLES WARYU REG. SURVEYOR
0.08 ac. C=1:497,314
9/23/93
20476
APPROVED
LORAIN CO.
MAP DEPT.
DATE 8-6-93
PAGE 1-00-029-A
BY CAROLYN FRANCIS
VOID AFTER # 20476
29-B