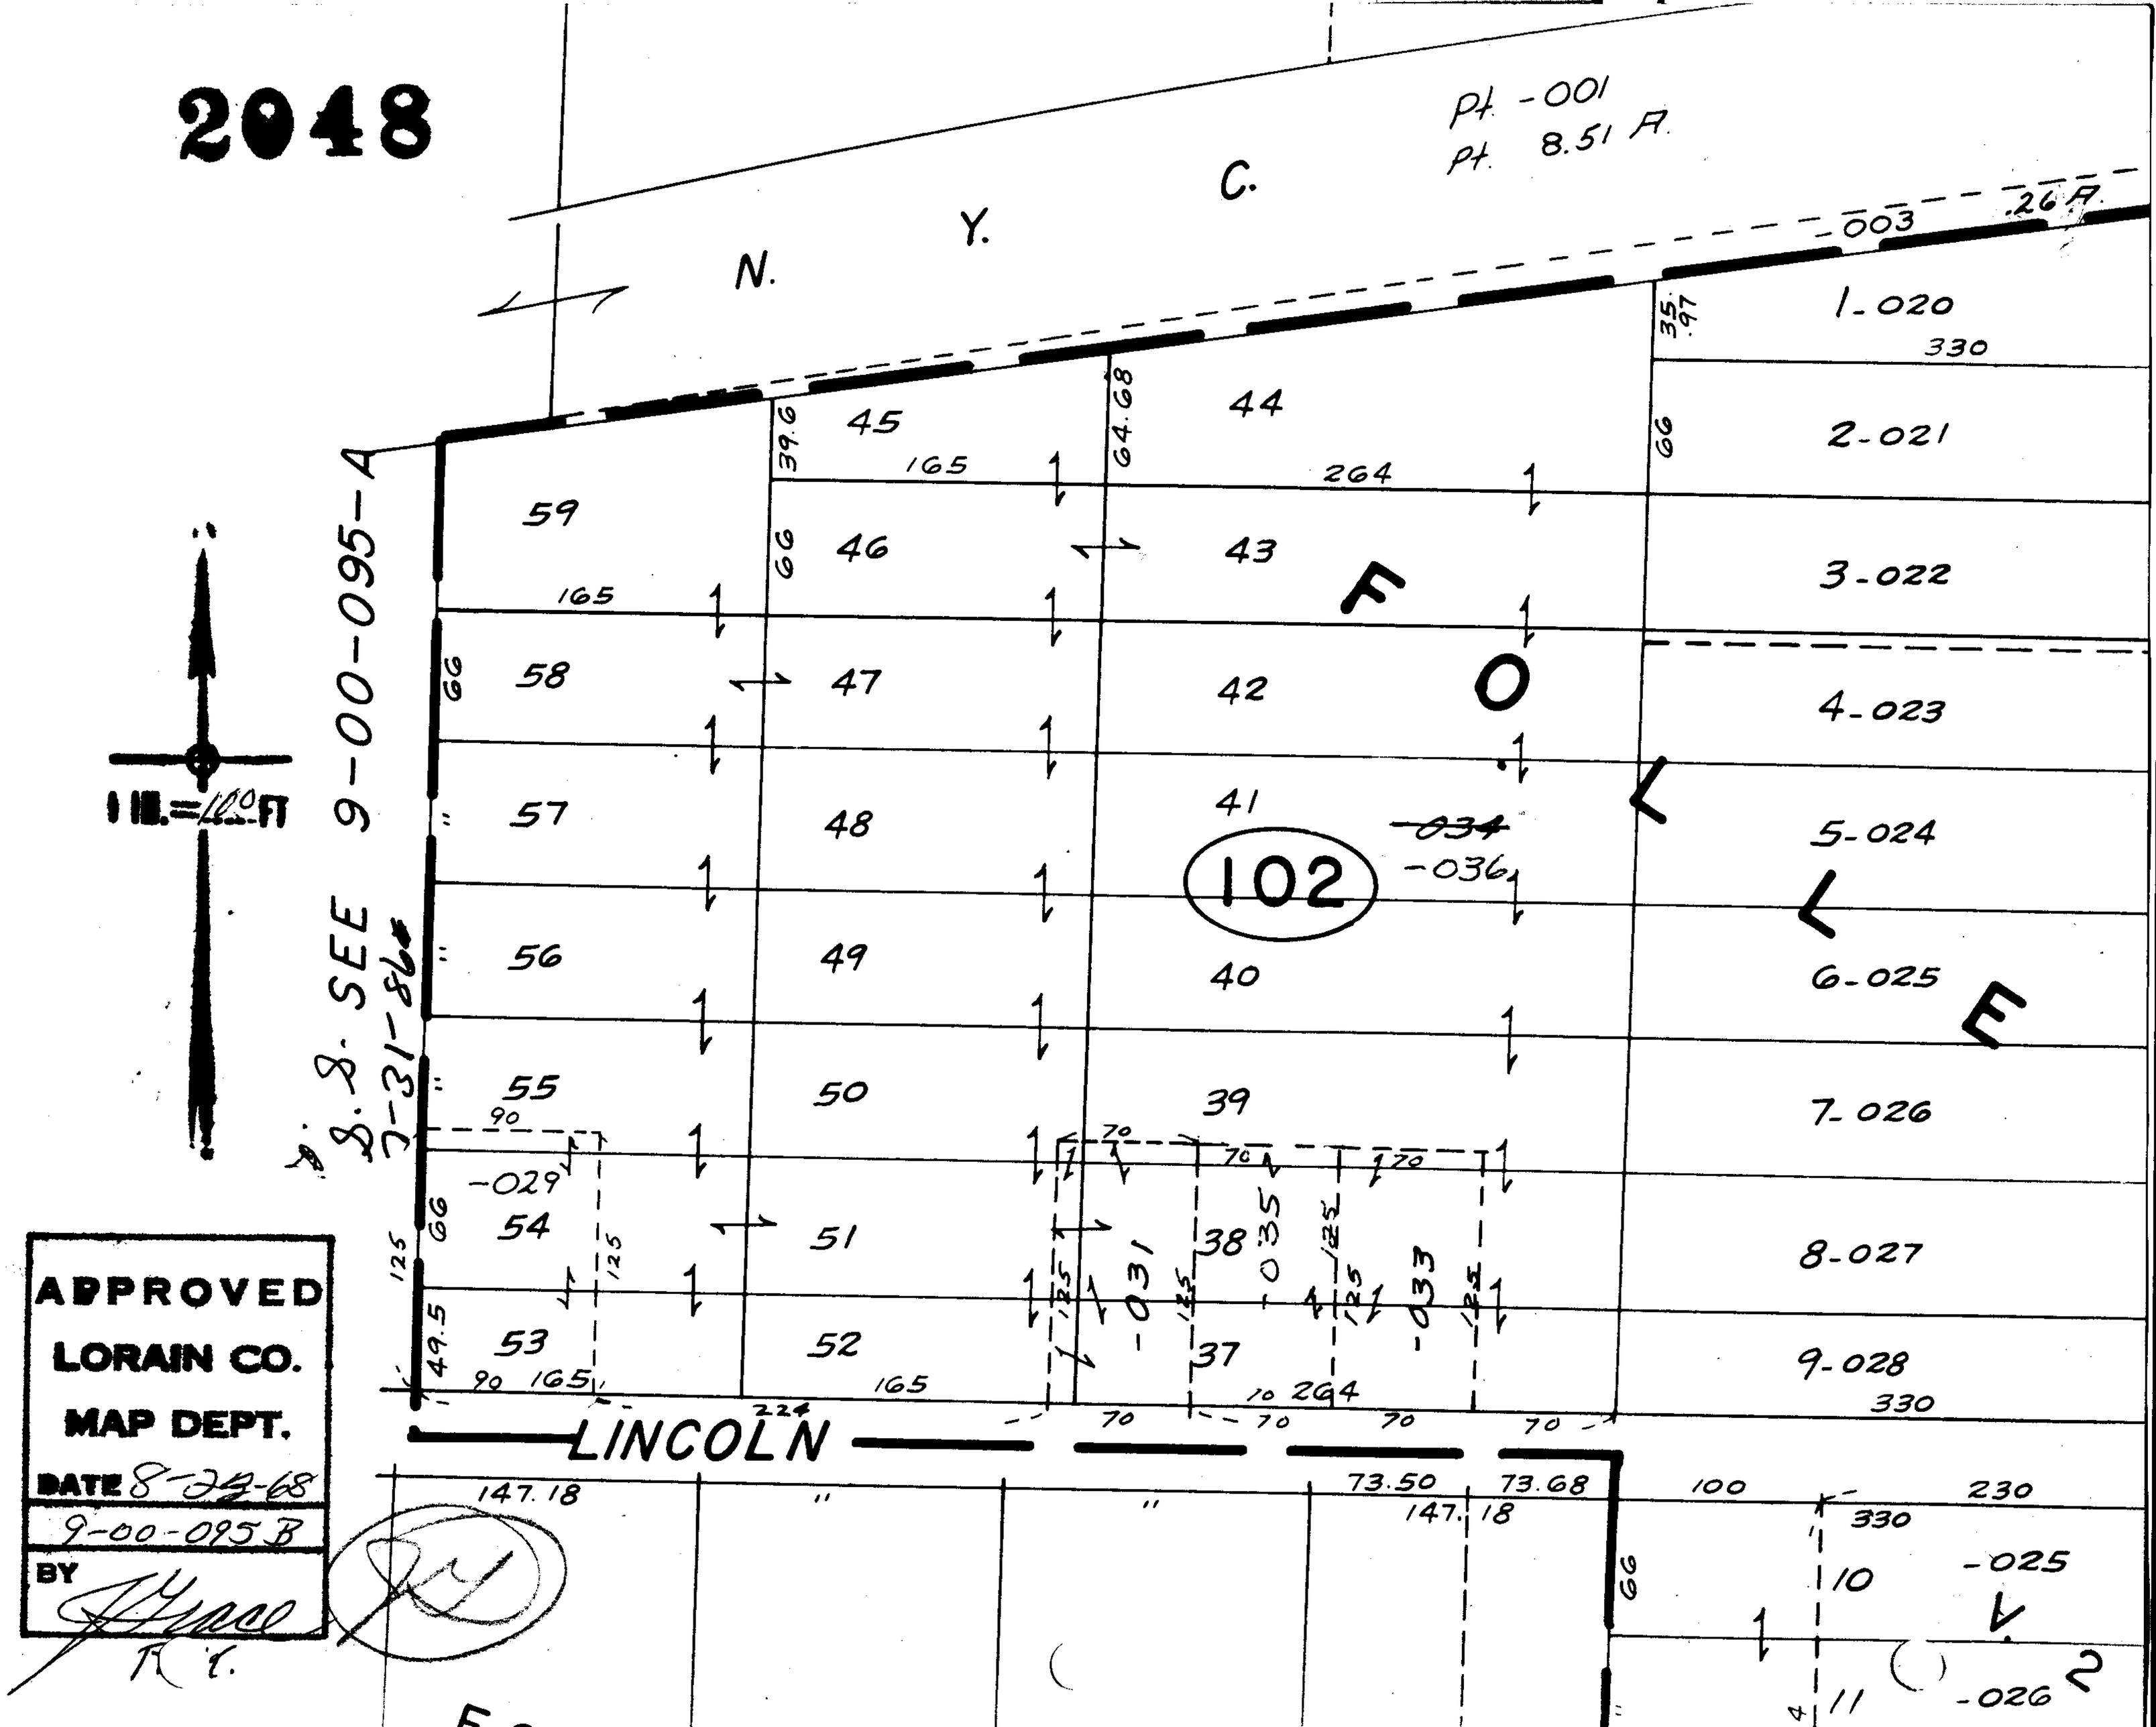
2048
N. Y. C.
Pt. -001
Pt. 8.51 A.
-003
.26 A.
1-020
2-021
3-022
4-023
5-024
6-025
7-026
8-027
9-028
FOLLE
102
-034
-036
-029
-031
-035
-033
LINCOLN
9-00-095-A
S. S. SEE 7-31-86
1 IN. = 100 FT
APPROVED
LORAIN CO.
MAP DEPT.
DATE 8-23-68
9-00-095 B
BY
-025
-026
V. 2