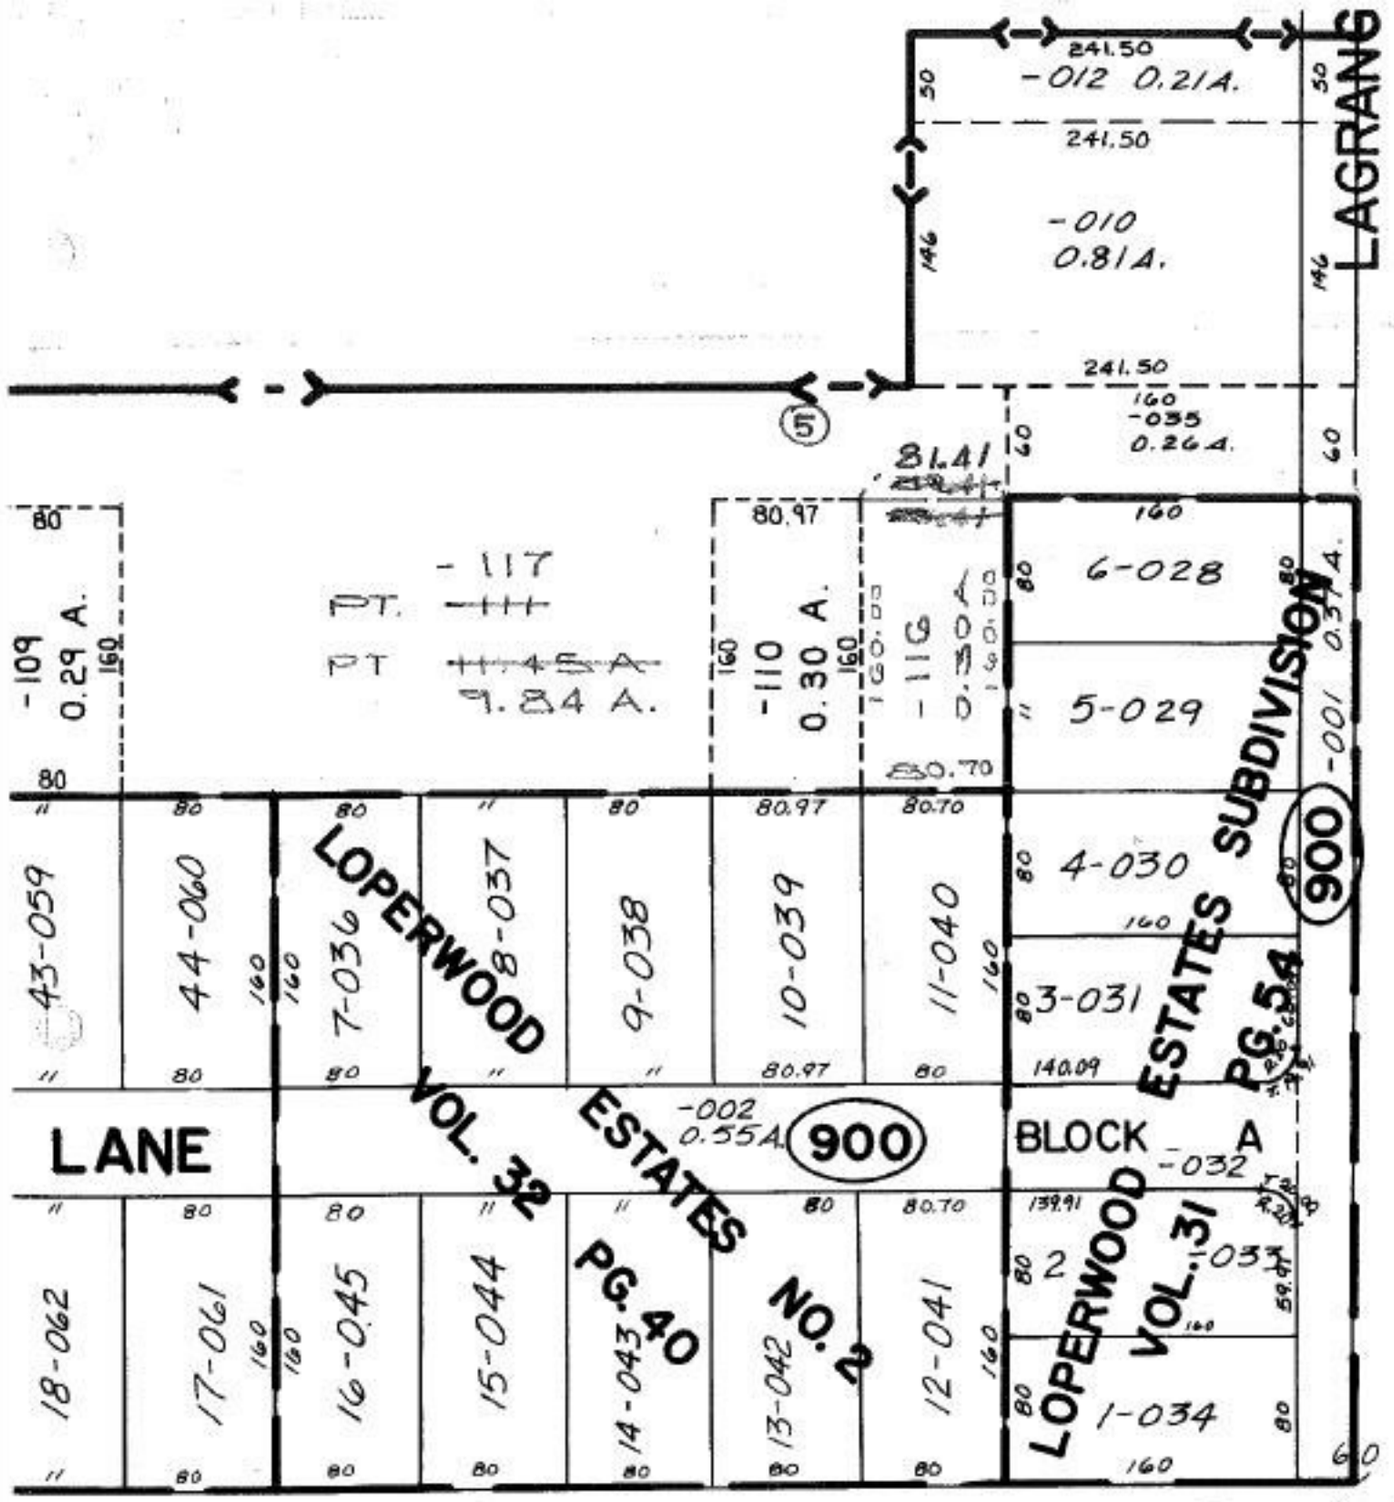

15-00-045-B

4/4/94
20480

APPROVED
LORAIN CO.
MAP DEPT.
DATE 8-18-93
PAGE 15-00-036 B
BY CAROLYN FRANCIS
VOID AUDIR # 20480