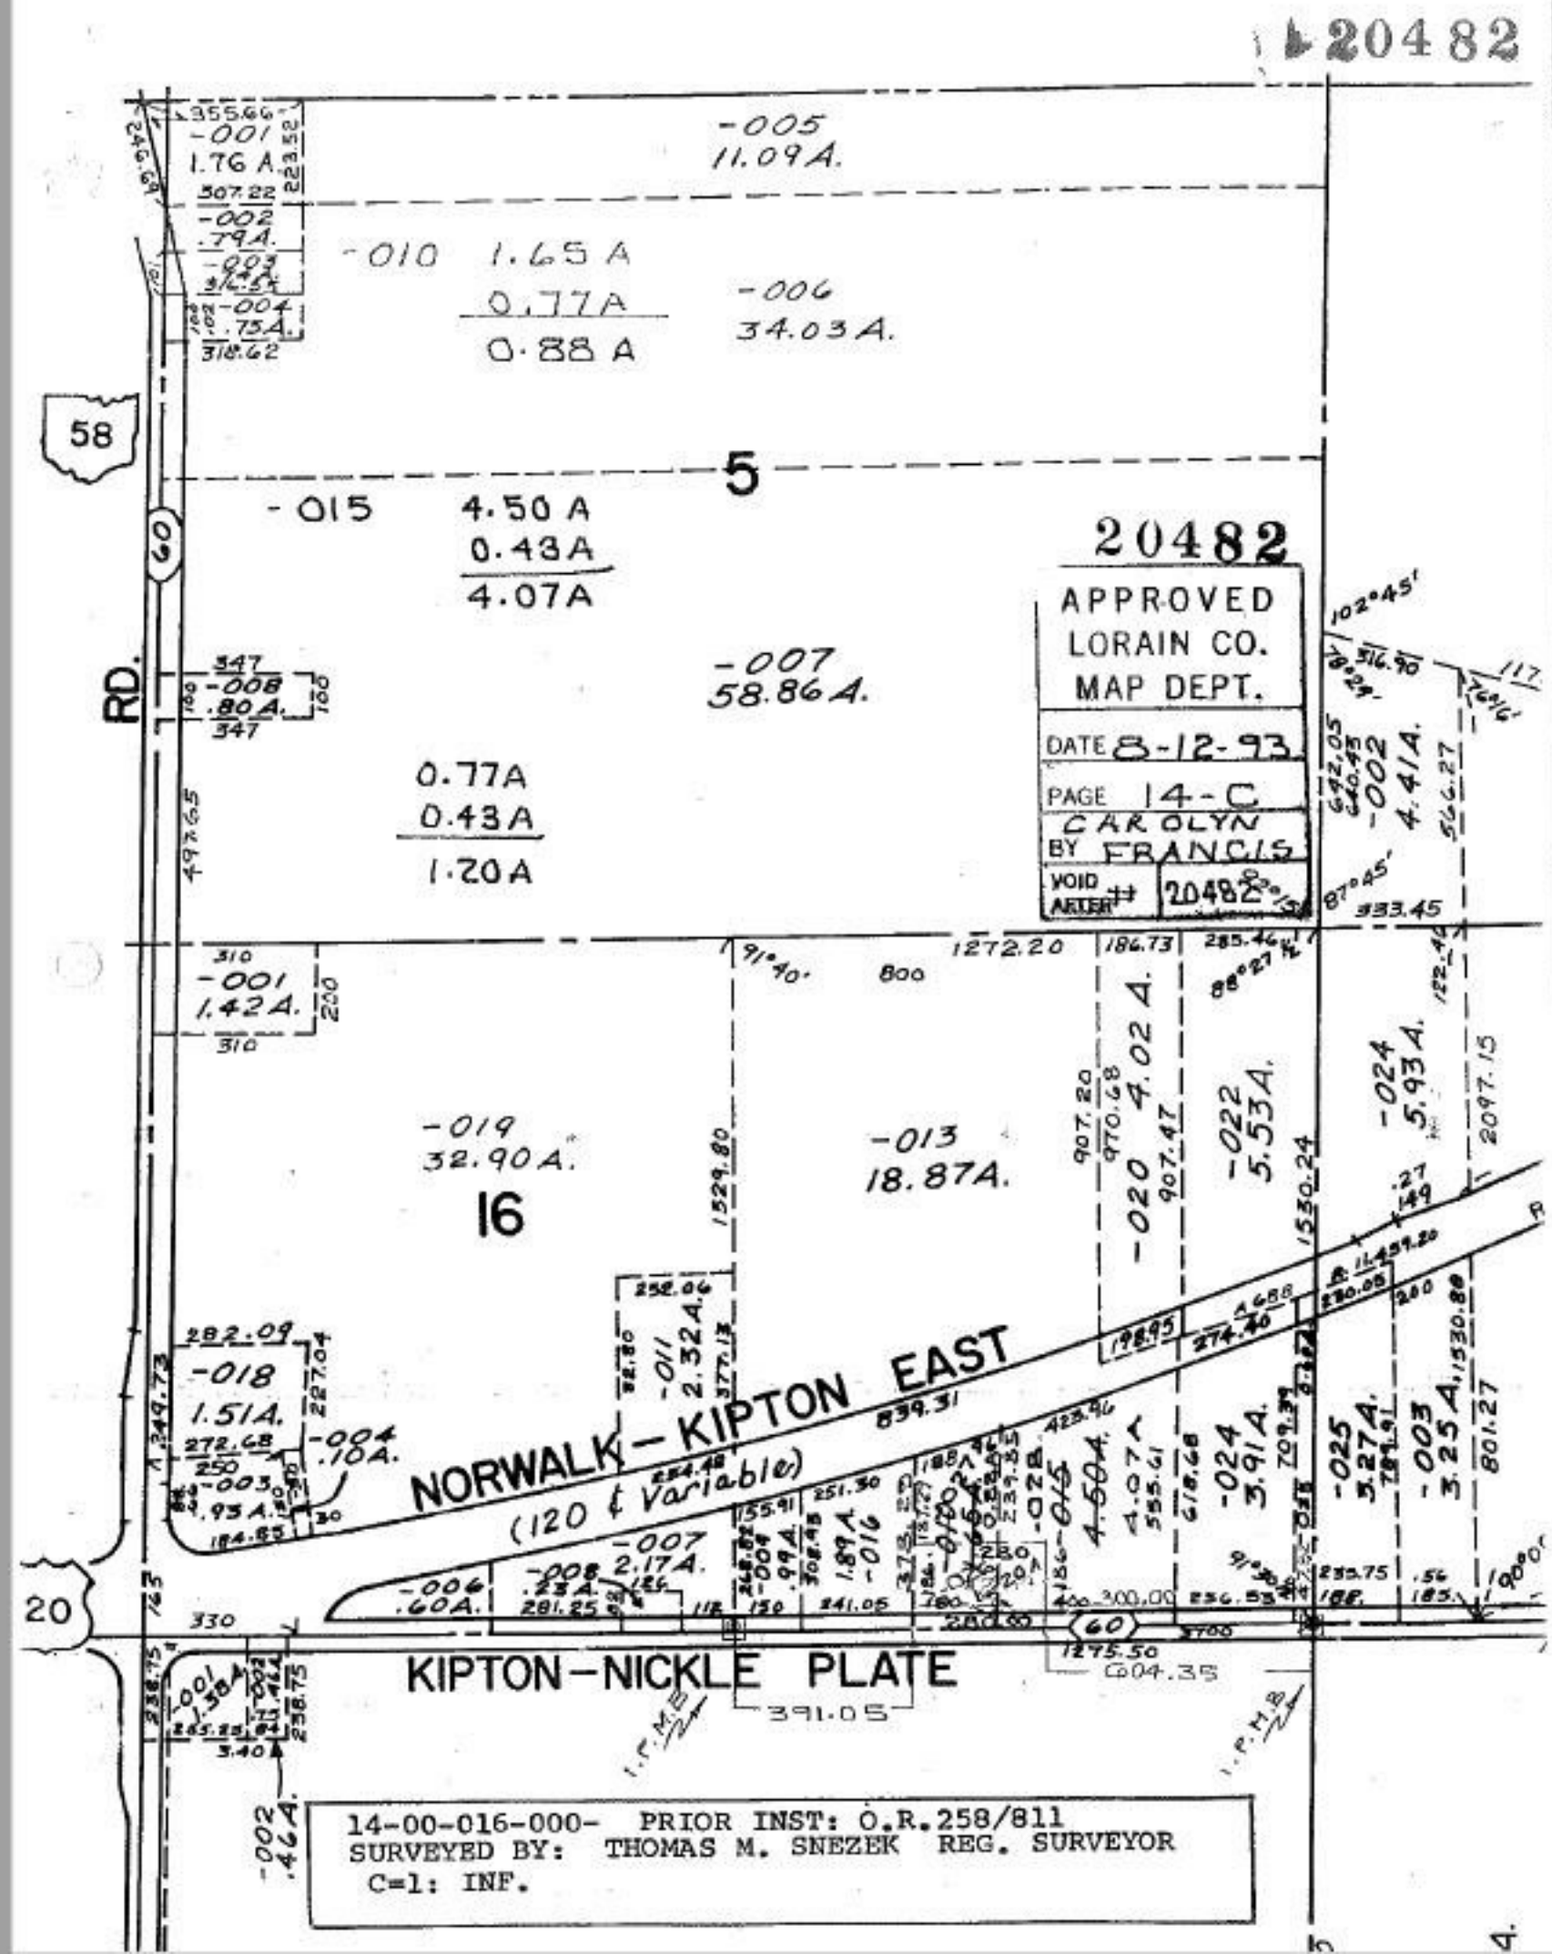
20482
APPROVED
LORAIN CO.
MAP DEPT.
DATE 8-12-93
PAGE 14-C
CAROLYN
BY FRANCIS
VOID AFTER # 20482
-005
11.09A.
-010 1.65 A
0.77A
0.88 A
-006
34.03A.
58
5
-015 4.50 A
0.43A
4.07A
-007
58.86A.
0.77A
0.43A
1.20A
RD.
60
-001
1.76 A
-002
.79A.
-004
.75A.
-008
.80A.
-001
1.42A.
-019
32.90A.
16
-013
18.87A.
-020 4.02 A.
-022
5.53A.
-024
5.93A.
-002
4.41A.
-018
1.51A.
-004
.10A.
-003
.93A.
-011
2.32A.
-007
2.17A.
-006
.60A.
-008
.23A.
-016
1.89A.
-015
4.50A.
-024
3.91A.
-025
3.27A.
-003
3.25A.
NORWALK-KIPTON EAST
(120 ¢ Variable)
20
KIPTON-NICKLE PLATE
391.05
604.35
-002
.46A.
14-00-016-000- PRIOR INST: O.R.258/811
SURVEYED BY: THOMAS M. SNEZEK REG. SURVEYOR
C=1: INF.