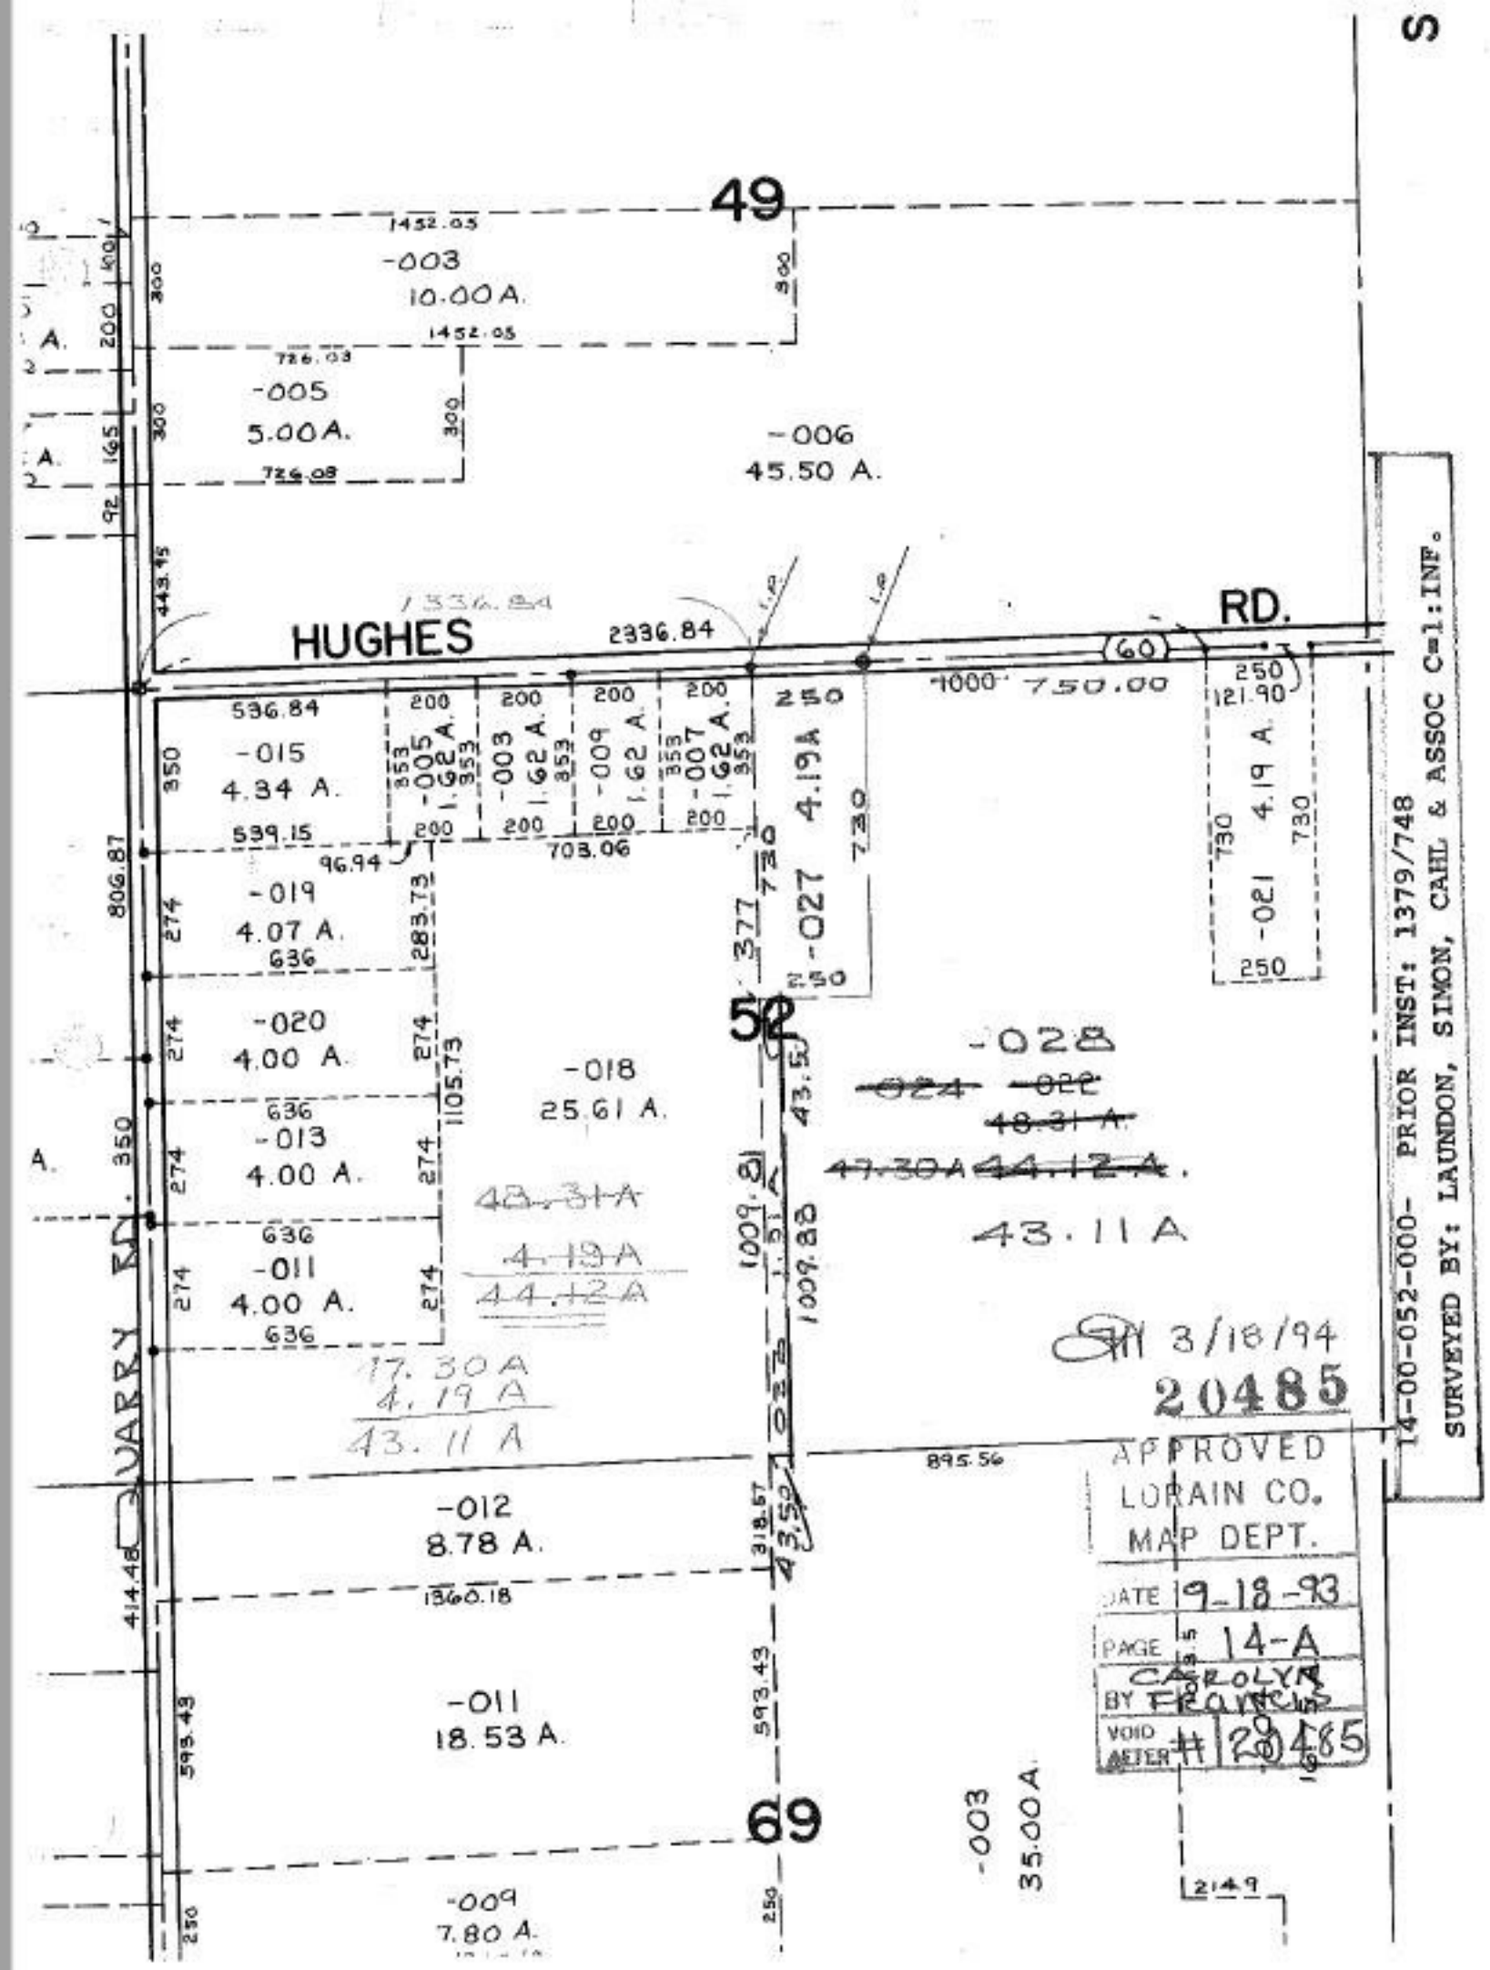
49
-003
10.00 A.
-005
5.00 A.
-006
45.50 A.
HUGHES
RD.
2336.84
750.00
-015
4.34 A.
-005
1.62 A.
-003
1.62 A.
-009
1.62 A.
-007
1.62 A.
-027
4.19 A
-021
4.19 A.
-019
4.07 A.
-020
4.00 A.
-013
4.00 A.
-011
4.00 A.
-018
25.61 A.
52
-028
43.11 A
QUARRY RD.
-012
8.78 A.
-011
18.53 A.
69
-009
7.80 A.
-003
35.00 A.
14-00-052-000- PRIOR INST: 1379/748
SURVEYED BY: LAUNDON, SIMON, CAHL & ASSOC C=1:INF.
3/18/94
20485
APPROVED
LORAIN CO.
MAP DEPT.
DATE 9-18-93
PAGE 14-A
BY CAROLYN FRANCIS
VOID AFTER # 20485