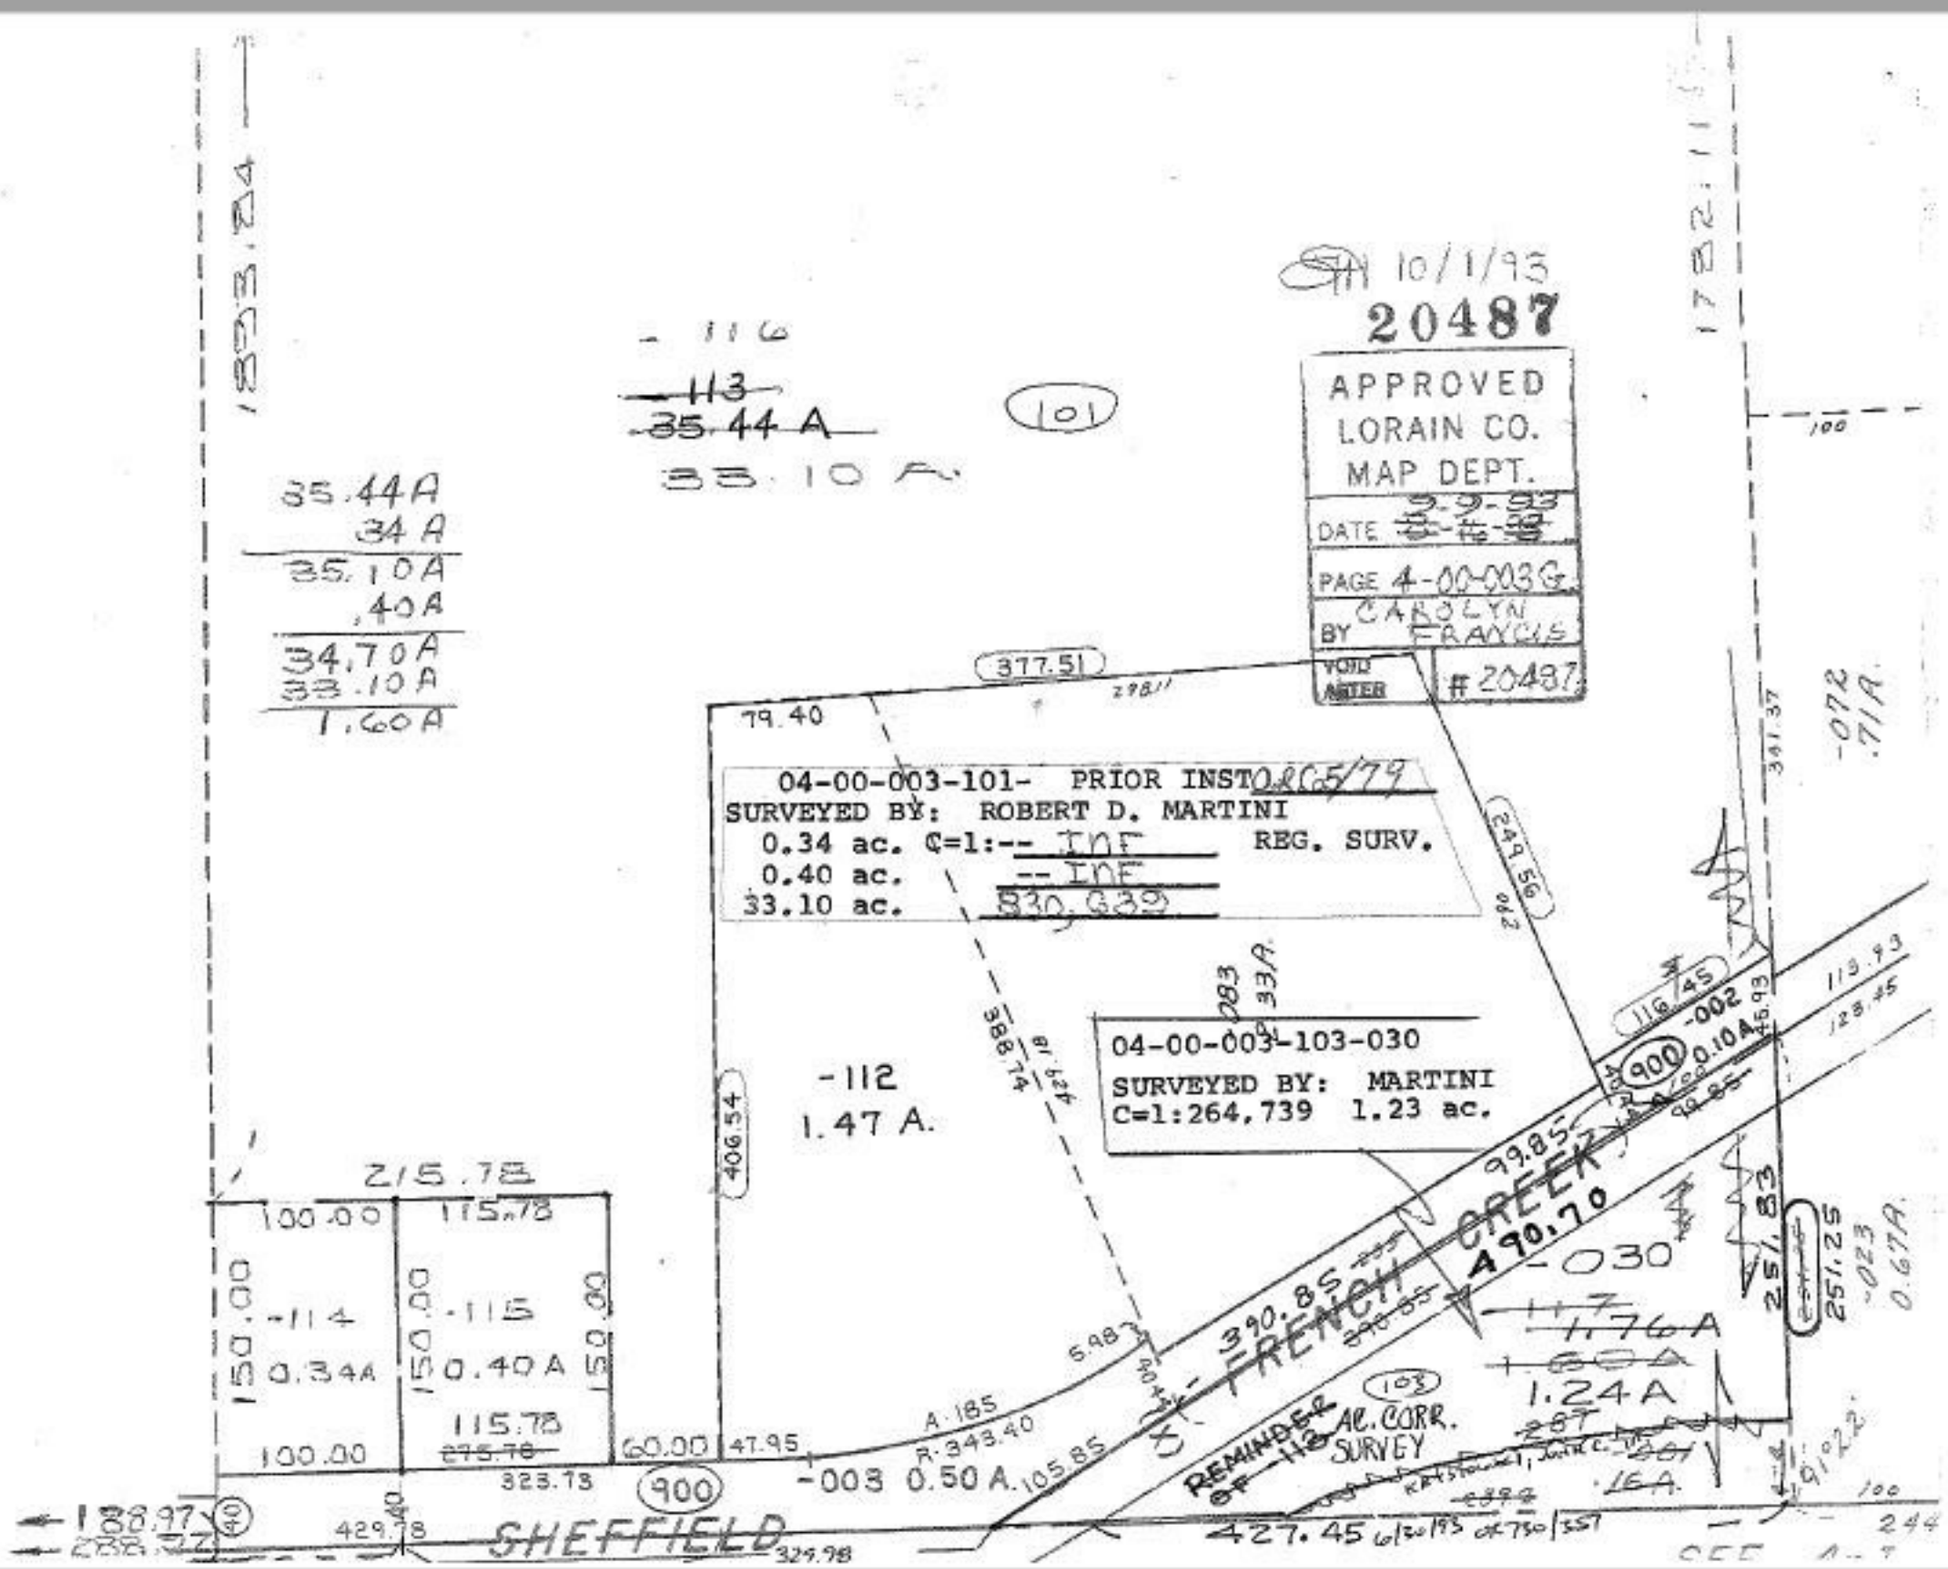

10/1/93
20487
APPROVED
LORAIN CO.
MAP DEPT.
DATE 9-9-93
PAGE 4-00-003G
BY CAROLYN FRANCIS
VOID AFTER
20487
04-00-003-101- PRIOR INST
SURVEYED BY: ROBERT D. MARTINI
0.34 ac. C=1:-- INF REG. SURV.
0.40 ac. -- INF
33.10 ac. 830,639
04-00-003-103-030
SURVEYED BY: MARTINI
C=1:264,739 1.23 ac.
-112
1.47 A.
-114
0.34A
-115
0.40 A
-003 0.50 A.
-030
1.76 A
1.24 A
FRENCH CREEK
SHEFFIELD
REMINDER OF -113
AC. CORR. SURVEY
35.44A
34 A
35.10A
.40A
34.70A
33.10A
1.60A
-116
-113
35.44 A
33.10 A
377.51
79.40
406.54
215.78
100.00
115.78
150.00
150.00
150.00
100.00
60.00
47.95
323.73
900
188.97
429.78
329.98
427.45
390.85
490.70
99.85
116.45
-002
0.10A
251.83
251.25
-072
.71A
-023
0.67A
1782.11
1893.84