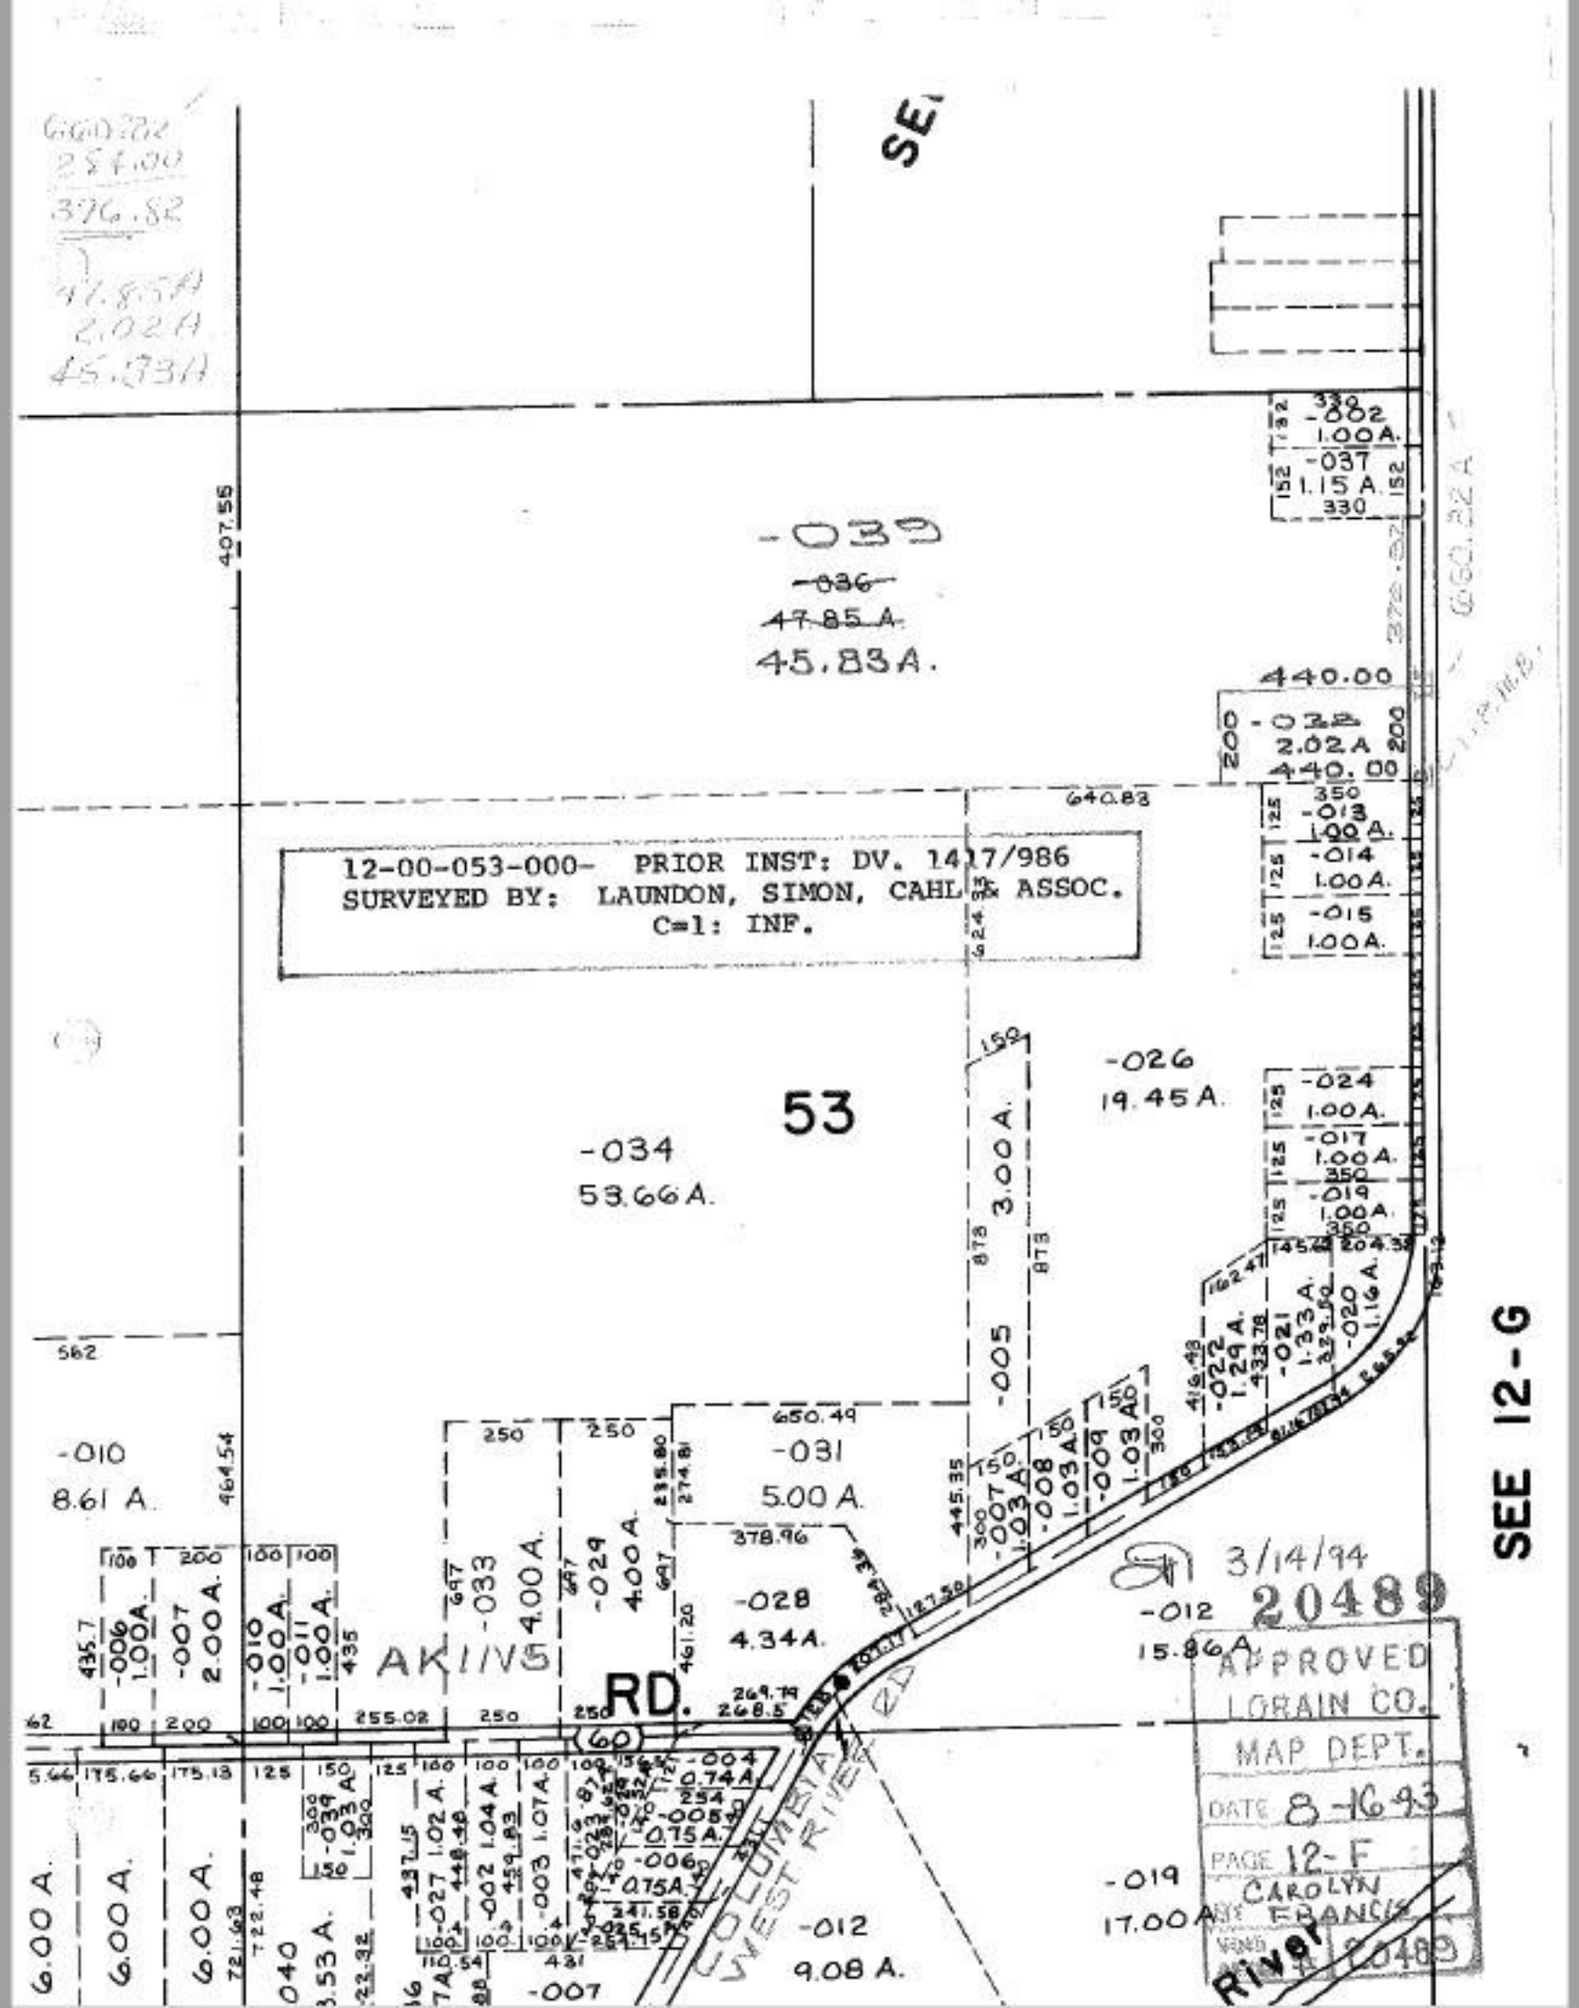
SEE 12-G
-039
~~-036~~
~~47.85 A.~~
45.83A.
12-00-053-000- PRIOR INST: DV. 1417/986
SURVEYED BY: LAUNDON, SIMON, CAHL & ASSOC.
C=1: INF.
53
-034
53.66 A.
-026
19.45 A.
-010
8.61 A.
-031
5.00 A.
-028
4.34A.
-029
4.00 A.
-033
4.00 A.
-012
15.86 A.
-012
9.08 A.
-019
17.00 A.
AKINS RD.
COLUMBIA
WEST RIVER RD
3/14/94
20489
APPROVED
LORAIN CO.
MAP DEPT.
DATE 8-16-93
PAGE 12-F
CAROLYN
BY FRANCIS