

529.47

144.36

212.78

1063.43

ORDINANCE NO. 70-93

AN ORDINANCE CHANGING THE NAME OF MARLBORO ROAD TO NORMANDY DRIVE IN OAKHILL FARMS SUBDIVISION NUMBER TWO IN THE CITY OF LORAIN, OHIO AND DECLARING AN EMERGENCY.

-005
5.09 A.

NO. 8213

(TOWN)

SUB. 5

PG. 4

105

NO. 2

1-009

33-015

2

889.50

900

-001 1.39 A.

RD.

156.28


837.89

NEW NAME:

NORMANDY DR

NAME CHANGE

PER ORD. NO 70-93
PASSED JULY 19, 1993
CITY OF LORAIN

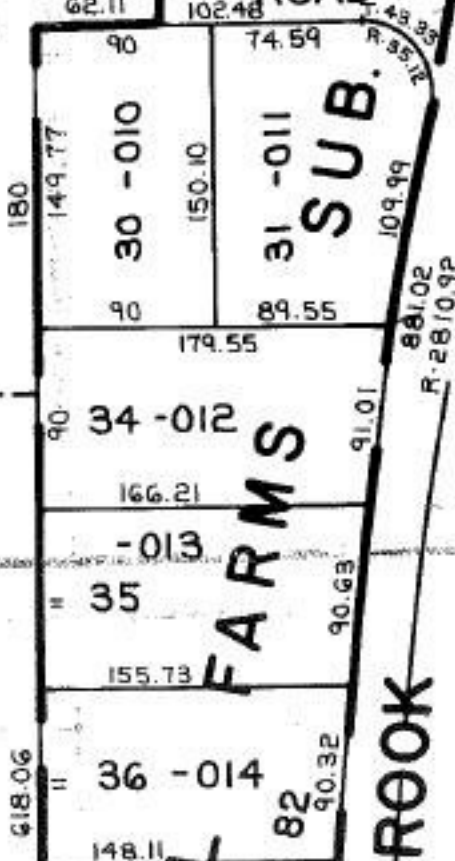

900 -002 0.24 A.

P.P. NO 02-03-006-900-002

STREET NAME CHANGE

9/24/93

20490A

APPROVED
LORAIN CO.
MAP DEPT.

DATE 8-20-93

PAGE 2-03-006A

CAROLYN
BY FRANCIS

VOID
MASTER # 20490A

2-03-006-B