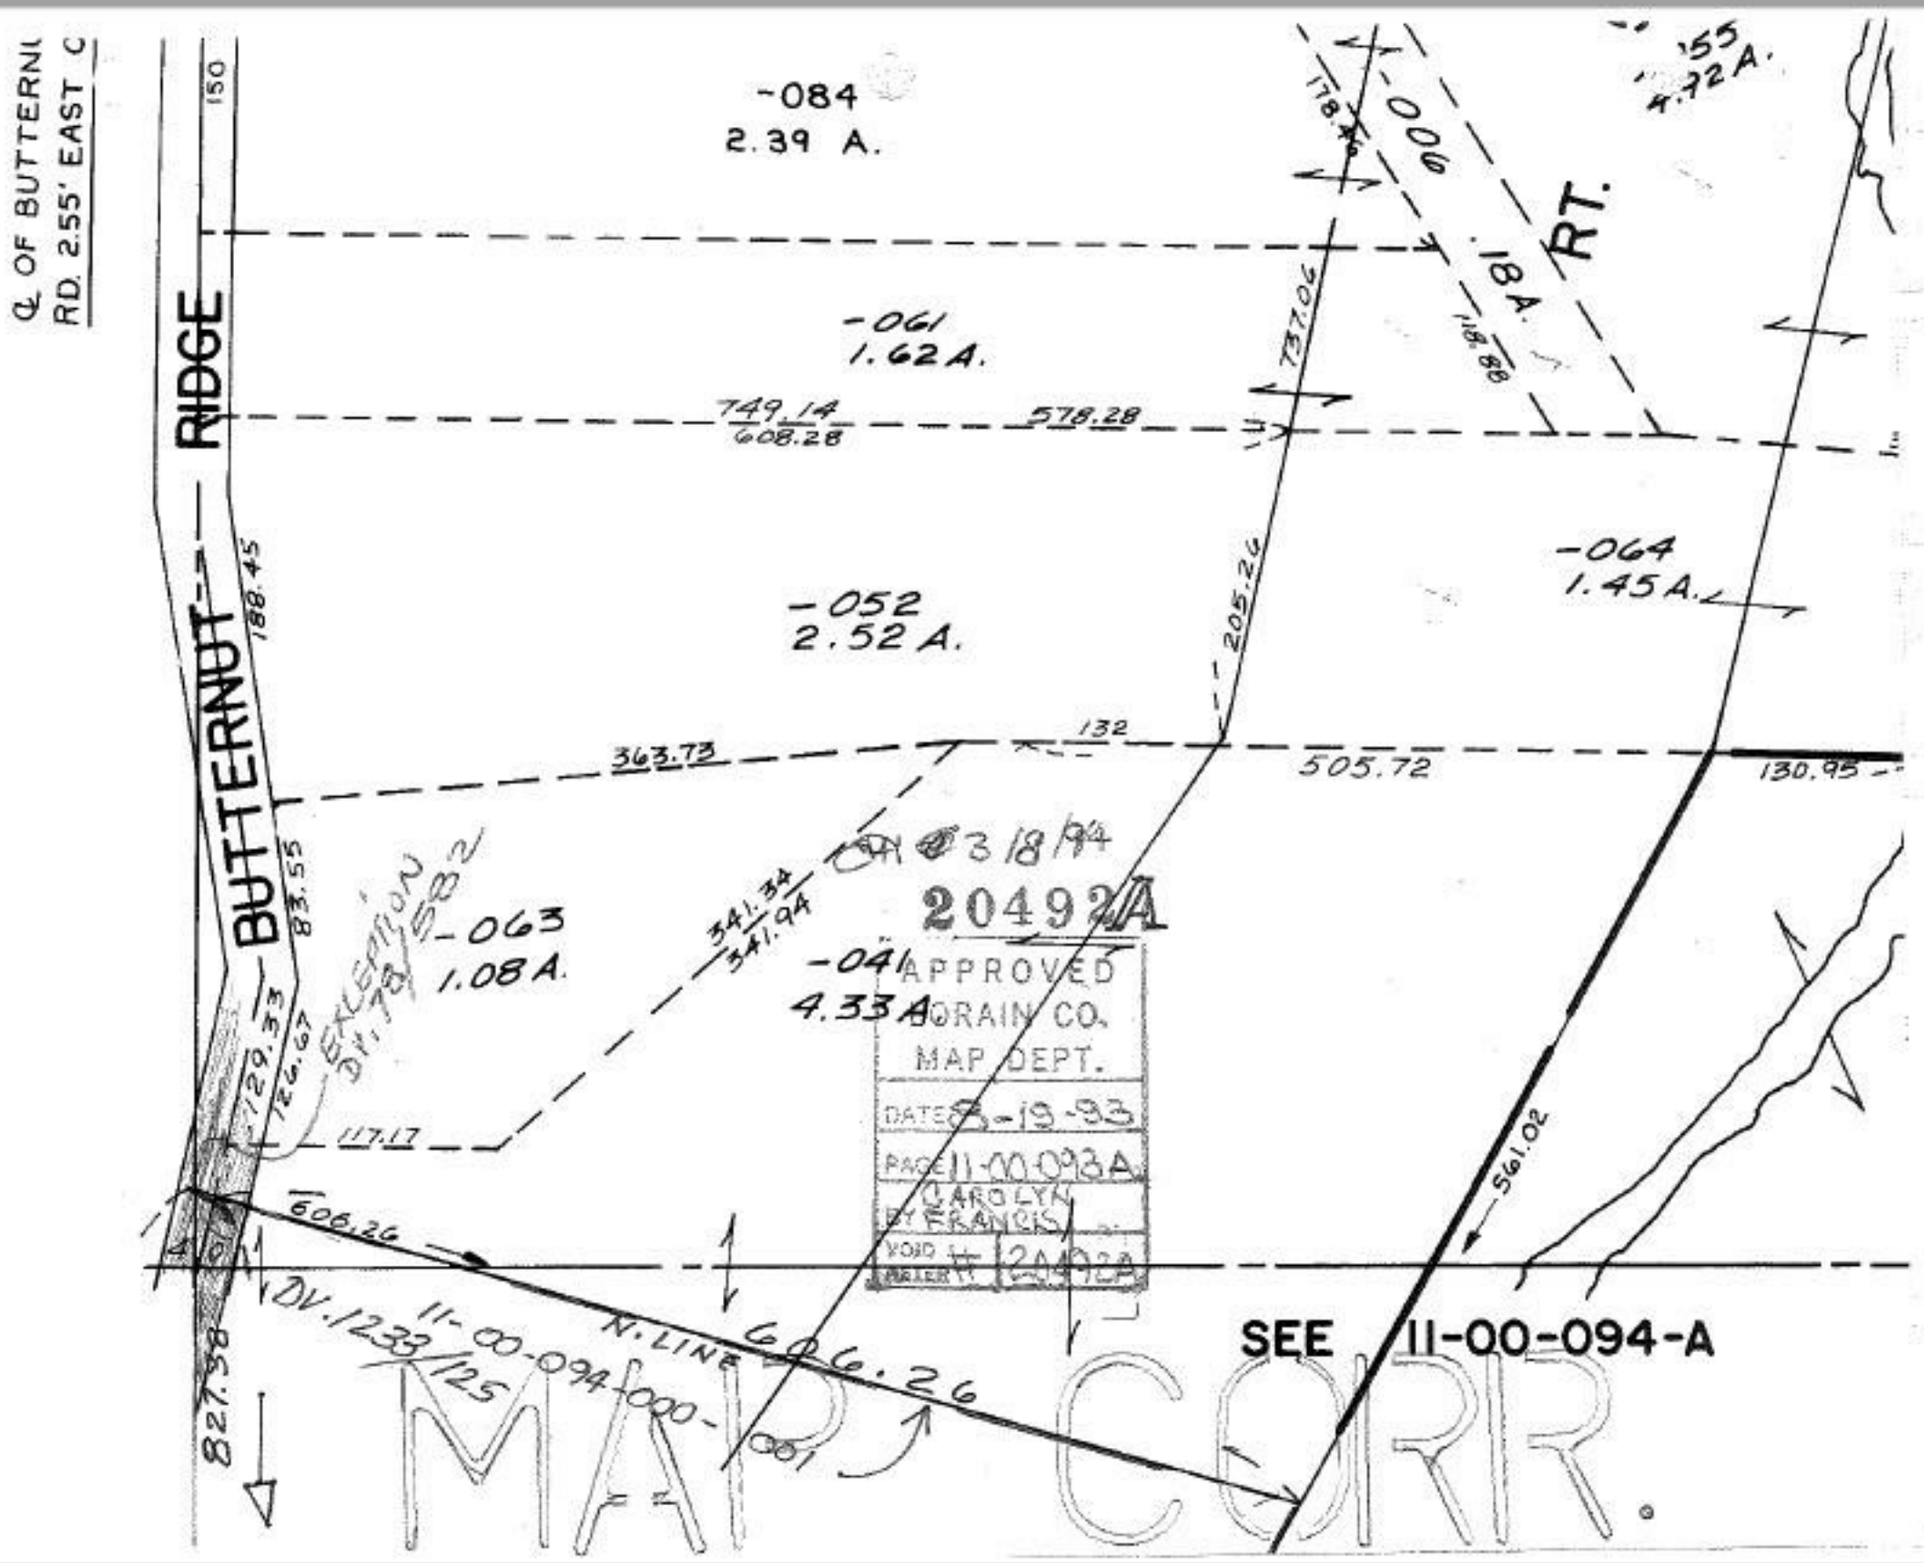

℄ OF BUTTERNUT RD. 2.55' EAST C
BUTTERNUT RIDGE
-084
2.39 A.
-061
1.62 A.
-052
2.52 A.
-063
1.08 A.
-041
4.33 A.
-064
1.45 A.
-006
.18 A.
RT.
749.14
608.28
578.28
737.06
118.88
205.26
363.73
132
505.72
130.95
341.34
341.94
188.45
83.55
129.33
126.67
117.17
606.26
561.02
827.38
EXCEPTION DV. 78/582
DV. 1233/125
11-00-094-000-001
N. LINE
606.26
SEE 11-00-094-A
MAP CORR.
20492A
APPROVED
LORAIN CO.
MAP DEPT.
DATE 8-19-93
PAGE 11-00-093A
BY CAROLYN FRANCIS
VOID