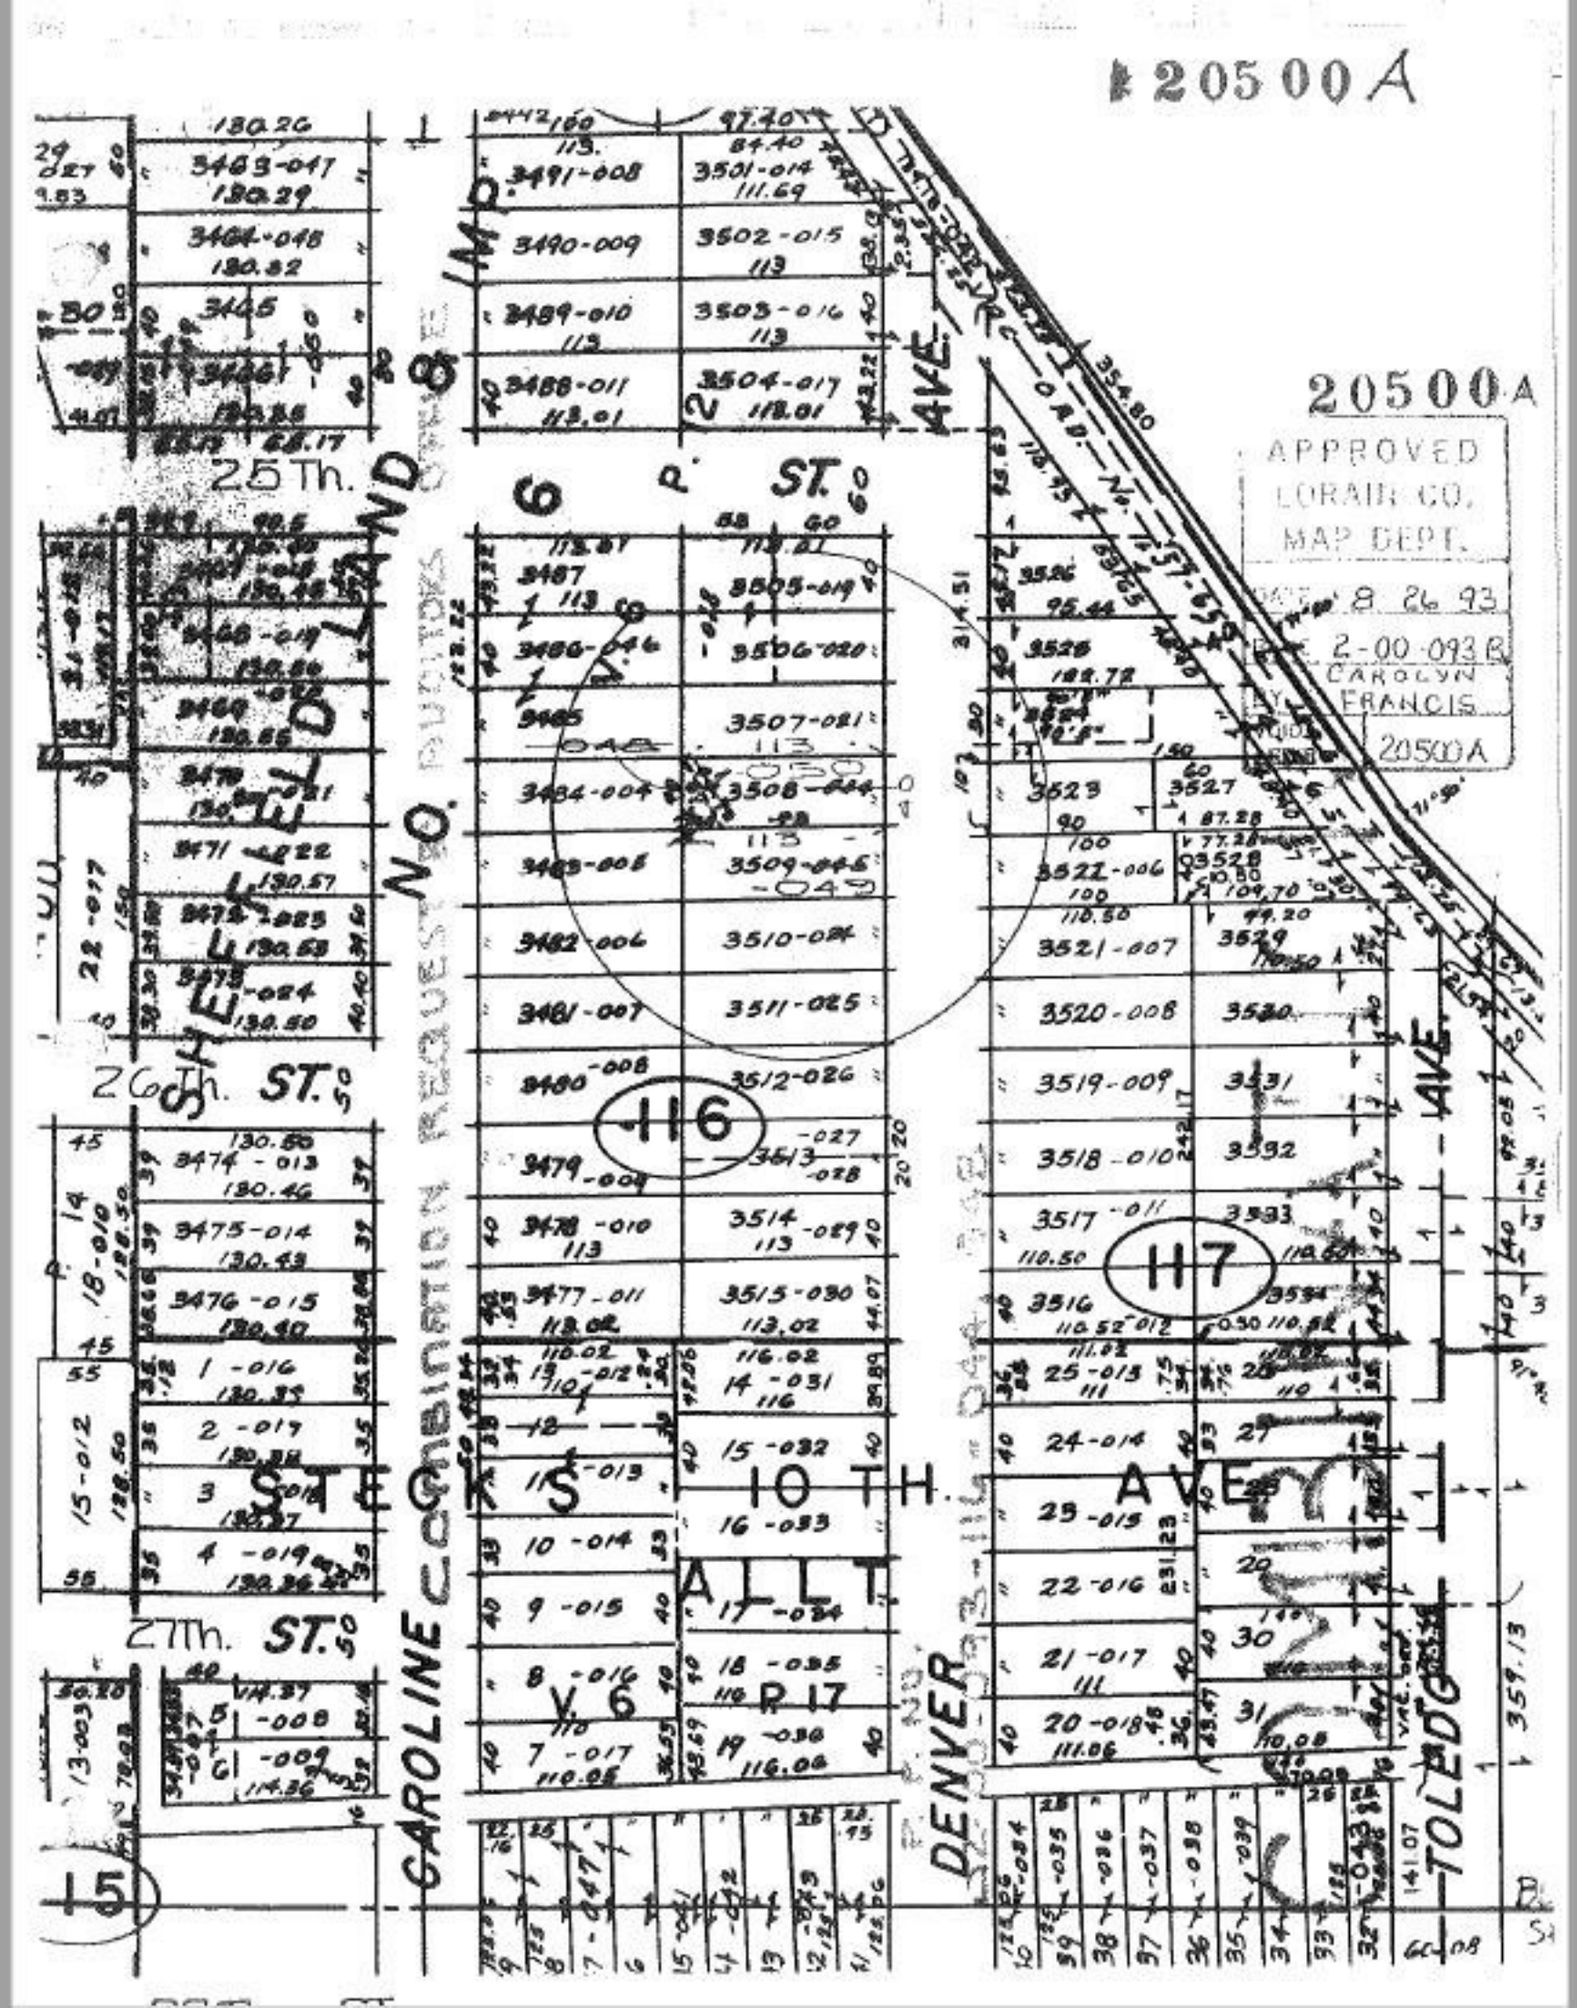
20500A
20500A
APPROVED
LORAIN CO.
MAP DEPT.
DATE 8 26 93
2-00-093 B
CAROLYN
FRANCIS
20500A
25Th.
26Th. ST.
27Th. ST.
SHEFFIELD LAND & IMP.
NO. 6
P. 2
ST.
CAROLINE
STECK'S
10 TH. AVE
ALLT.
DENVER
TOLEDO
AVE.
116
117
15