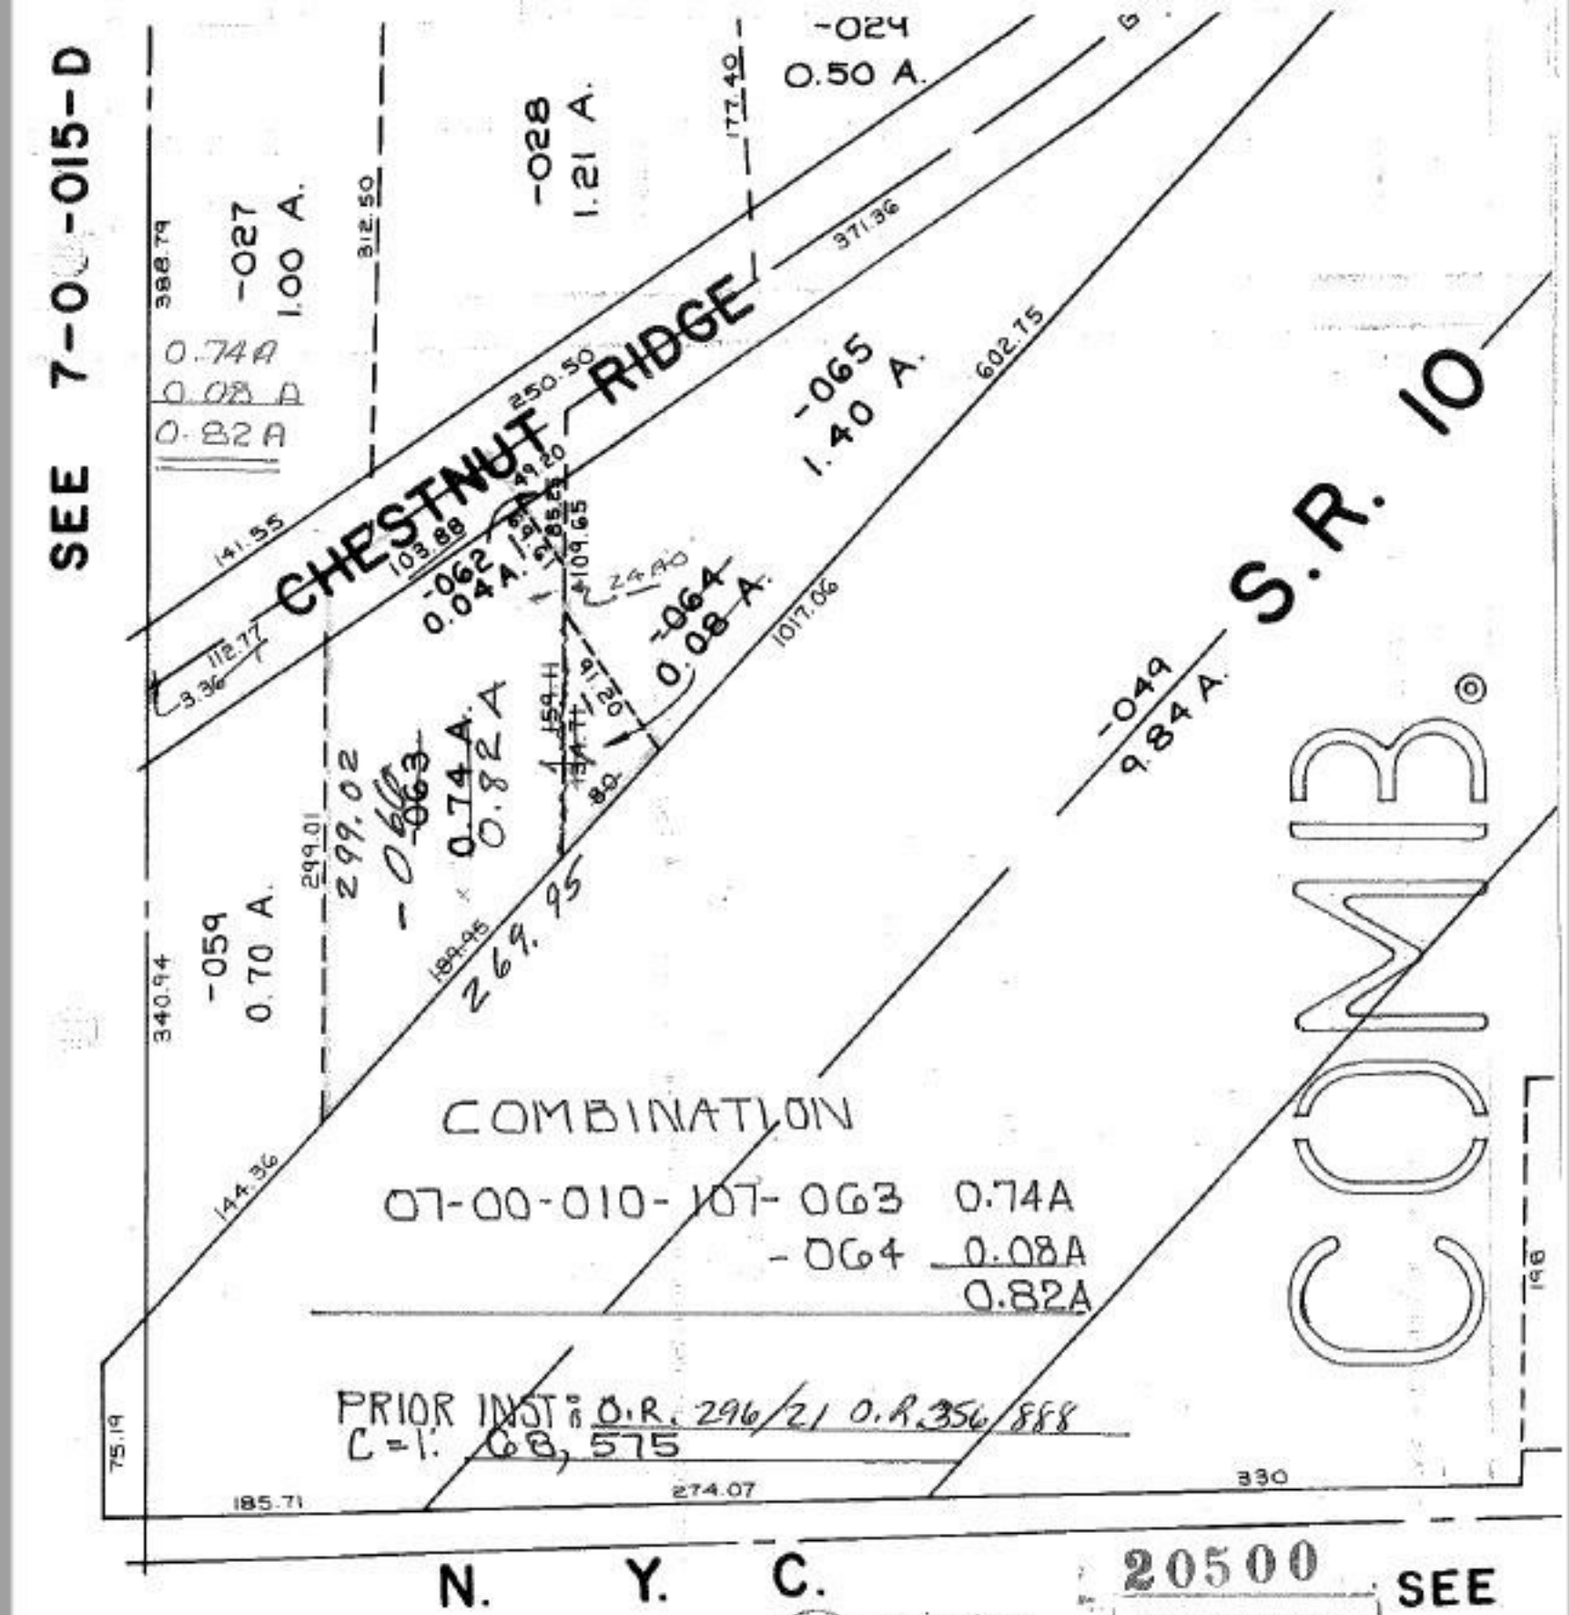

20500

SH 2/8/94

APPROVED
LORAIN CO.
MAP DEPT.
DATE 8-20-93
PAGE 7-00-010-C
BY CAROLYN FRANCIS
VOID AFTER # 20500