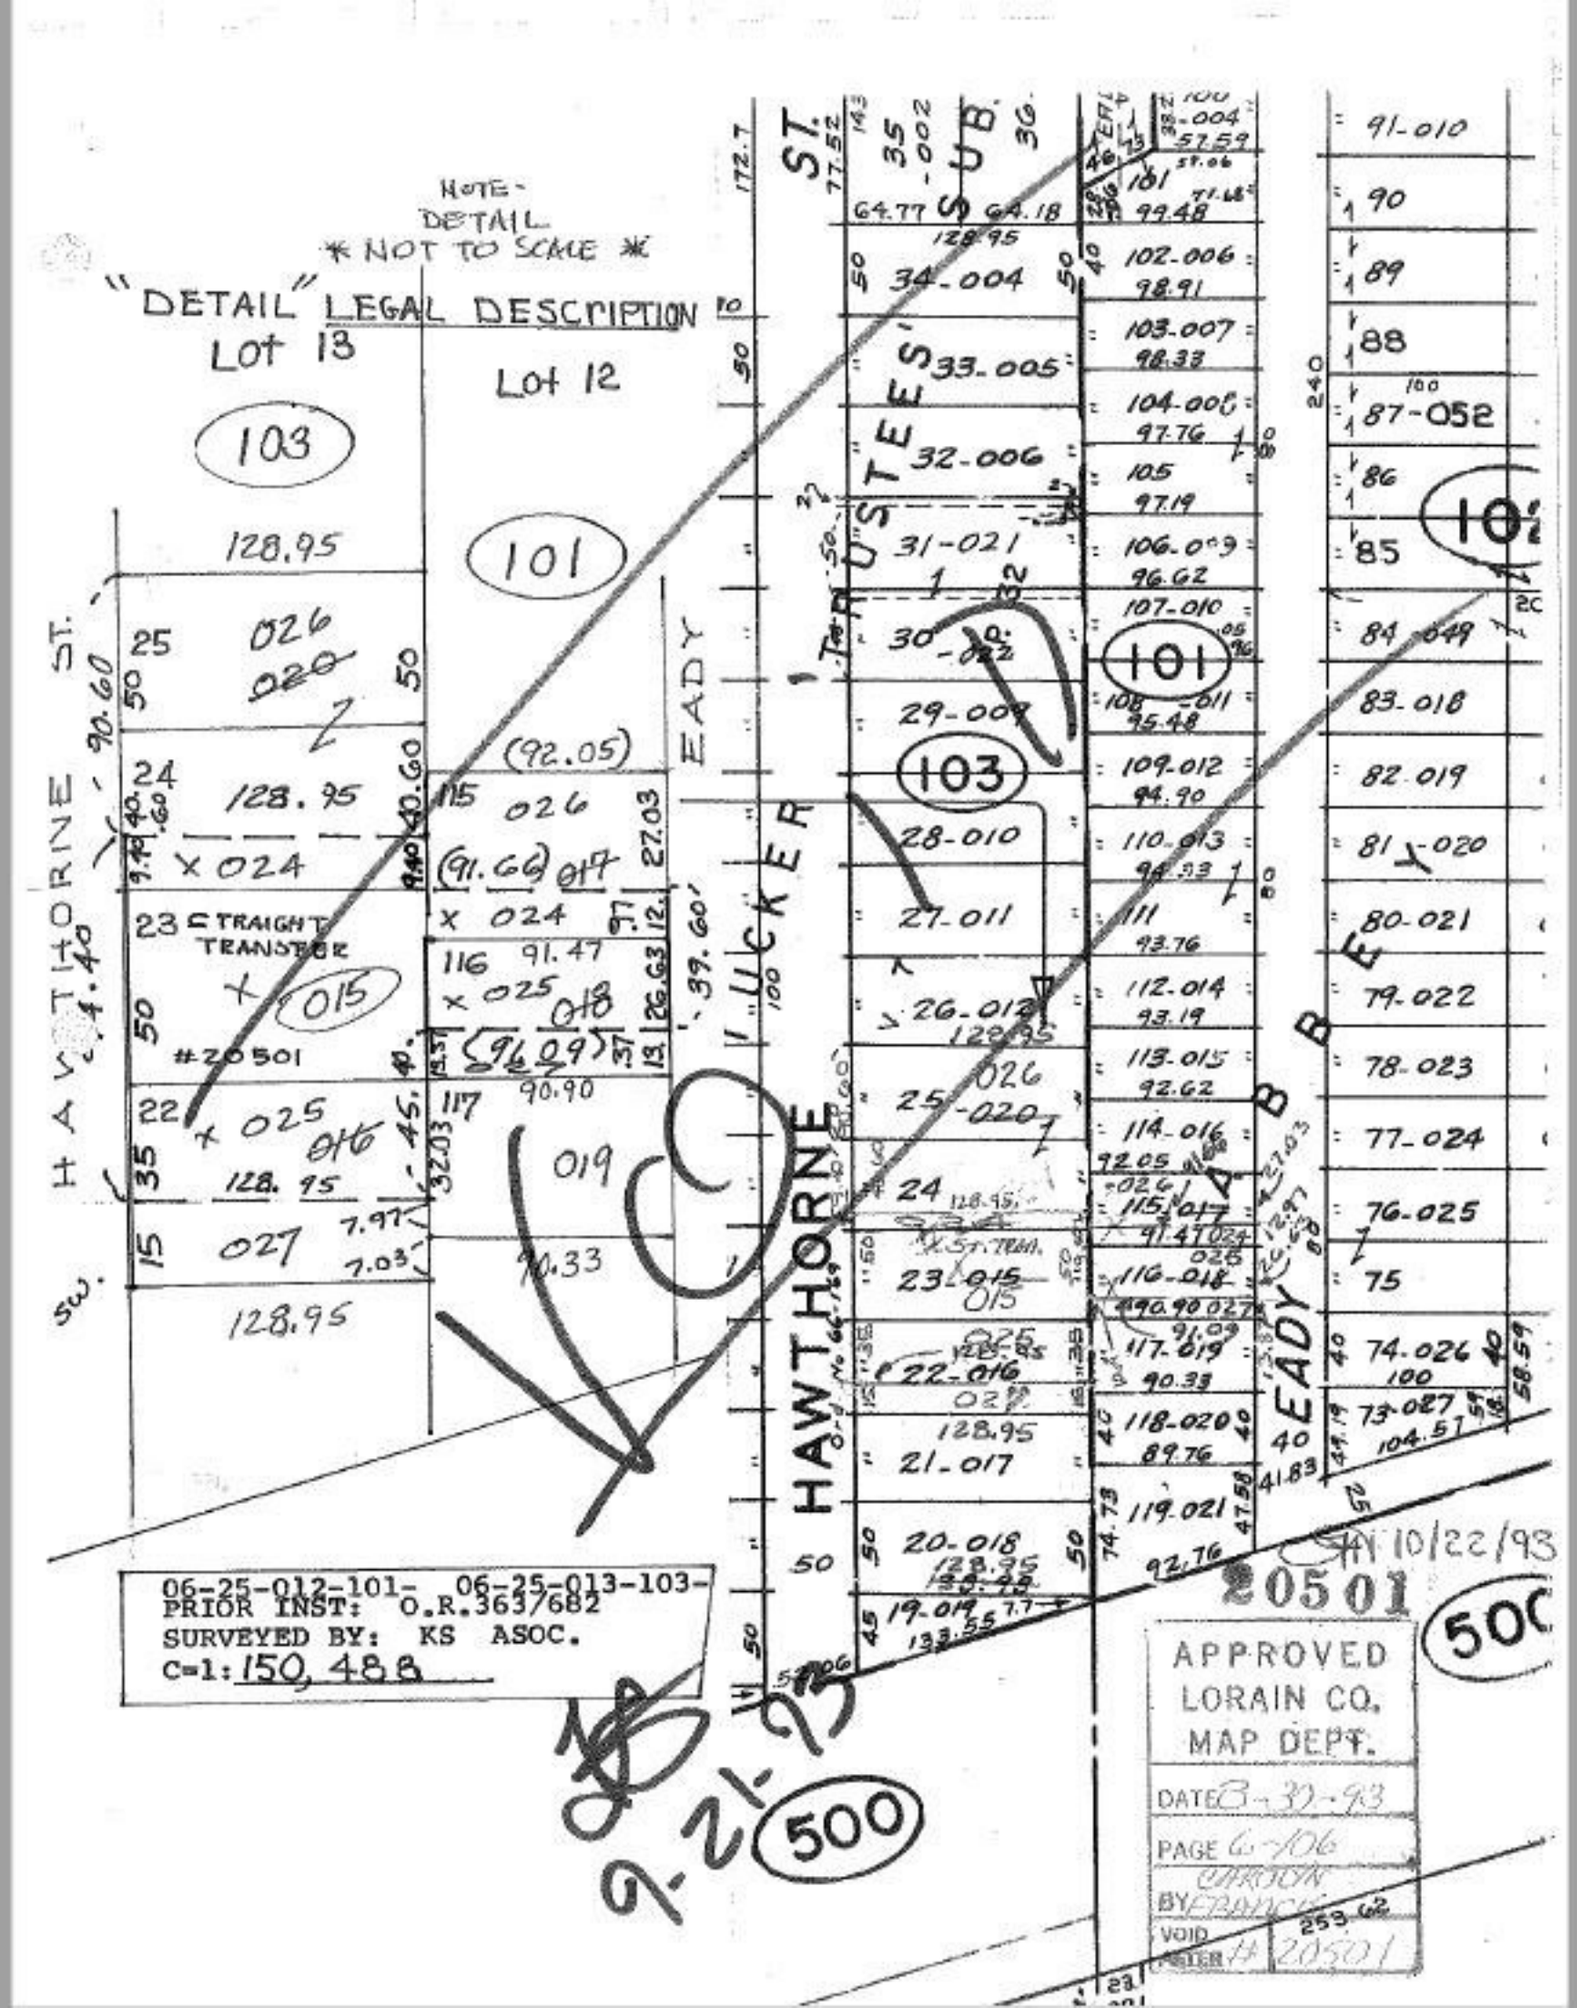
NOTE-
DETAIL
* NOT TO SCALE *
"DETAIL" LEGAL DESCRIPTION
Lot 13
Lot 12
103
101
HAWTHORNE ST.
EADY
TRUSTEES' SUB.
HAWTHORNE
EADY
#20501
STRAIGHT TRANSFER
06-25-012-101- 06-25-013-103-
PRIOR INST: O.R.363/682
SURVEYED BY: KS ASOC.
C=1: 150,488
9-21-93
500
10/22/93
20501
APPROVED
LORAIN CO.
MAP DEPT.
DATE 8-30-93
PAGE 6-106
BY CAROLYN FRANCIS
VOID
PATER # 20501