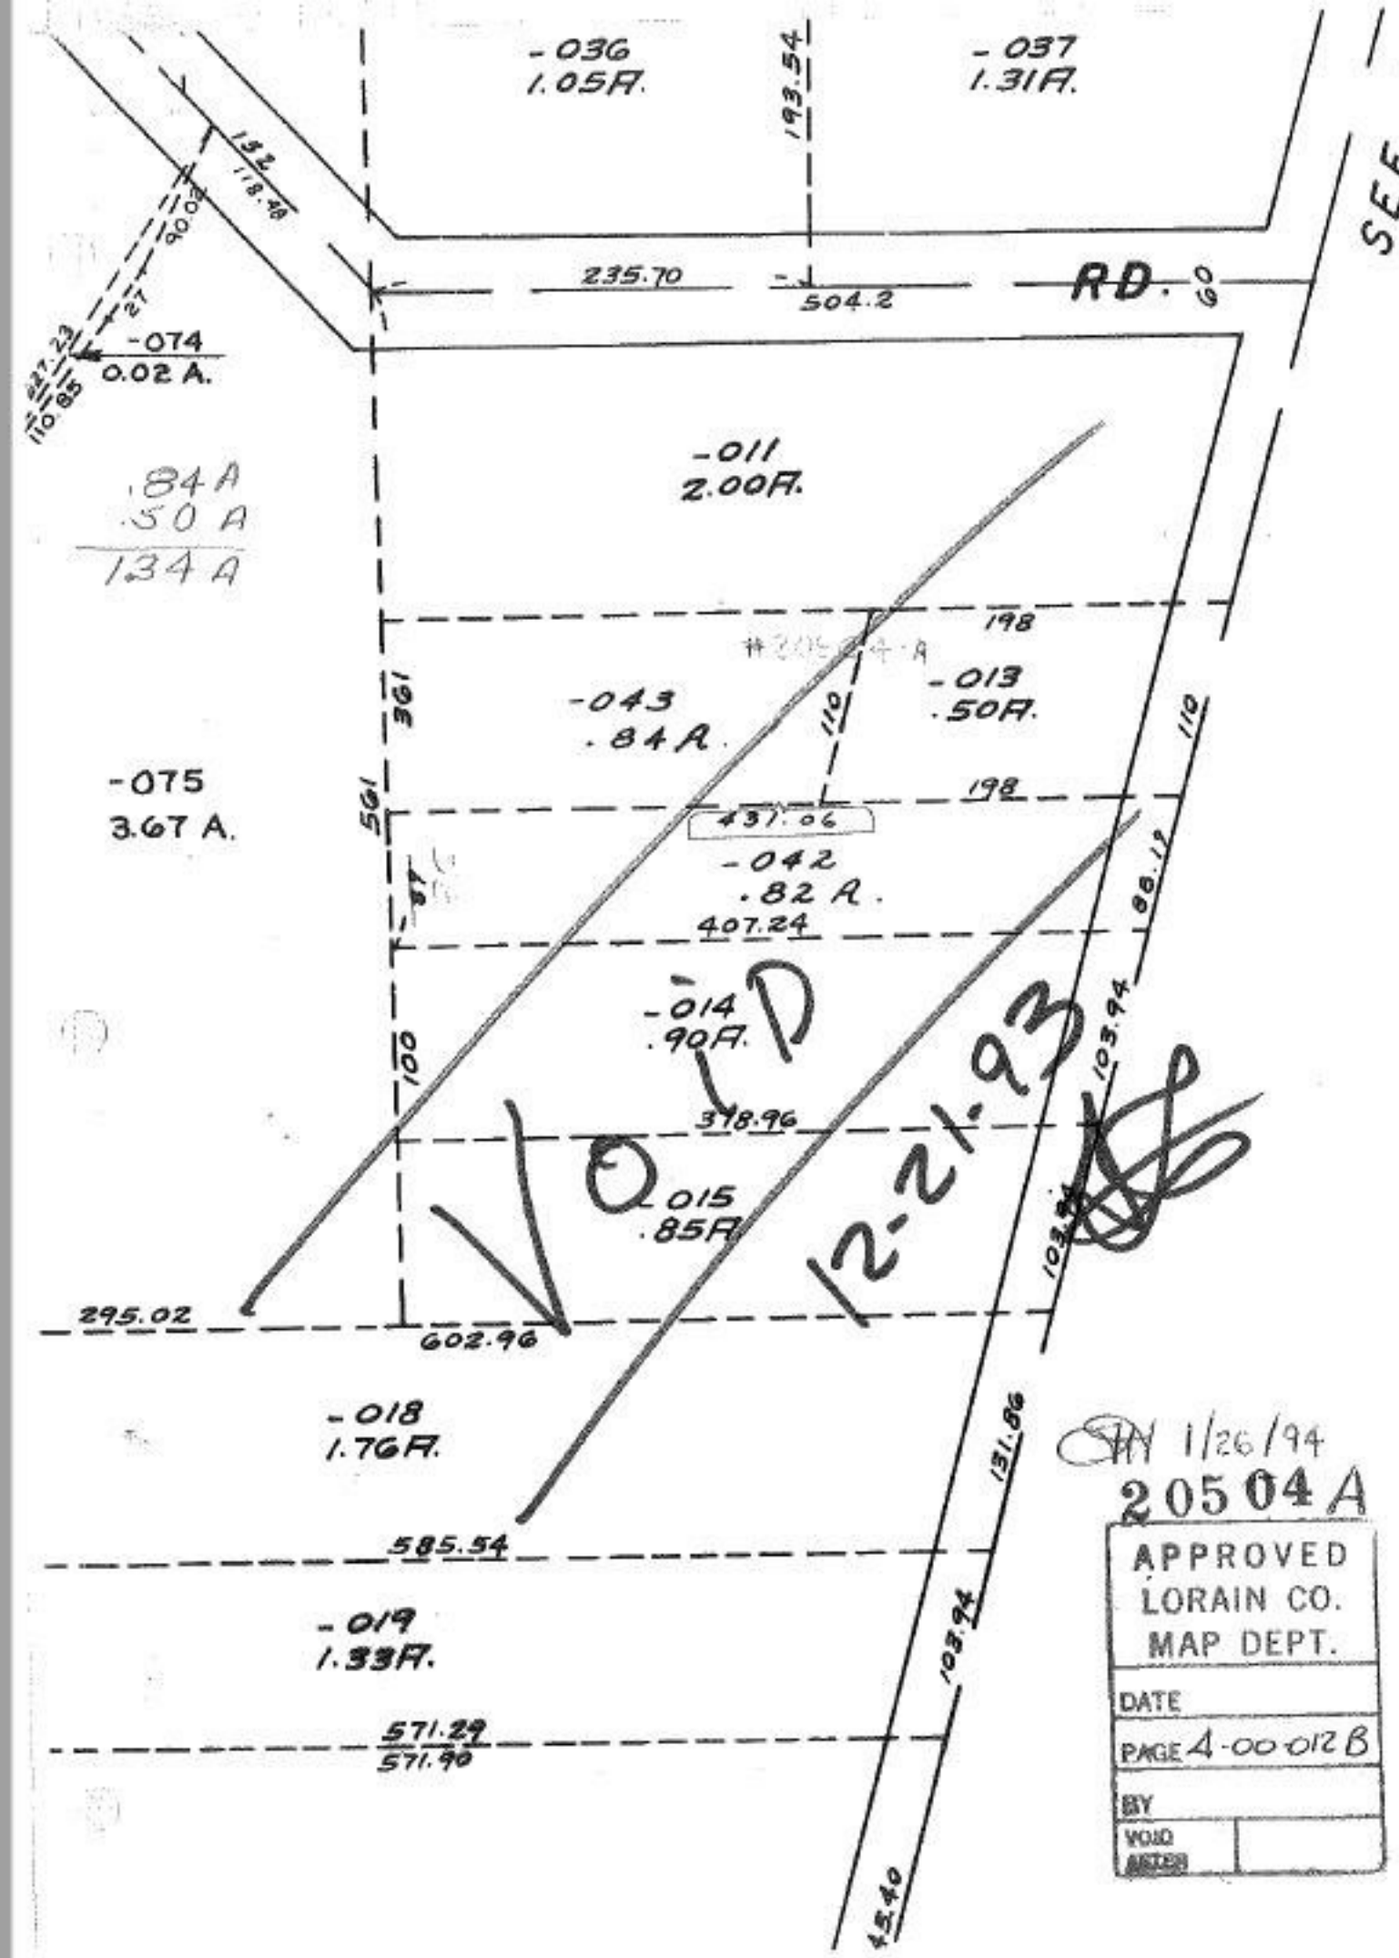

SHY 1/26/94

20504 A

APPROVED
LORAIN CO.
MAP DEPT.

DATE

PAGE 4-00-012 B

BY

VOID
AFTER