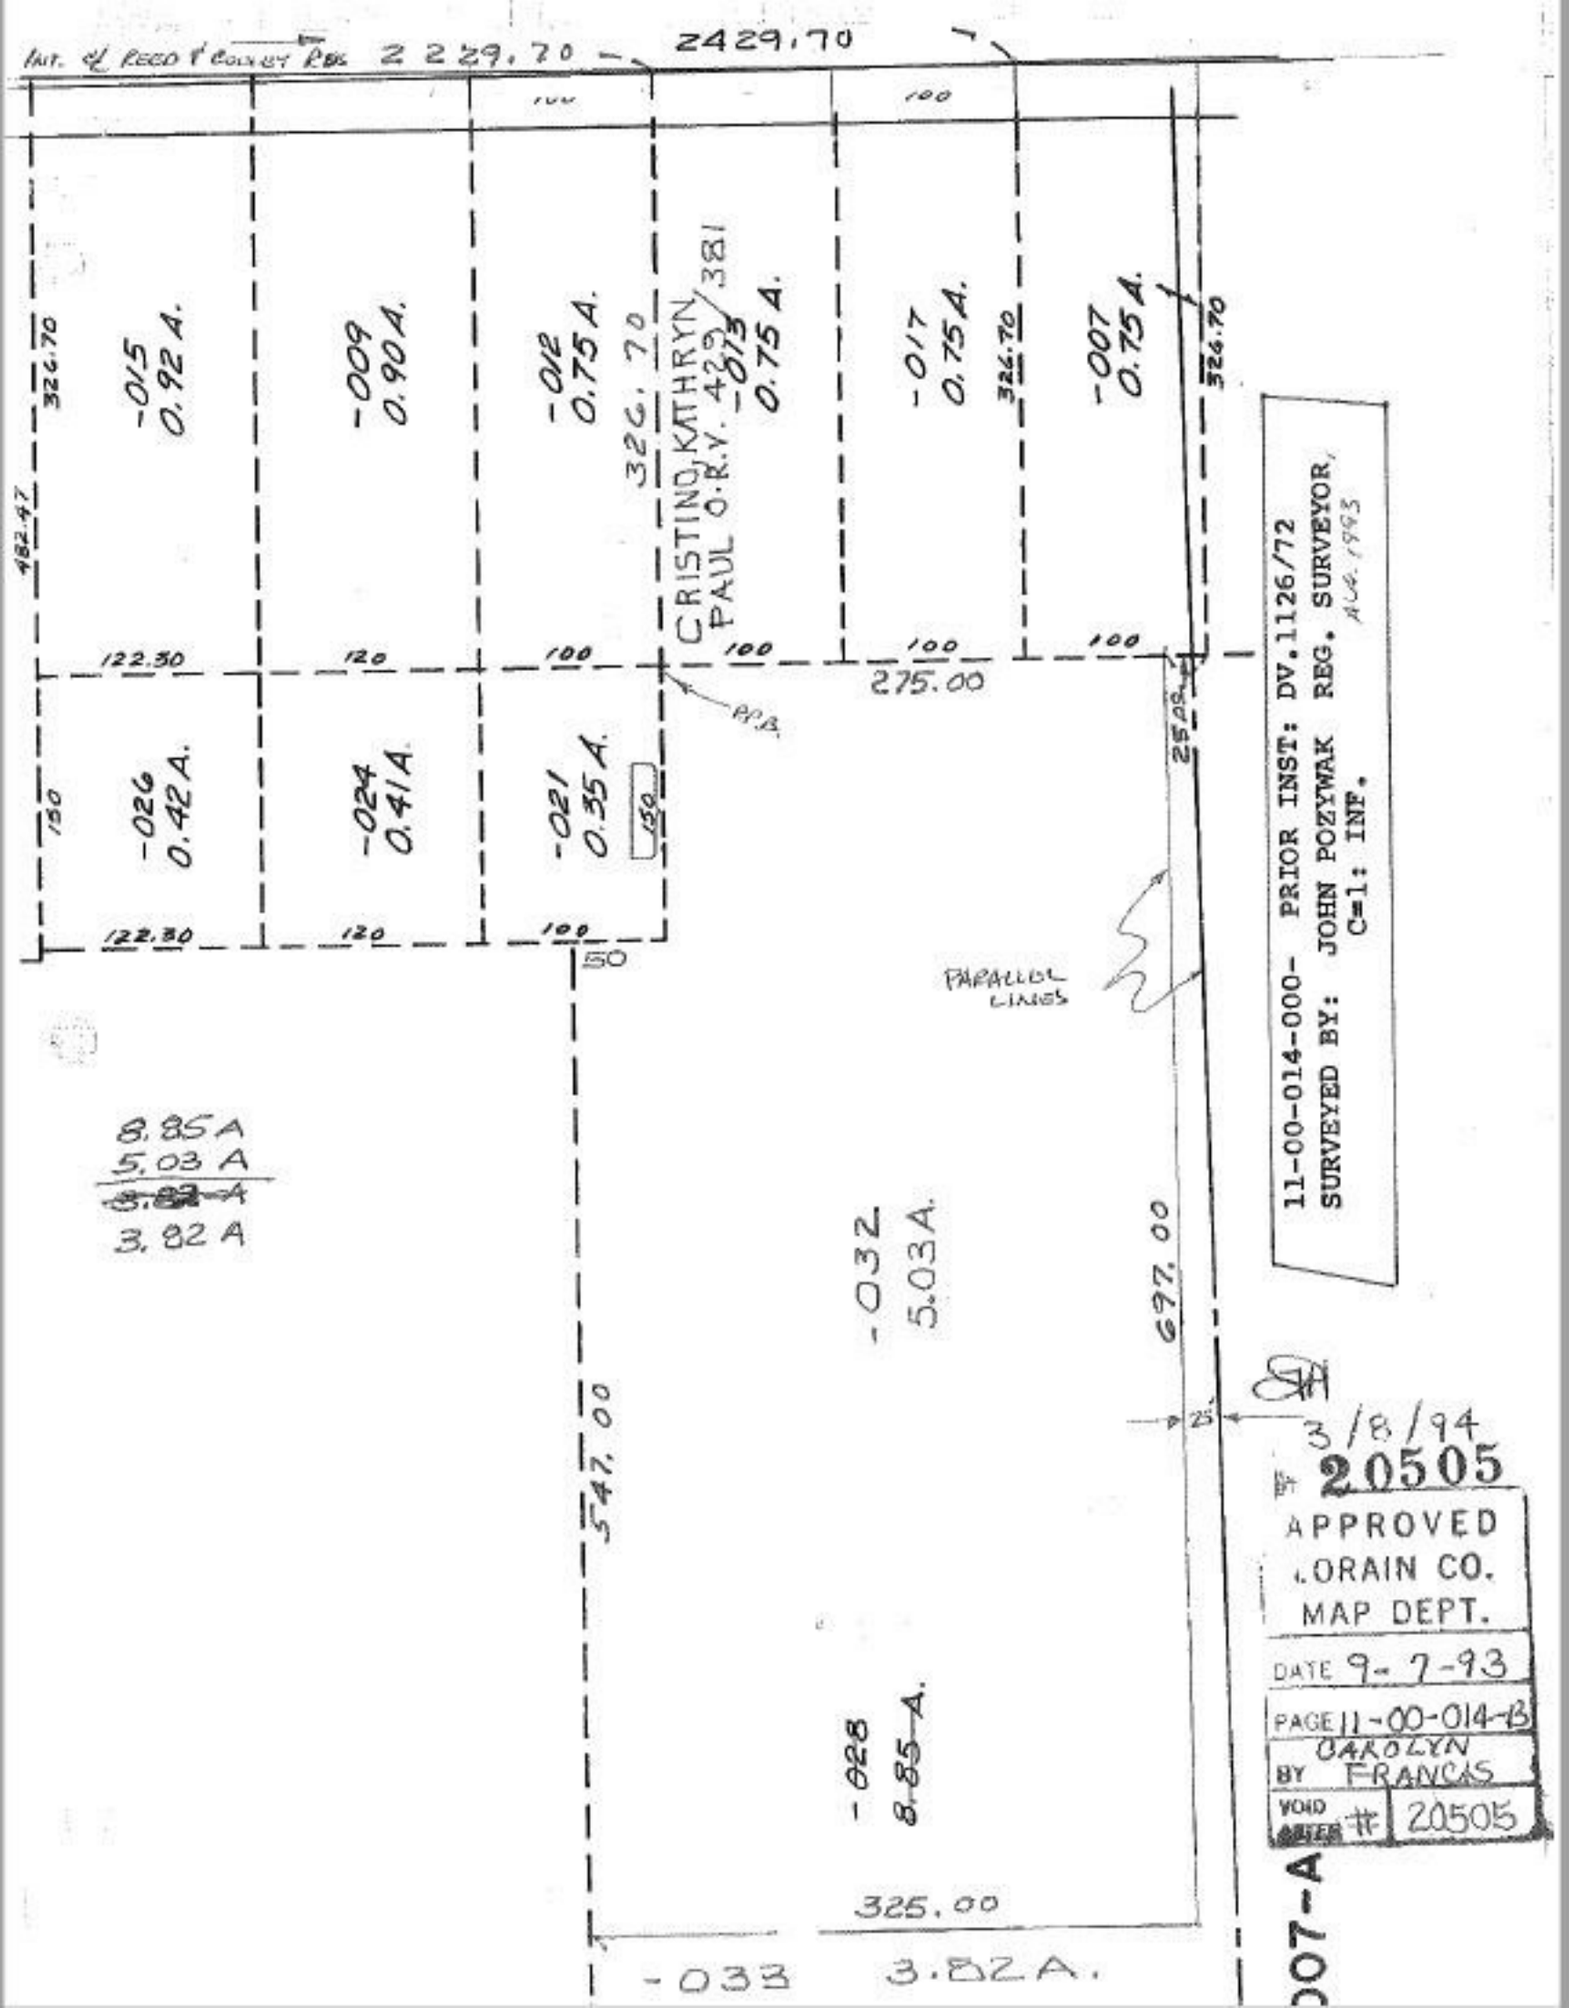

11-00-014-000- PRIOR INST: DV.1126/72
SURVEYED BY: JOHN POZYWAK REG. SURVEYOR,
C=1: INF.
AUG. 1993

3/8/94
20505
APPROVED
LORAIN CO.
MAP DEPT.
DATE 9-7-93
PAGE 11-00-014-B
BY CAROLYN FRANCIS
VOID AFTER # 20505

007-A