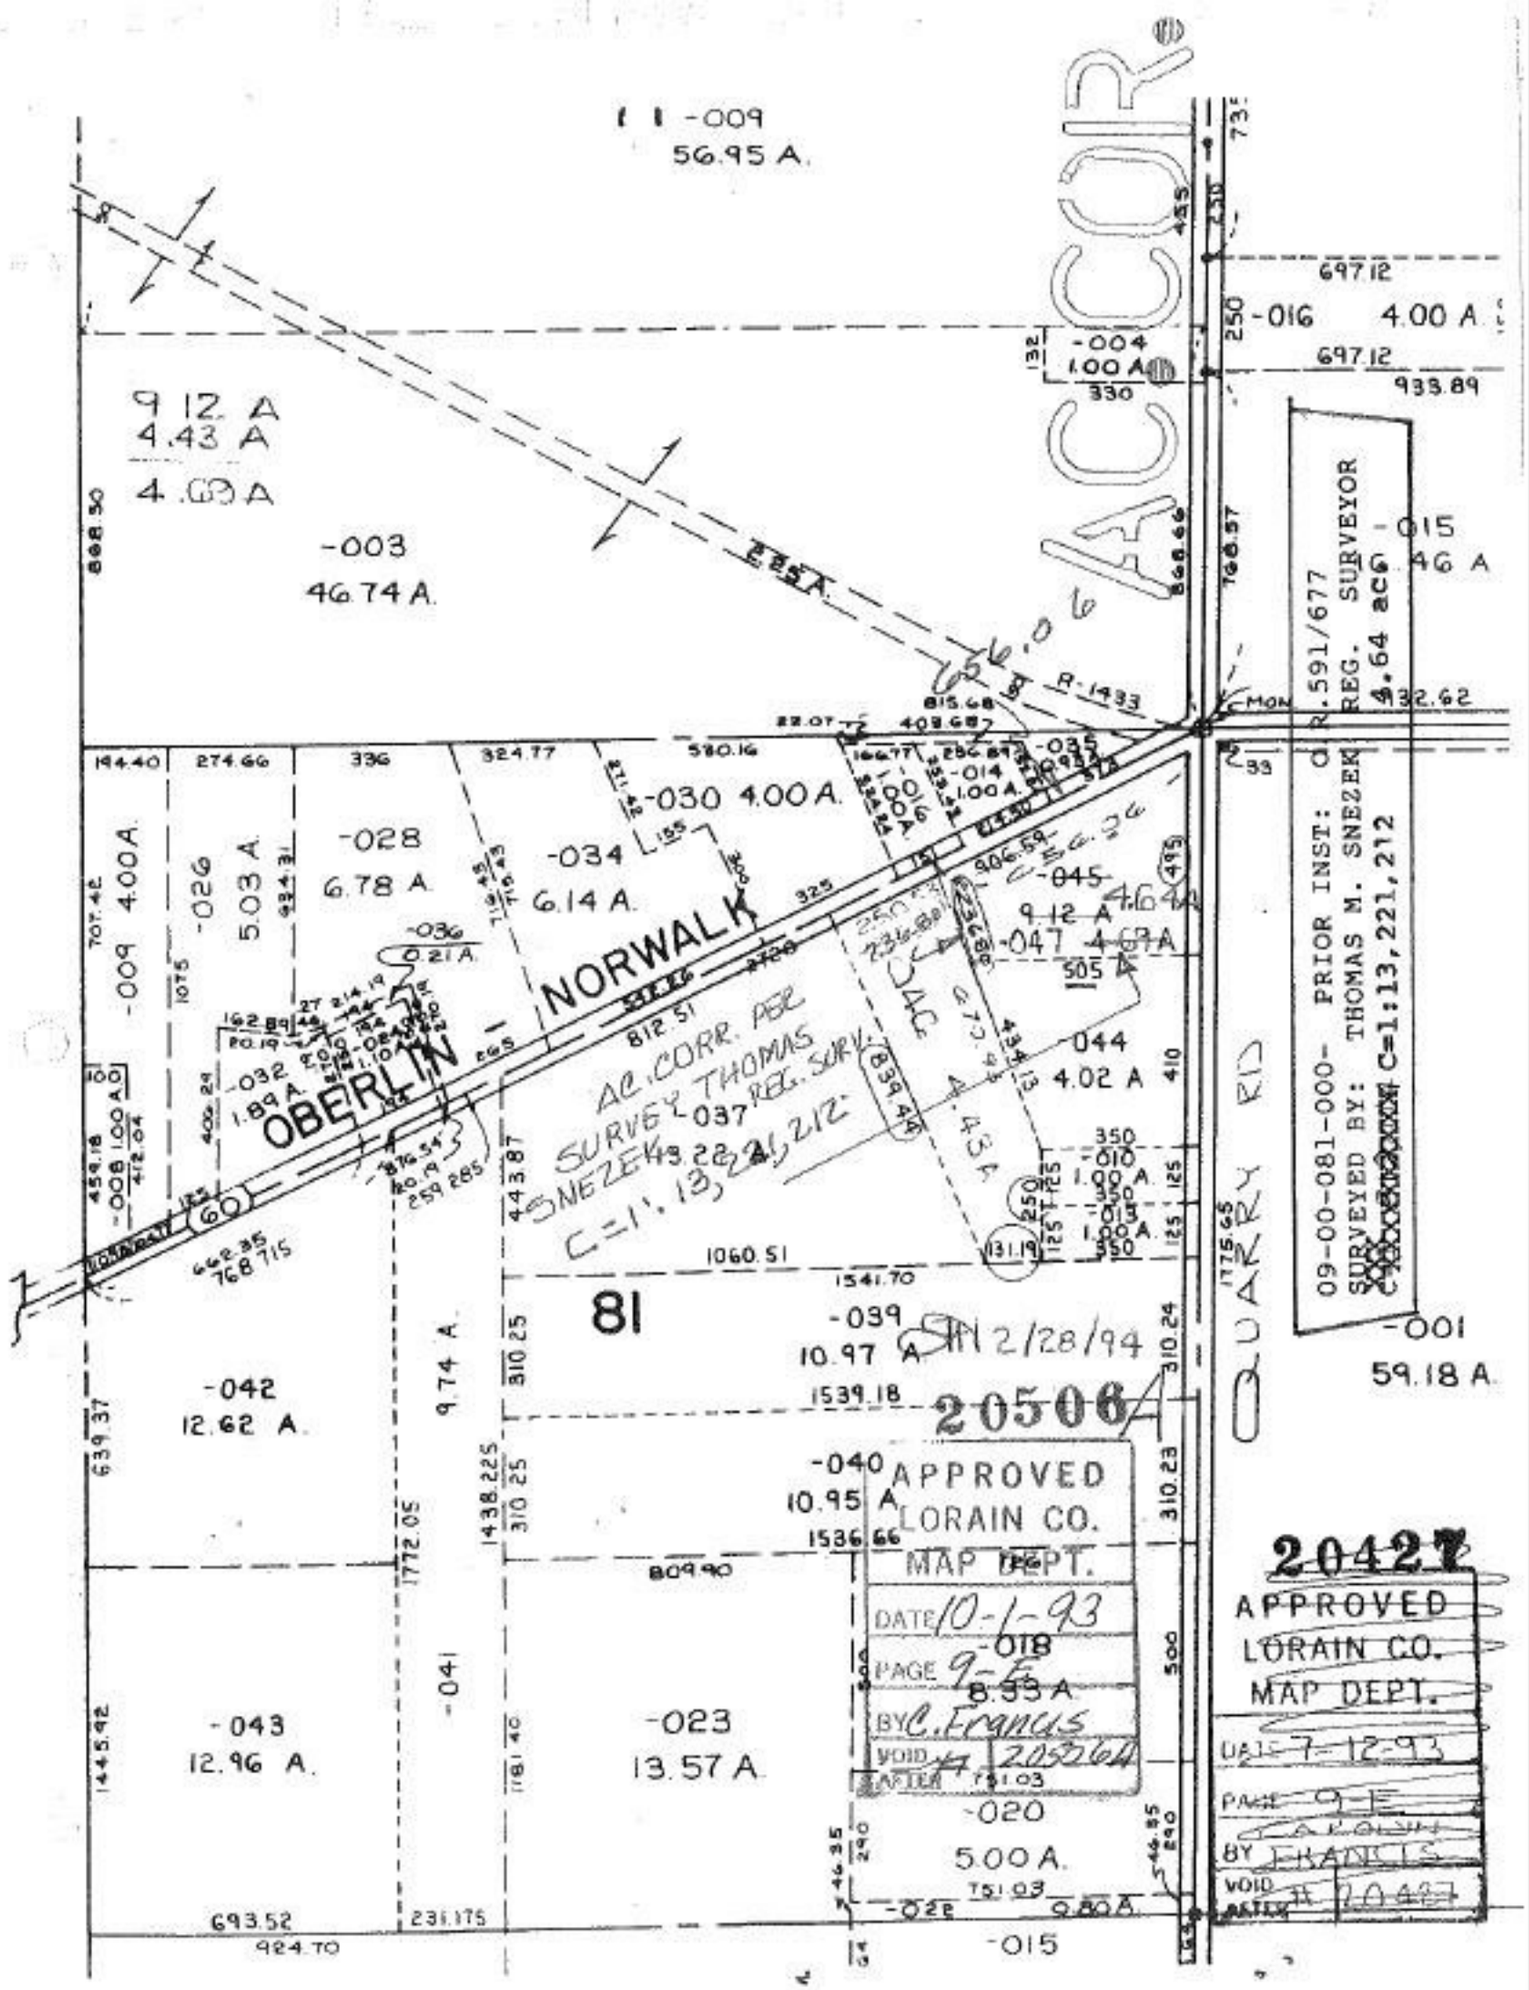

09-00-081-000- PRIOR INST: O.R. 591/677
SURVEYED BY: THOMAS M. SNEZEK REG. SURVEYOR
C=1:13,221,212