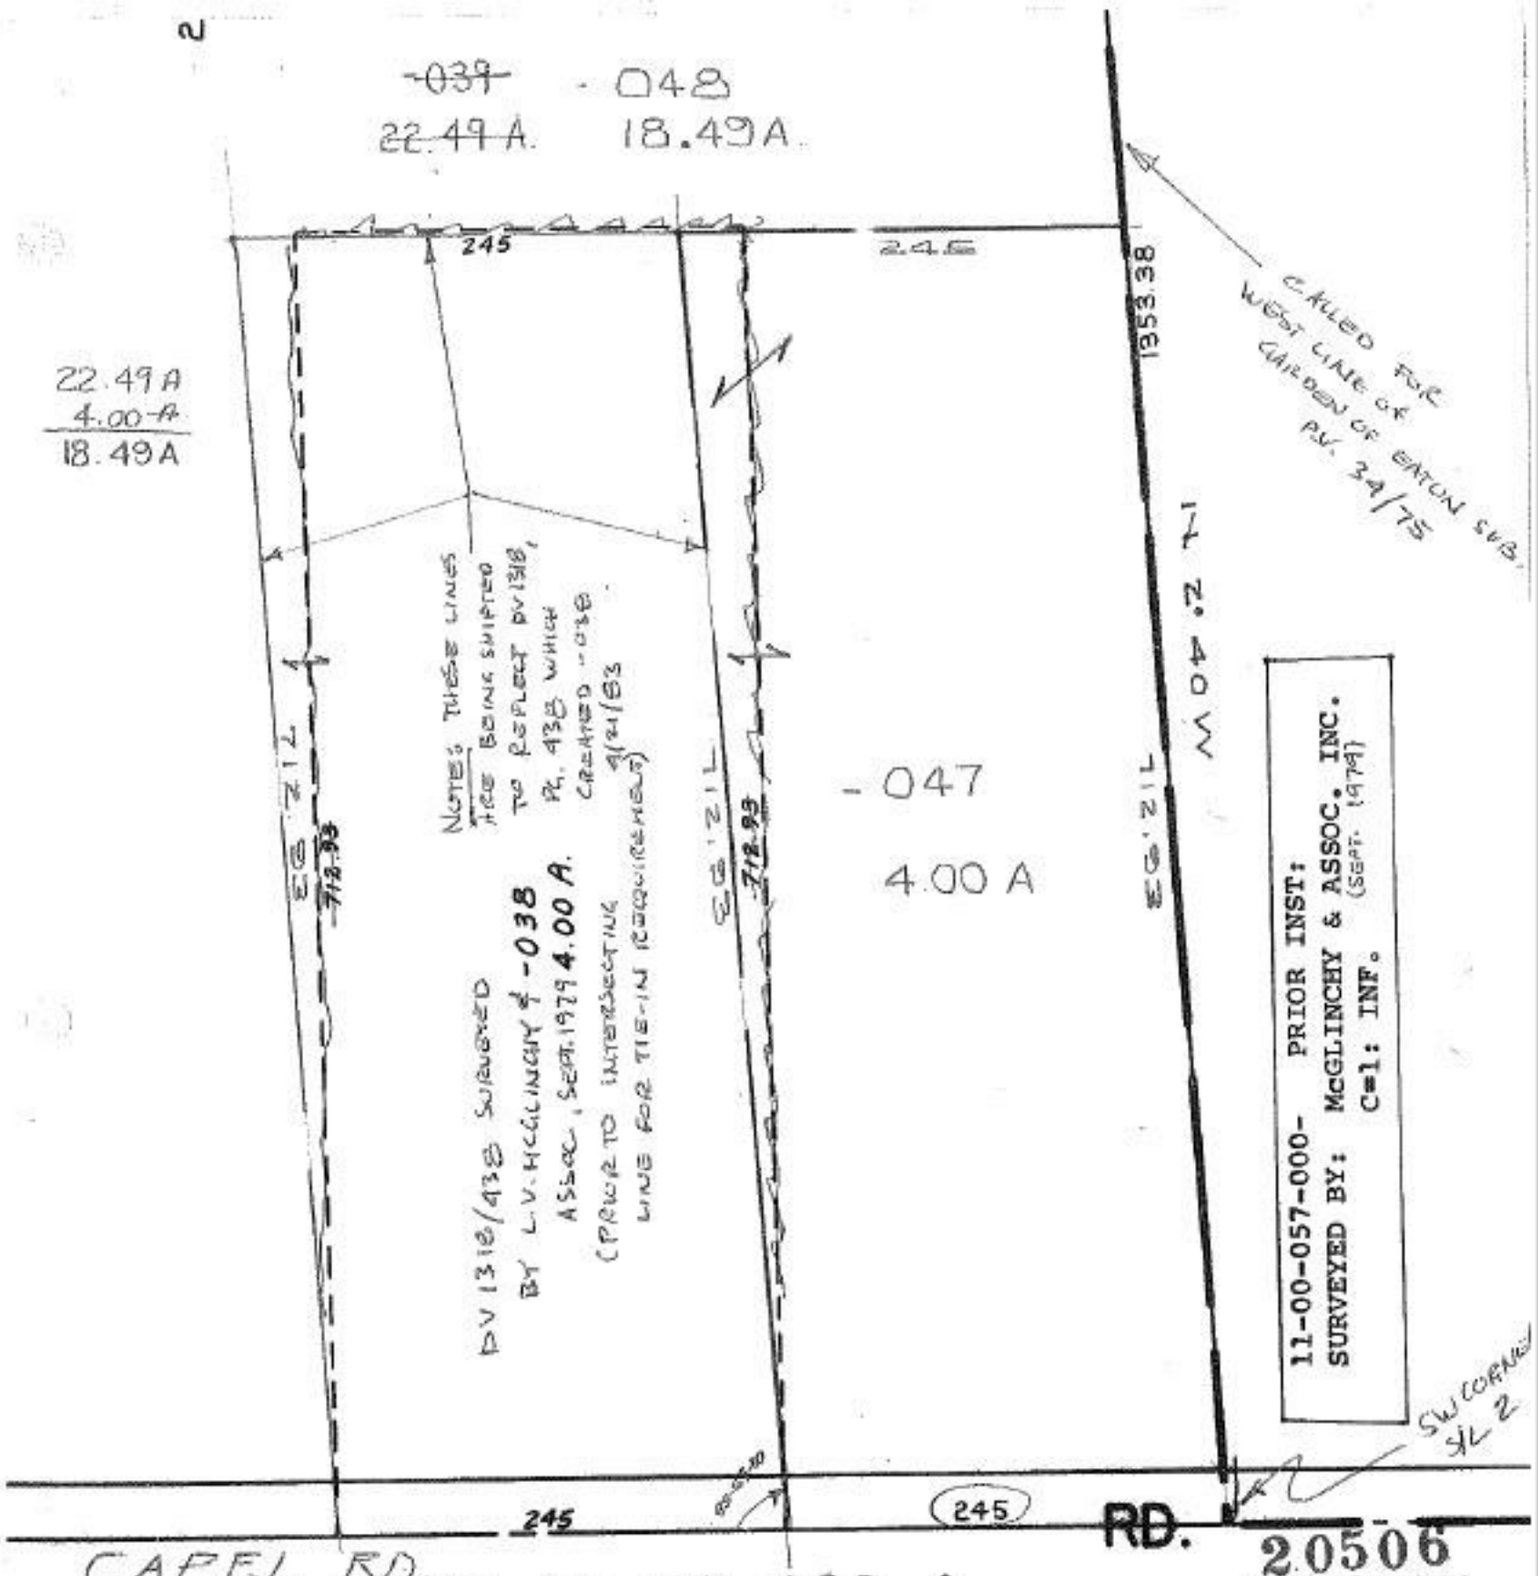

SEE 11-00-058-A

3/8/94

20506

APPROVED
LORAIN CO.
MAP DEPT.
DATE 9-9-93
PAGE 11-00-057A
BY CAROLYN FRANCIS
VOID AFTER # 20506