

713
1.17A

569.50

P-1

PARCELS 11) NEEDS
MORE INFO
PARCELS DESCRIBES
P.P. NO'S

SLOT.	P.P. NO.	SUBDIVISION
1	015	
3	017	
4	018	
6	020	
7	021-014	(12)
8	022	B. A.
9	023	
10	024	
11	025	
12	026	

NEED AC. BREAK DOWN
HOW MUCH AC. IN SUBLLOT AND
HOW MUCH IN AC. PARCEL

ANCES IN R/W OF ST. RT. 58
EASEMENT OR BY DEED?

8-022
9-023
10-024

NORTH GATE
V. 17

SEE 5-C


20507.

APPROVED
LORAIN CO.
MAP DEPT.
DATE AUG-30-93
PAGE
BY CAROLYN FRANCIS
VOID AFTER # 20507A

500

NORTH LINE
N. Y. C. R. R.
OF 581-78

84.673 (12-10-84)
17.26 (84)

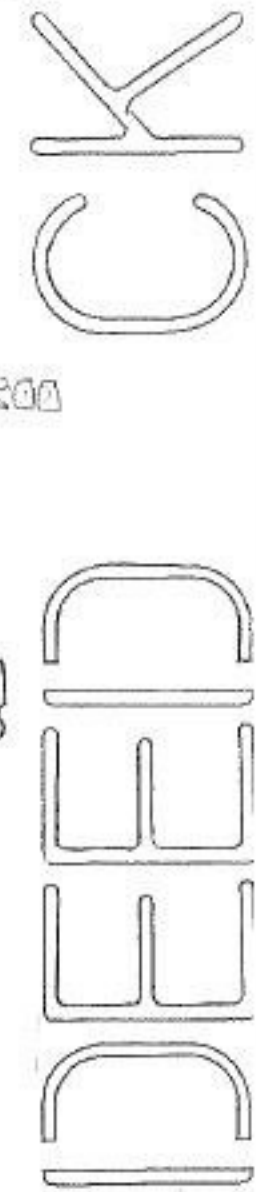

60.45

200

58

59397

100

754.11

890.12

110

180

90

90

90

90

90

90

90

90

90

90

90

90

90

90

90

90

90

90

90

70

70

8-022

9-023

10-024

120.11

78.64

120

120

160

150

70

190

190

190

190

190

190

190

190

190

190

190

190

190

190

190

190

120

120

