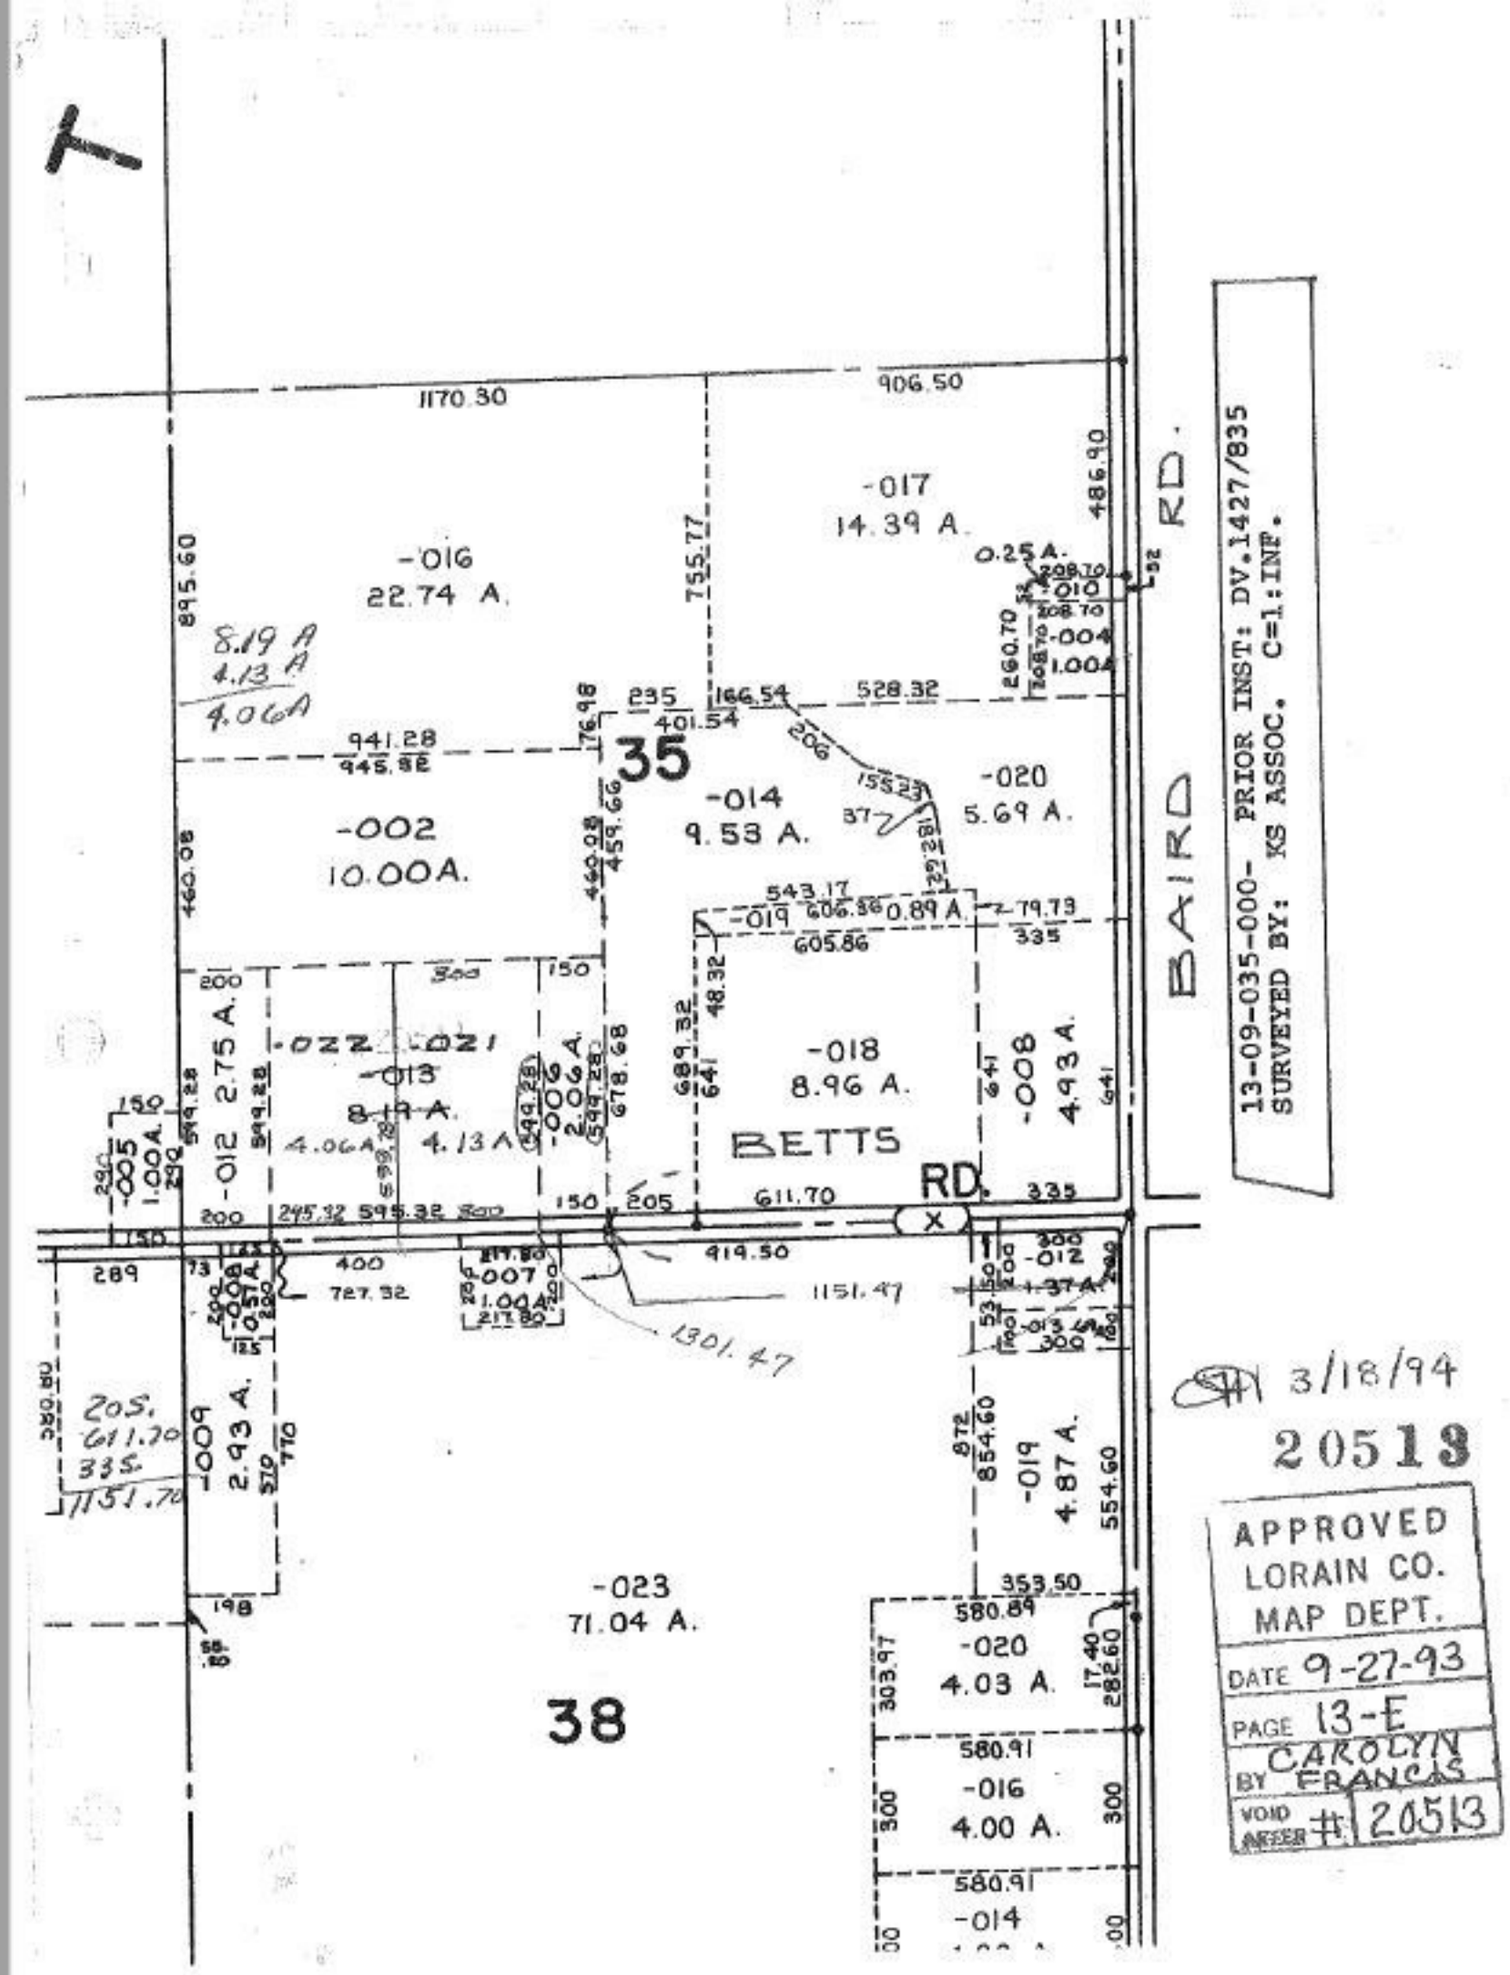

13-09-035-000- PRIOR INST: DV.1427/835
SURVEYED BY: KS ASSOC. C=1:INF.

3/18/94

20513

APPROVED
LORAIN CO.
MAP DEPT.
DATE 9-27-93
PAGE 13-E
BY CAROLYN FRANCIS
VOID AFTER # 20513