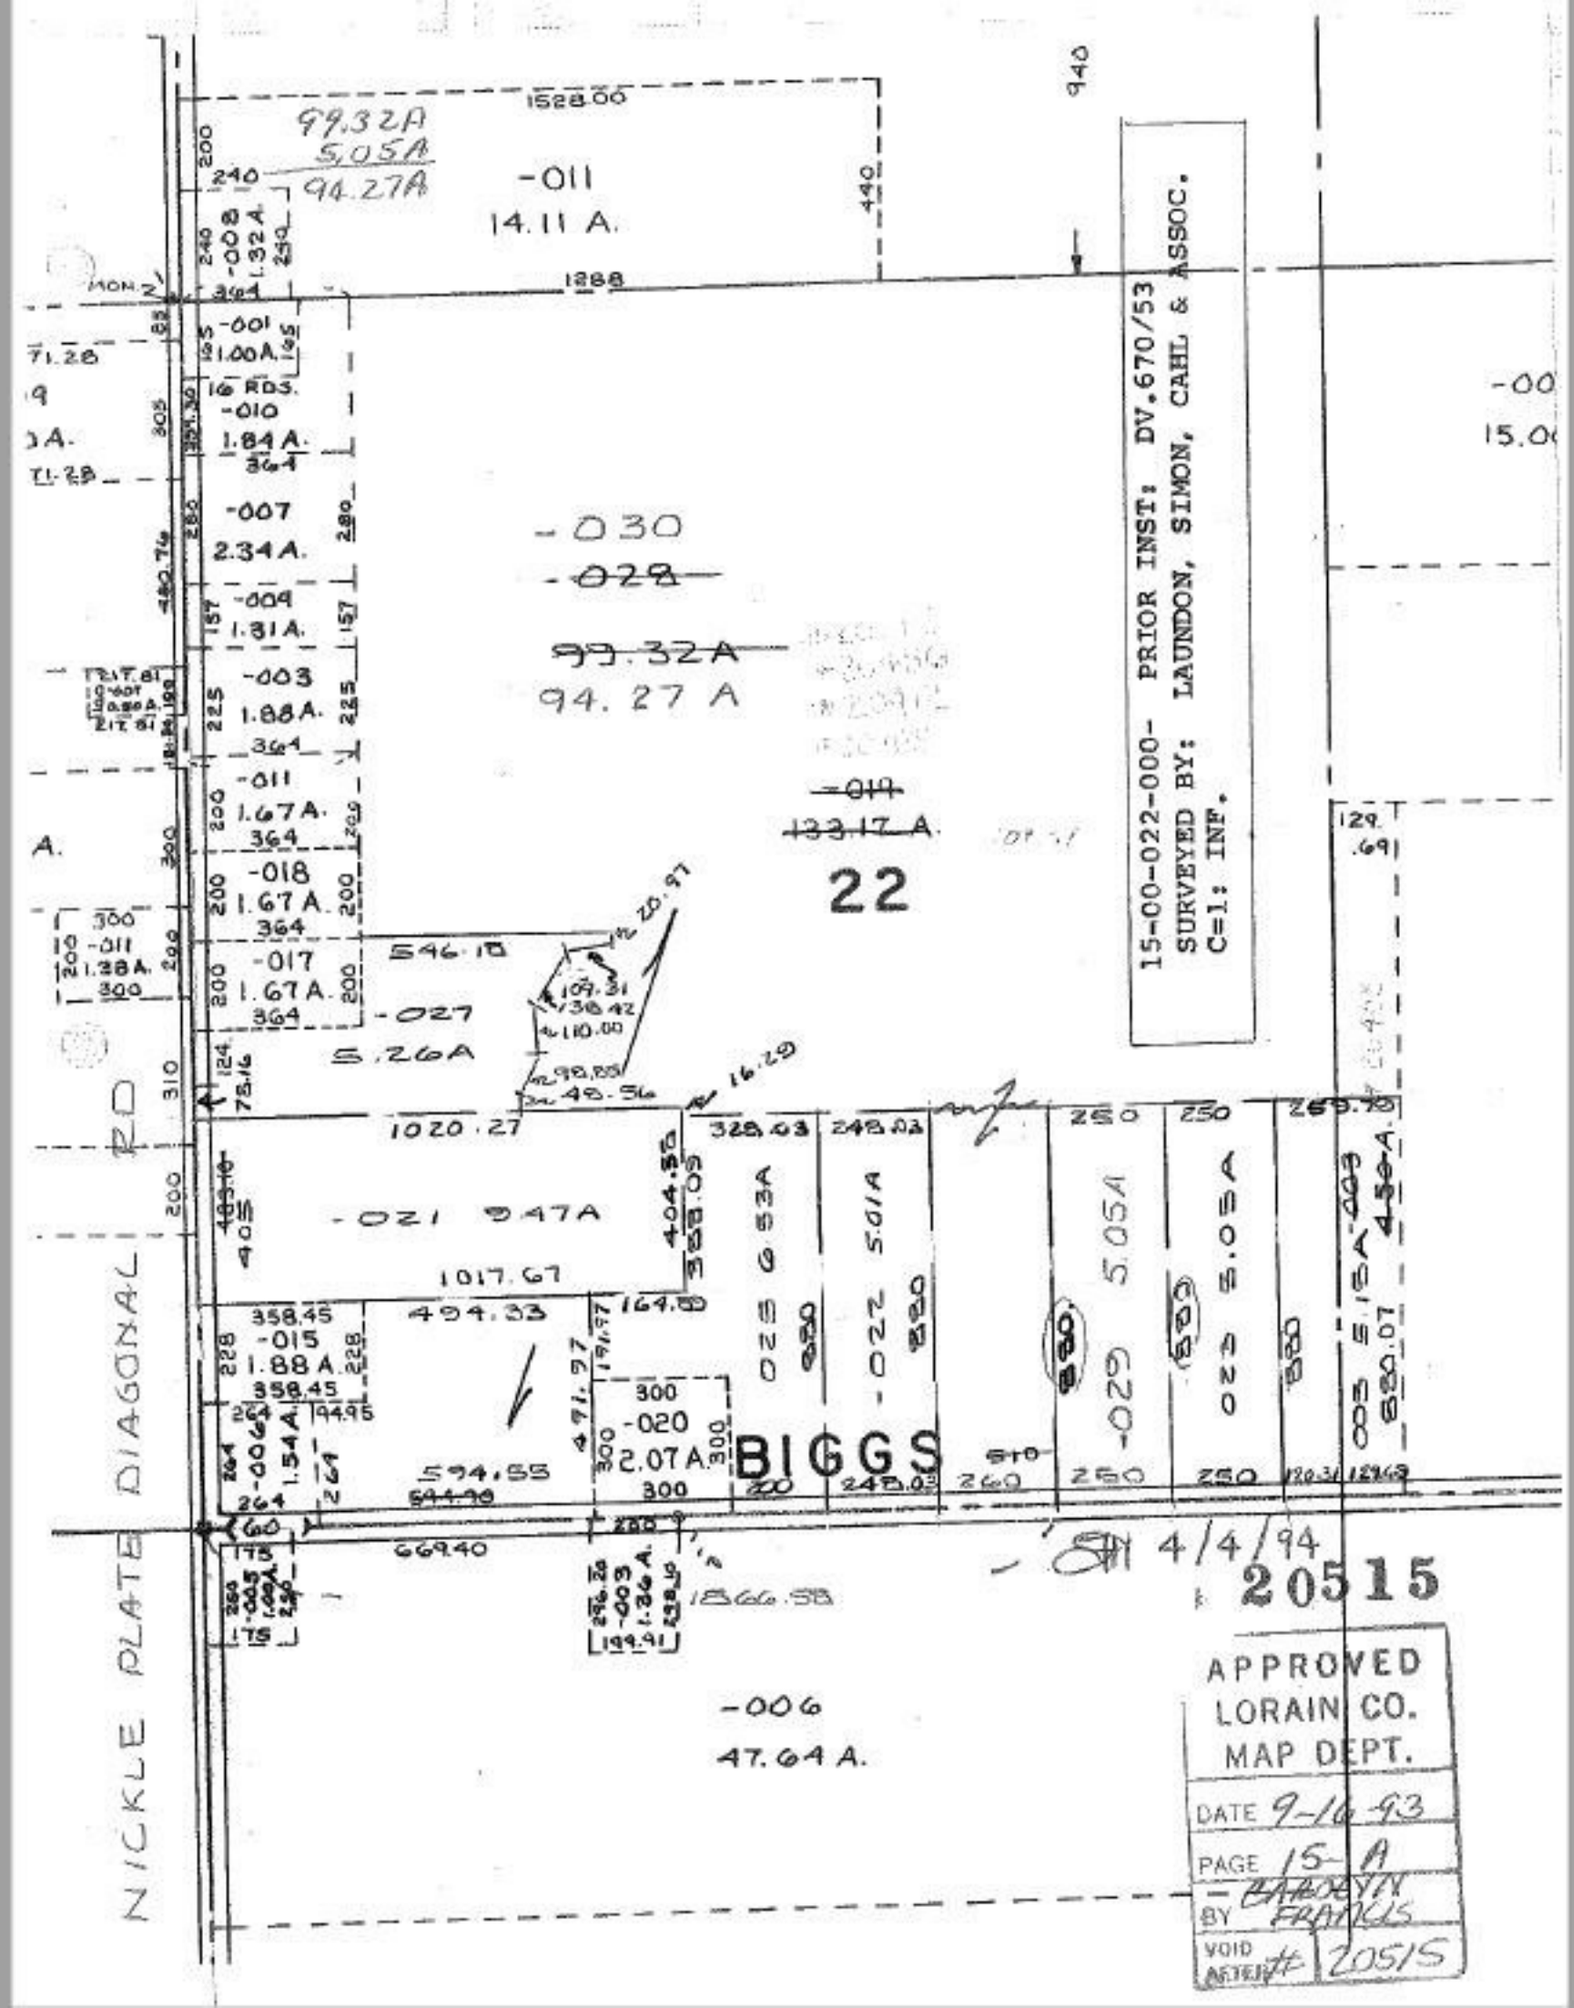

15-00-022-000- PRIOR INST: DV.670/53
SURVEYED BY: LAUNDON, SIMON, CAHL & ASSOC.
C=1: INF.
-011
14.11 A.
99.32A
5.05A
94.27A
-030
~~-028~~
~~99.32A~~
94.27 A
~~-019~~
~~133.17 A.~~
22
-027
5.26A
-021 9.47A
-015
1.88 A.
-020
2.07 A.
BIGGS
-006
47.64 A.
NICKLE PLATE DIAGONAL RD
4/4/94
20515
APPROVED
LORAIN CO.
MAP DEPT.
DATE 9-16-93
PAGE 15-A
BY BARBEYN FRANCIS
VOID AFTER # 20515