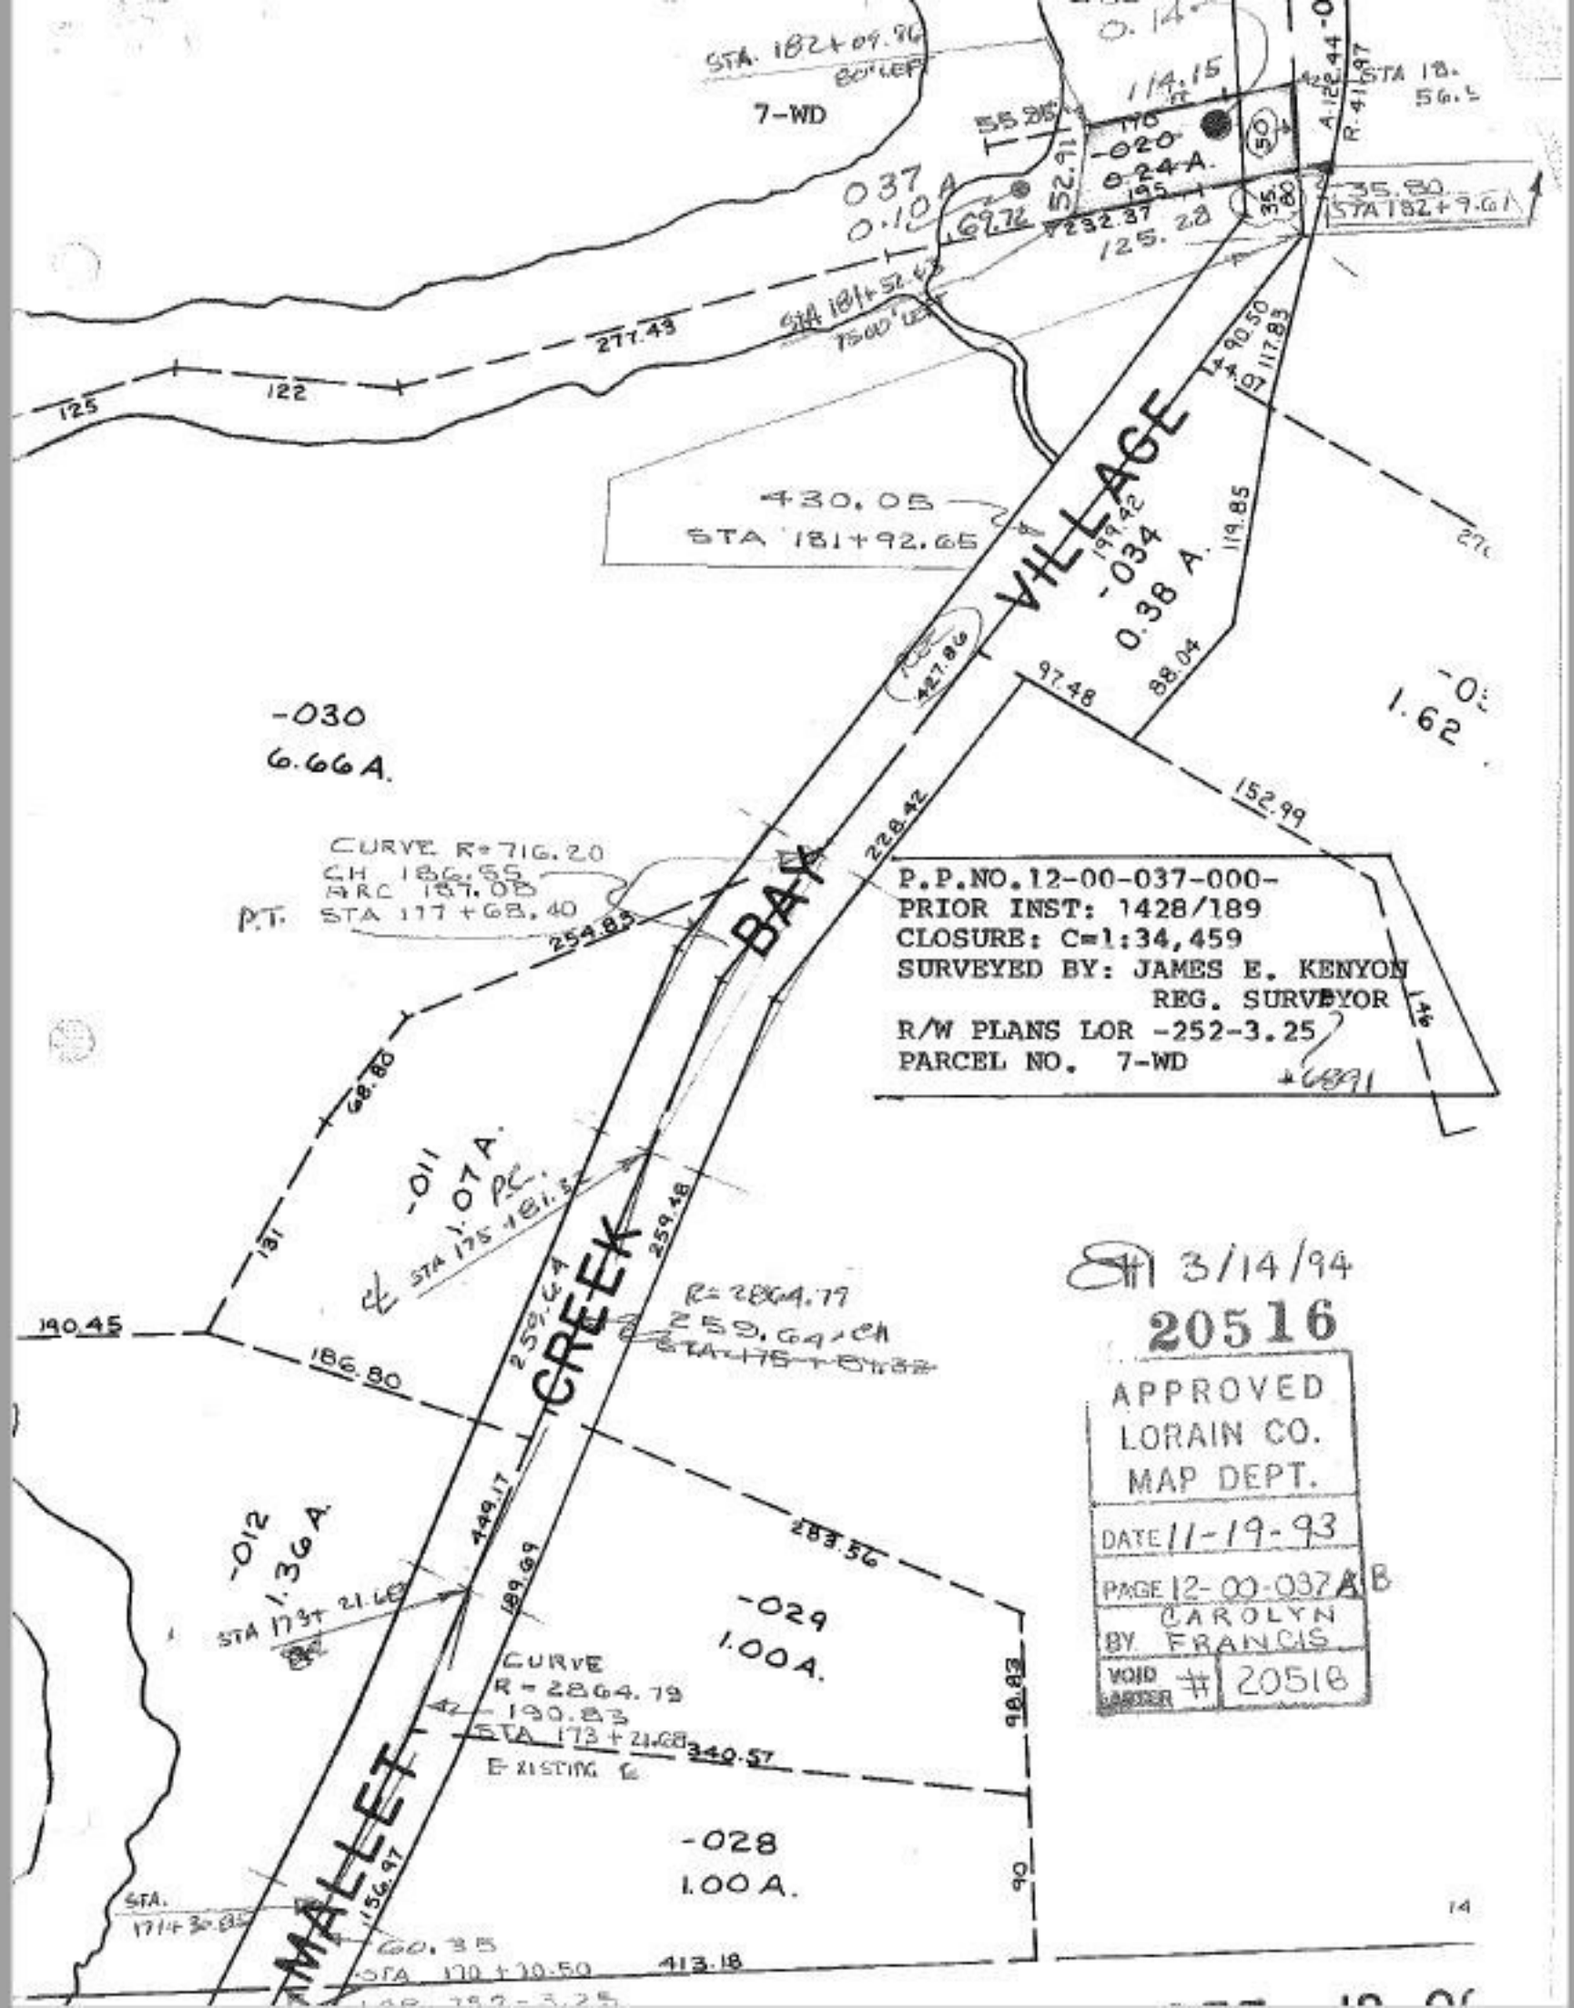

7-WD
STA. 182+09.96
80' LEFT
0.14
114.15
-020
0.24 A.
0.37
0.10 A
69.72
232.37
125.28
35.80
STA 182+9.61
STA 181+52.63
75.00' LEFT
277.43
125
122
430.05
STA 181+92.65
VILLAGE
-034
0.38 A.
119.85
88.04
97.48
427.86
-030
6.66 A.
1.62
152.99
228.42
CURVE R=716.20
CH 186.55
ARC 187.08
P.T. STA 177+68.40
254.83
BAY
P.P.NO.12-00-037-000-
PRIOR INST: 1428/189
CLOSURE: C=1:34,459
SURVEYED BY: JAMES E. KENYON
REG. SURVEYOR
R/W PLANS LOR -252-3.25
PARCEL NO. 7-WD
68.80
131
-011
1.07 A.
P.C.
STA 175+81.32
259.48
259.64
R=2864.79
259.64 CH
STA 175+81.32
190.45
186.80
CREEK
3/14/94
20516
APPROVED
LORAIN CO.
MAP DEPT.
DATE 11-19-93
PAGE 12-00-037 A B
BY CAROLYN FRANCIS
VOID LARGER # 20516
-012
1.36 A.
STA 173+21.68
449.17
189.69
283.56
-029
1.00 A.
CURVE
R=2864.79
190.83
STA 173+21.68
340.57
EXISTING ℄
98.83
-028
1.00 A.
90
MALLET
STA.
171+30.85
156.97
60.35
STA 170+30.50
413.18