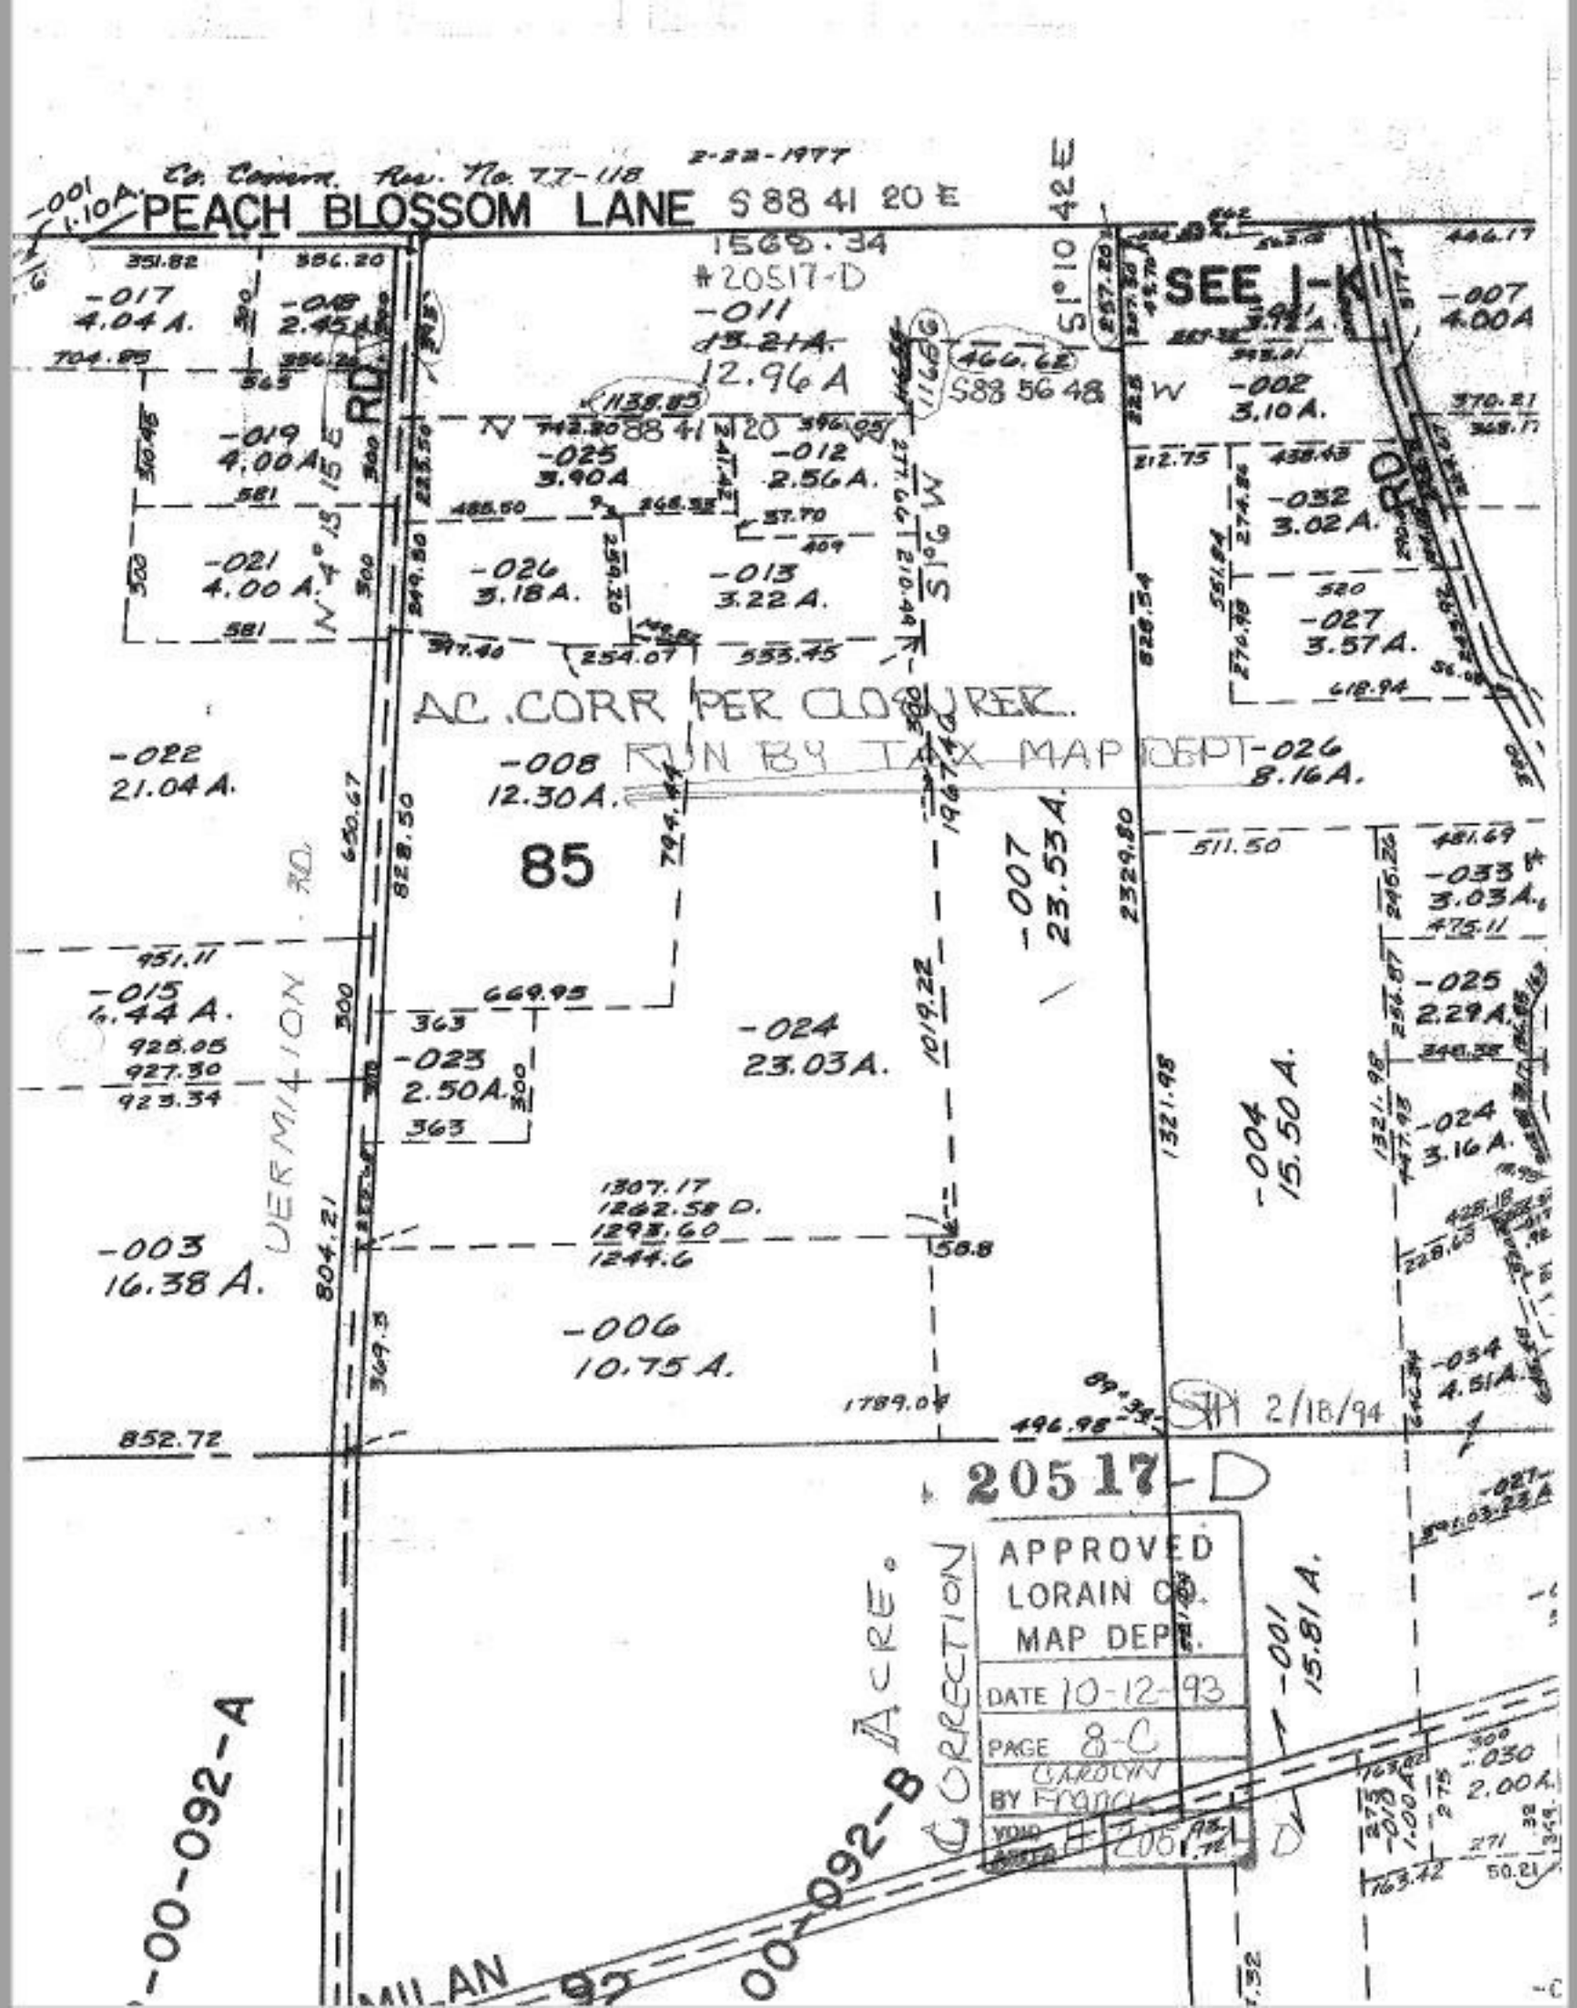

Co. Comm. Res. No. 77-118
2-22-1977
PEACH BLOSSOM LANE
S 88 41 20 E
1569.34
#20517-D
-011
12.96 A
S88 56 48 W
SEE 1-K
-017
4.04 A.
-018
2.45 A.
-019
4.00 A.
-021
4.00 A.
-025
3.90 A
-012
2.56 A.
-026
3.18 A.
-013
3.22 A.
-002
3.10 A.
-032
3.02 A.
-027
3.57 A.
-007
4.00 A
AC. CORR PER CLOSURE
RUN BY TAX MAP DEPT
-022
21.04 A.
-008
12.30 A.
85
-026
8.16 A.
-007
23.53 A.
-033
3.03 A.
-015
6.44 A.
-023
2.50 A.
-024
23.03 A.
-025
2.29 A.
-024
3.16 A.
-004
15.50 A.
-003
16.38 A.
-006
10.75 A.
-034
4.51 A.
2/18/94
20517-D
APPROVED
LORAIN CO.
MAP DEPT.
DATE 10-12-93
PAGE 8-C
BY CAROLYN
VOID
-001
15.81 A.
-030
2.00 A.
ACRE.
CORRECTION
-00-092-A
-00-092-B
MILAN