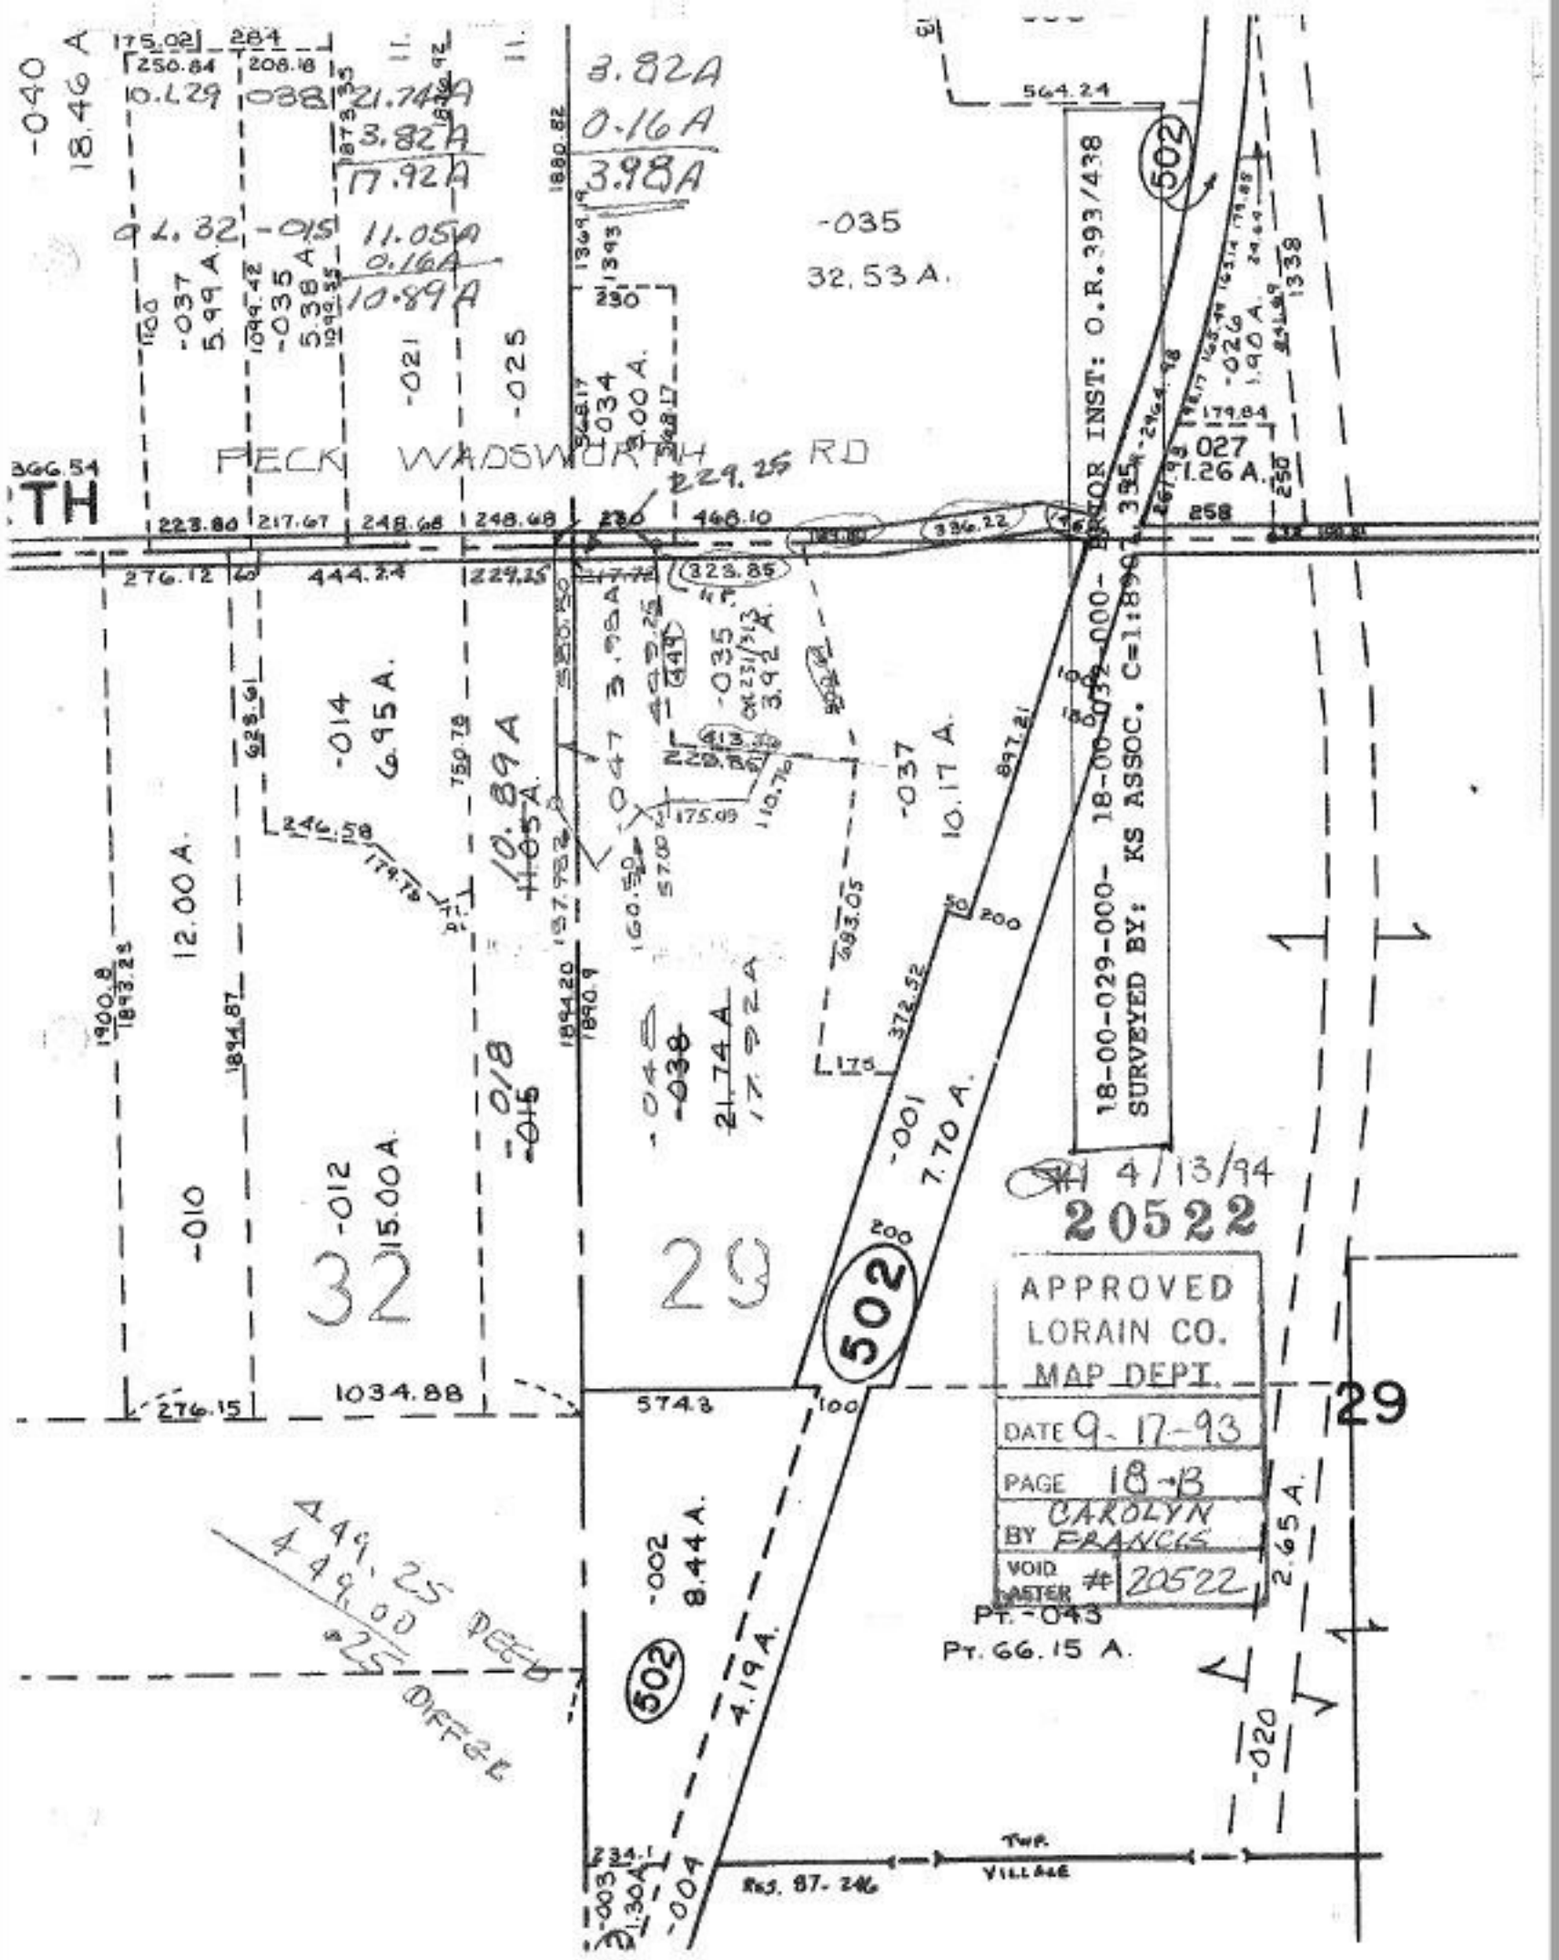
-040
18.46 A
-037
5.99 A
-035
5.38 A
-021
-025
-027
1.26 A.
-026
1.90 A.
-034
3.00 A.
-035
32.53 A.
3.82A
0.16A
3.98A
11.05A
0.16A
10.89A
PECK WADSWORTH RD
TH
-014
6.95 A.
12.00 A.
10.89A
+.05A.
-047
3.95A
-035
3.92 A.
-037
10.17 A.
-012
15.00 A.
-010
-018
-045
-038
21.74 A
17.92A
-043
Pt. 66.15 A.
-002
8.44 A.
-001
7.70 A.
-004
4.19 A.
-003
1.30A
2.65 A.
-020
502
18-00-029-000- 18-00-029-000- PRIOR INST: O.R. 393/438
SURVEYED BY: KS ASSOC. C=1:8903
4/13/94
20522
APPROVED
LORAIN CO.
MAP DEPT.
DATE 9-17-93
PAGE 18-13
BY CAROLYN FRANCIS
VOID LATER # 20522
TWP. VILLAGE
Rec. 87-246
29
449.25 DEED
449.00
.25 DIFF'C