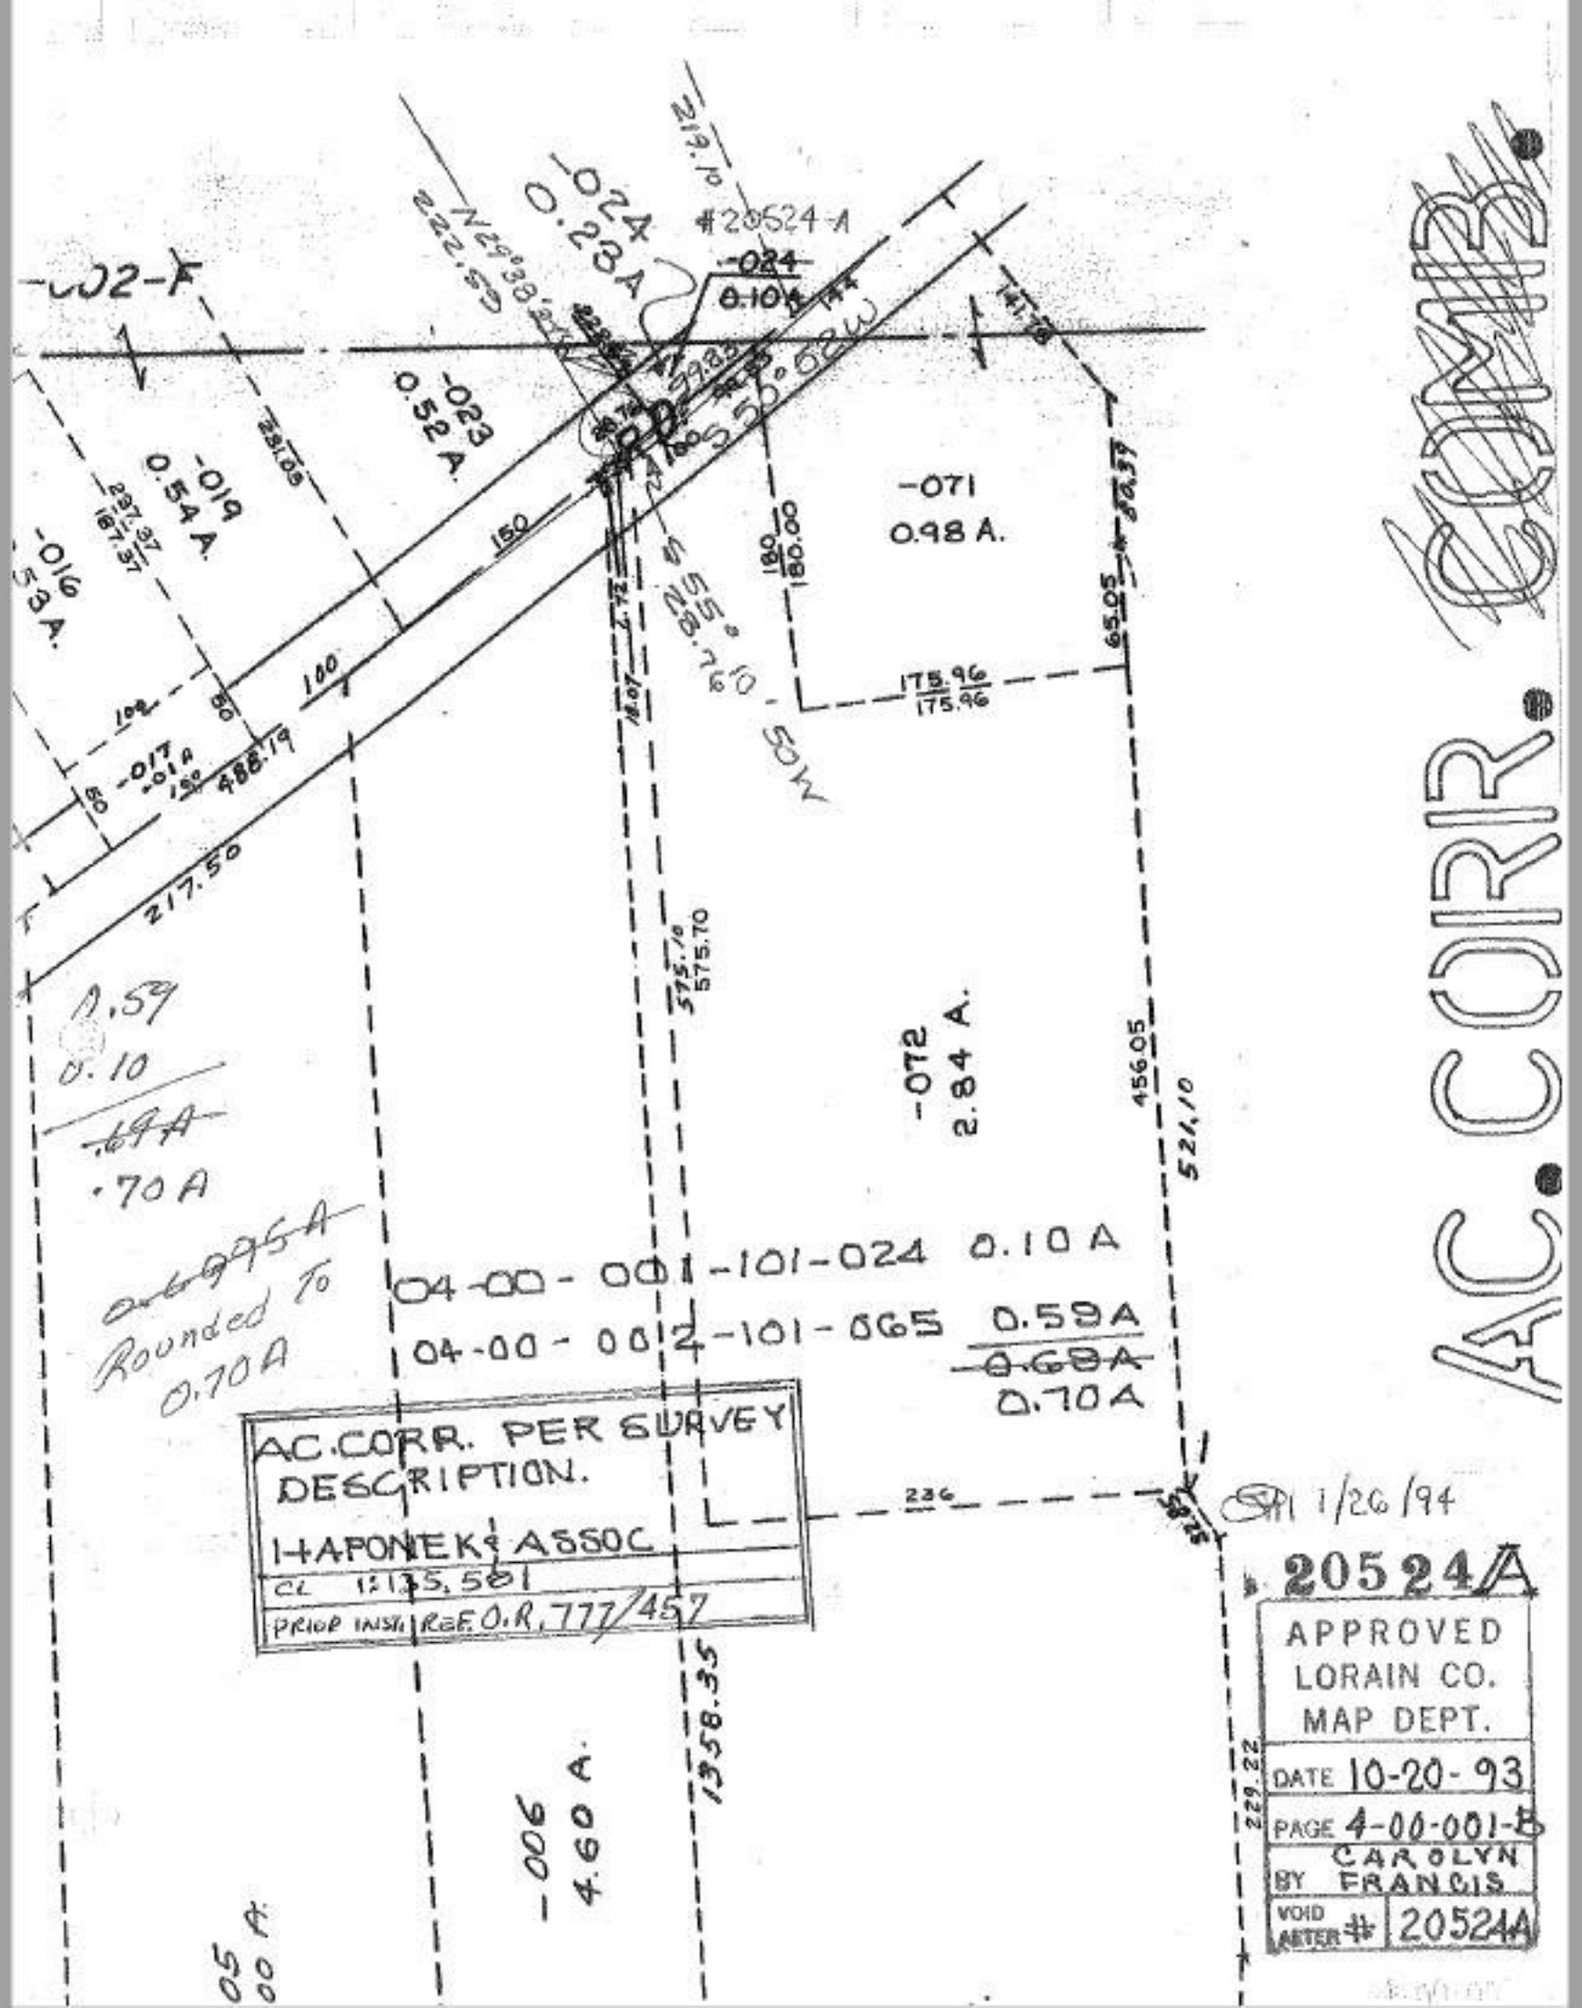

-002-F
-024
0.23 A
#20524-A
-024
0.10 A
-023
0.52 A.
-019
0.54 A.
-016
.53 A.
-071
0.98 A.
-072
2.84 A.
-006
4.60 A.
217.50
488.19
175.96
175.96
65.05
456.05
521.10
575.70
575.10
1358.35
229.22
0.59
0.10
~~.69A~~
.70 A
~~0.6995A~~
Rounded To
0.70A
04-00-001-101-024 0.10 A
04-00-002-101-065 0.59A
~~0.68A~~
0.70A
AC.CORR. PER SURVEY
DESCRIPTION.
HAPONEK & ASSOC
CL 1:135,581
PRIOR INST. REF. O.R. 777/457
1/26/94
20524A
APPROVED
LORAIN CO.
MAP DEPT.
DATE 10-20-93
PAGE 4-00-001-B
BY CAROLYN FRANCIS
VOID AFTER # 20524A

AC. CORR. COMP.