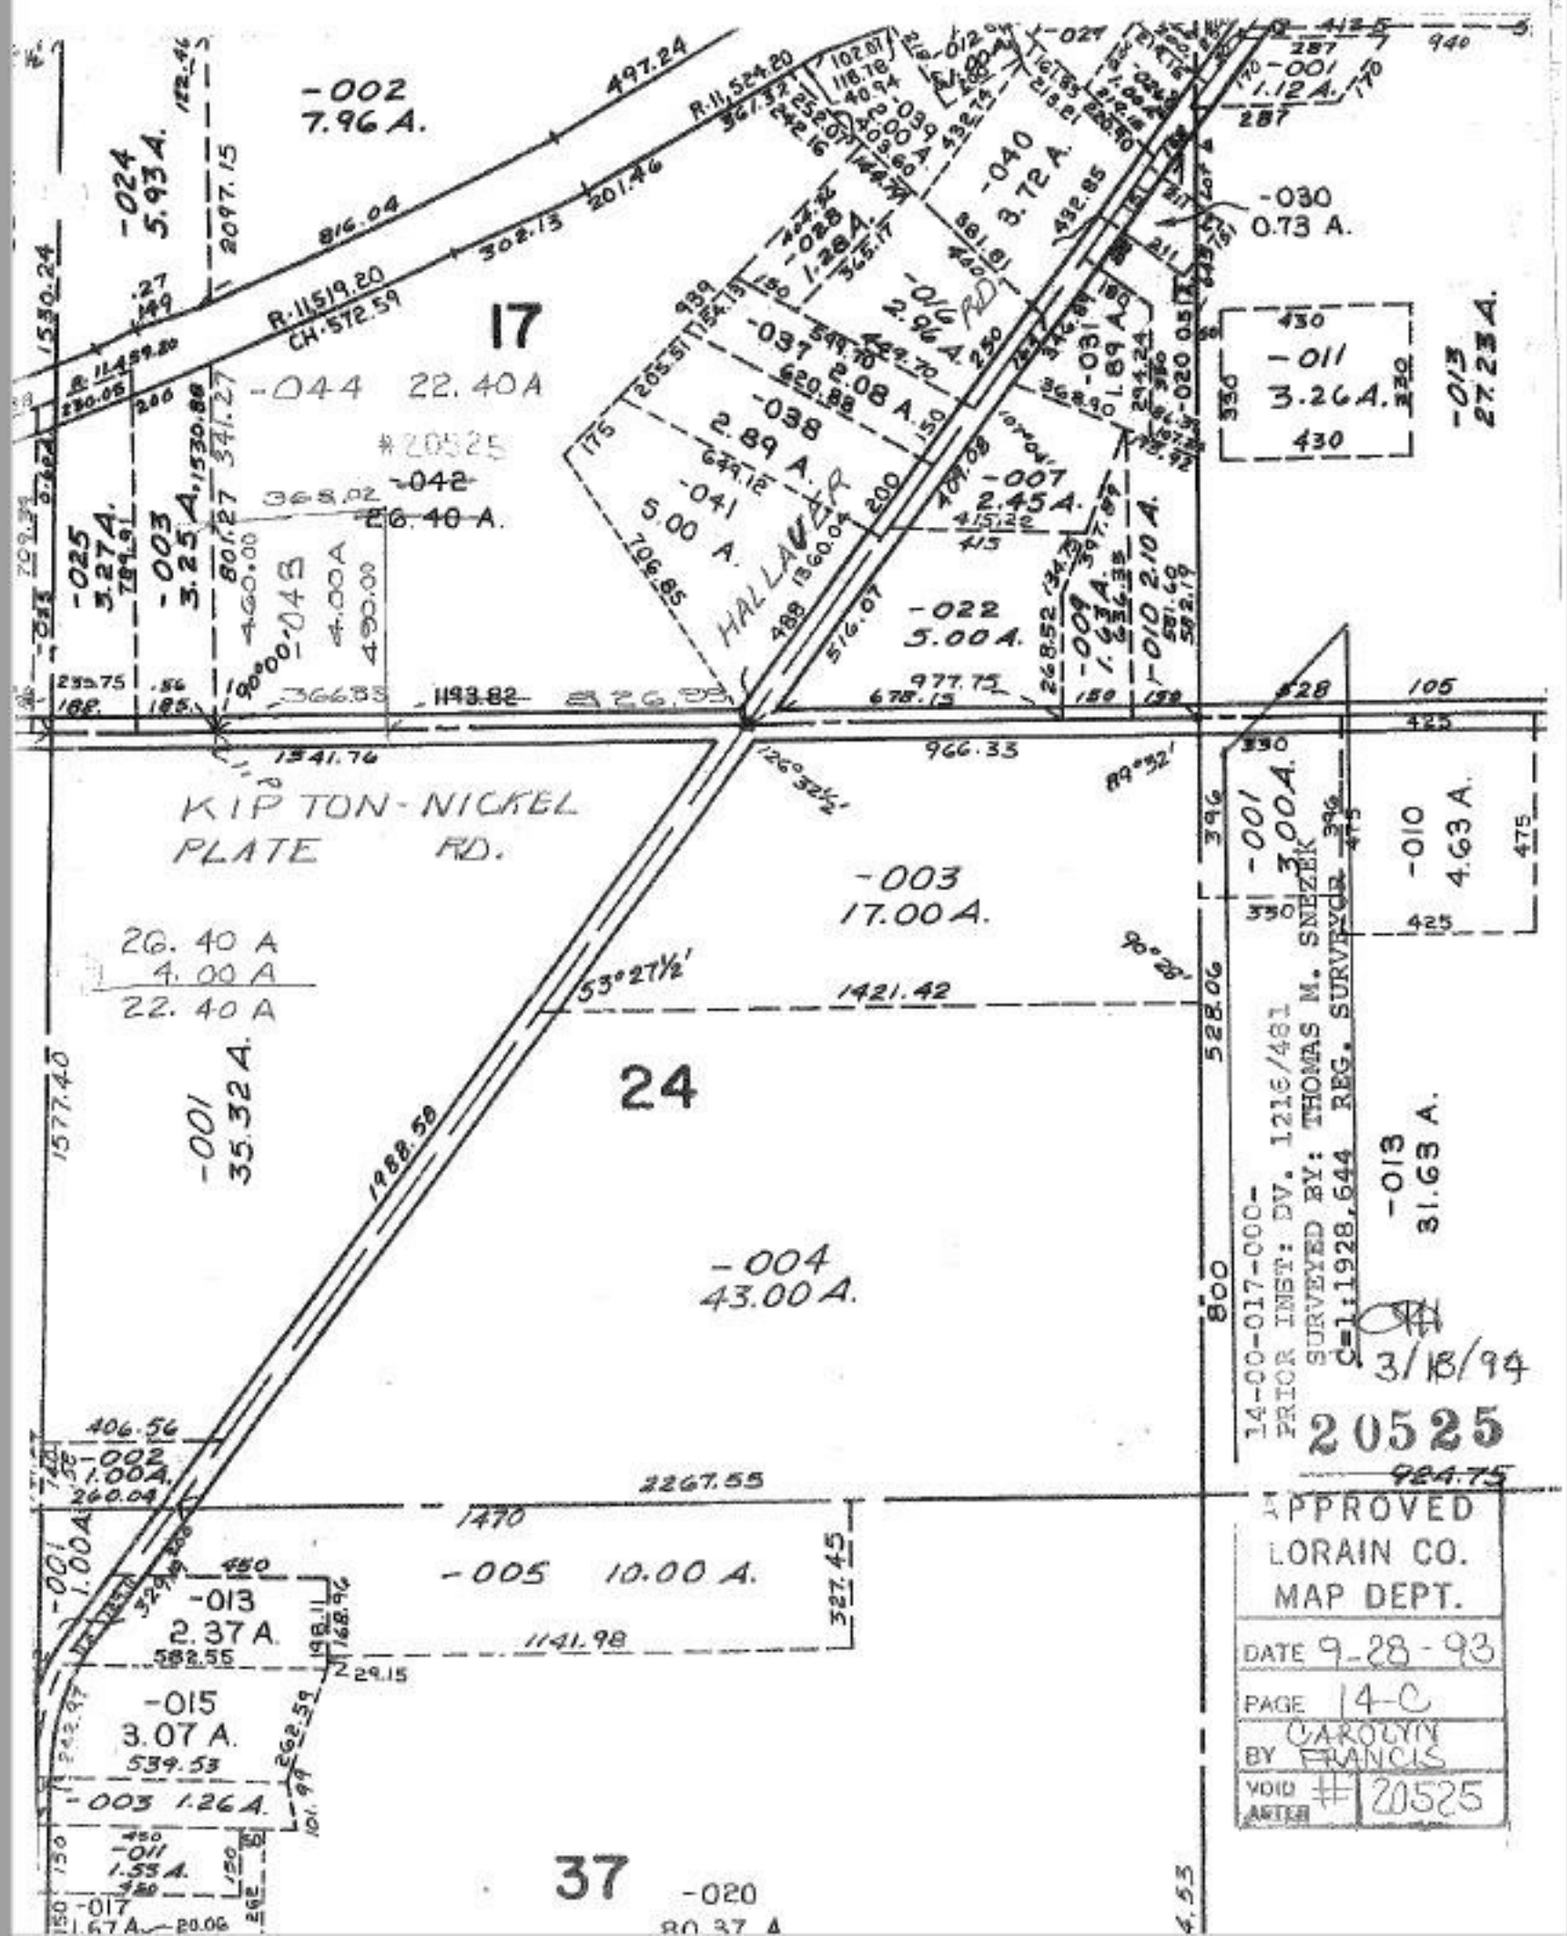
17
-002
7.96 A.
-024
5.93 A.
-044 22.40A
#20525
-042
6.40 A.
-025
3.27 A.
-003
3.25 A.
-043
4.00 A.
-041
5.00 A.
-037
2.08 A.
-038
2.89 A.
-039
-028
1.28 A.
-040
3.72 A.
-016
2.96 A.
-027
-030
0.73 A.
-031
1.89 A.
-020
-007
2.45 A.
-022
5.00 A.
-009
1.43 A.
-010
2.10 A.
-011
3.26 A.
-013
27.23 A.
-012
HALLAUER RD.
KIPTON-NICKEL PLATE RD.
-001
1.12 A.
-003
17.00 A.
20.40 A
4.00 A
22.40 A
24
-001
35.32 A.
-004
43.00 A.
-001
3.00 A.
-010
4.63 A.
SURVEYED BY: THOMAS M. SNEZEK
SURVEYOR REG.
-013
31.63 A.
14-00-017-000-
PRIOR INST: DV. 1216/481
C=1;1928,644
37
-020
80.37 A.
-002
1.00 A.
-001
1.00 A.
-013
2.37 A.
-015
3.07 A.
-003 1.26 A.
-011
1.55 A.
-017
1.67 A.
-005 10.00 A.
3/18/94
20525
APPROVED
LORAIN CO.
MAP DEPT.
DATE 9-28-93
PAGE 14-C
BY CAROLYN FRANCIS
VOID AFTER # 20525