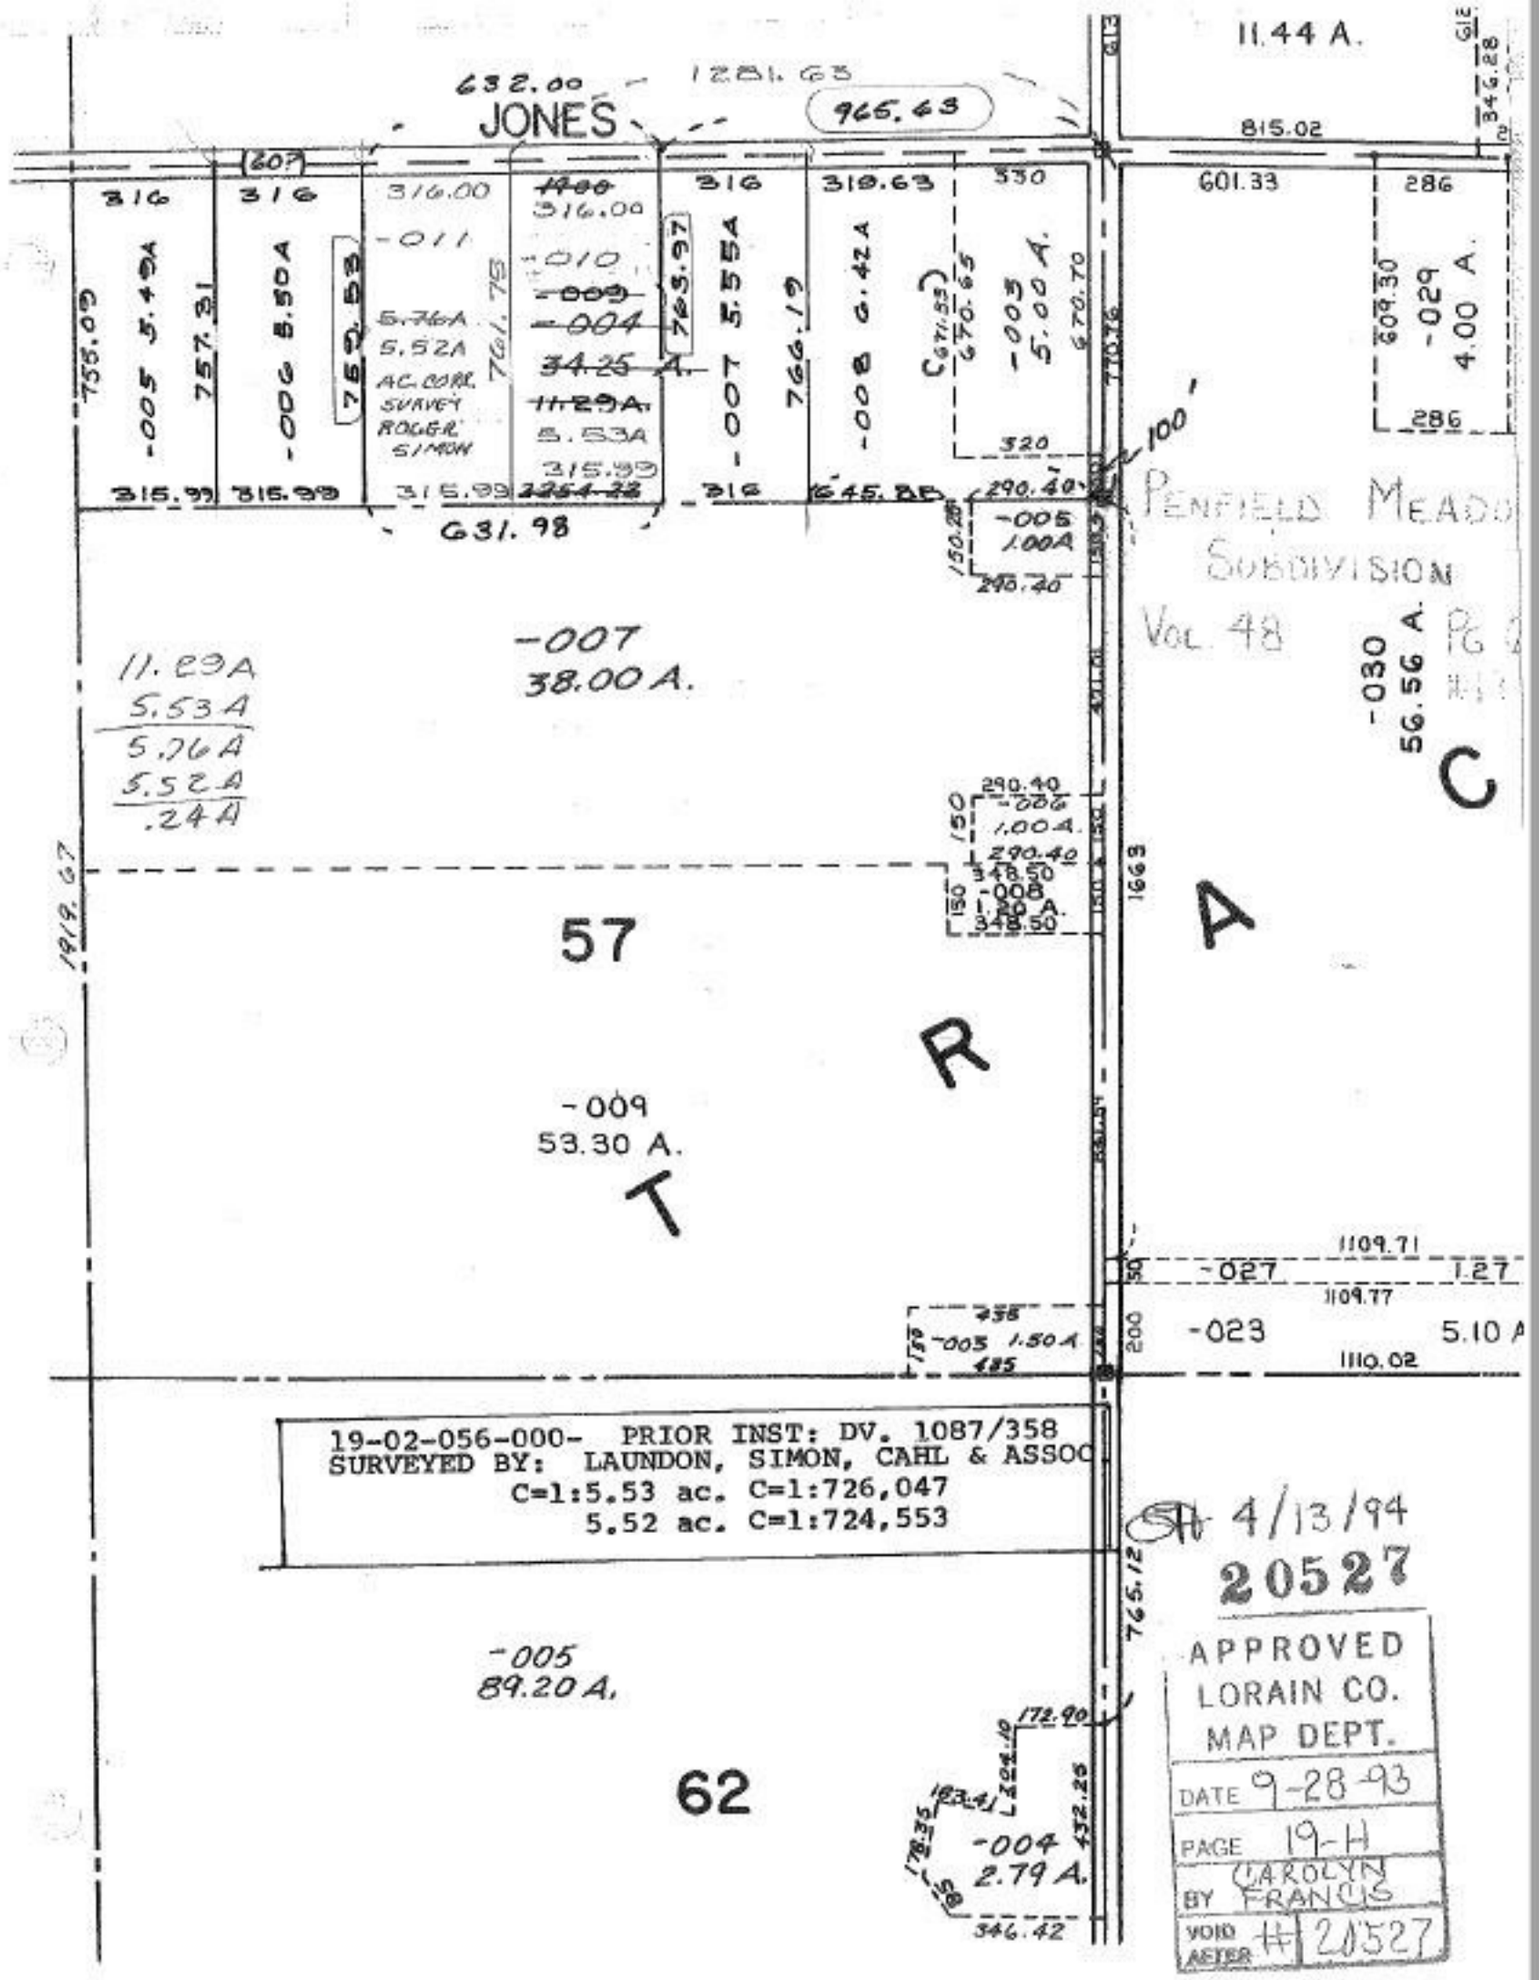
632.00
1281.65
965.63
JONES
607
11.44 A.
815.02
346.28
316
316
316.00
316.00
316
319.63
530
601.33
286
755.09
-005 5.49A
757.31
-006 8.50A
760.53
-011
-010
-009
-004
34.25 A.
11.29A.
5.53A
765.97
766.19
-007 5.55A
-008 6.42A
(671.55)
670.65
-003
5.00 A.
670.70
770.76
609.30
-029
4.00 A.
286
5.76A
5.52A
AC. CORR.
SURVEY
ROGER
SIMON
761.75
315.99
315.99
315.99
3254.28
316
645.85
320
290.40
100'
-005
1.00A
290.40
150.28
631.98
PENFIELD MEADOWS
SUBDIVISION
VOL. 48
-030
56.56 A.
PG
11.29A
5.53A
5.76A
5.52A
.24A
-007
38.00A.
1919.67
57
290.40
1.00A.
290.40
150
348.50
-008
30 A.
348.50
1663
A
R
-009
53.30 A.
T
1109.71
-027
1.27
1109.77
-023
5.10 A
1110.02
458
-005 1.50A
485
200
19-02-056-000- PRIOR INST: DV. 1087/358
SURVEYED BY: LAUNDON, SIMON, CAHL & ASSOC
C=1:5.53 ac. C=1:726,047
5.52 ac. C=1:724,553
765.12
-005
89.20A.
62
172.90
124.10
183.4
178.35
-004
2.79 A.
432.25
58
346.42
4/13/94
20527
APPROVED
LORAIN CO.
MAP DEPT.
DATE 9-28-93
PAGE 19-H
BY CAROLYN FRANCIS
VOID AFTER # 20527