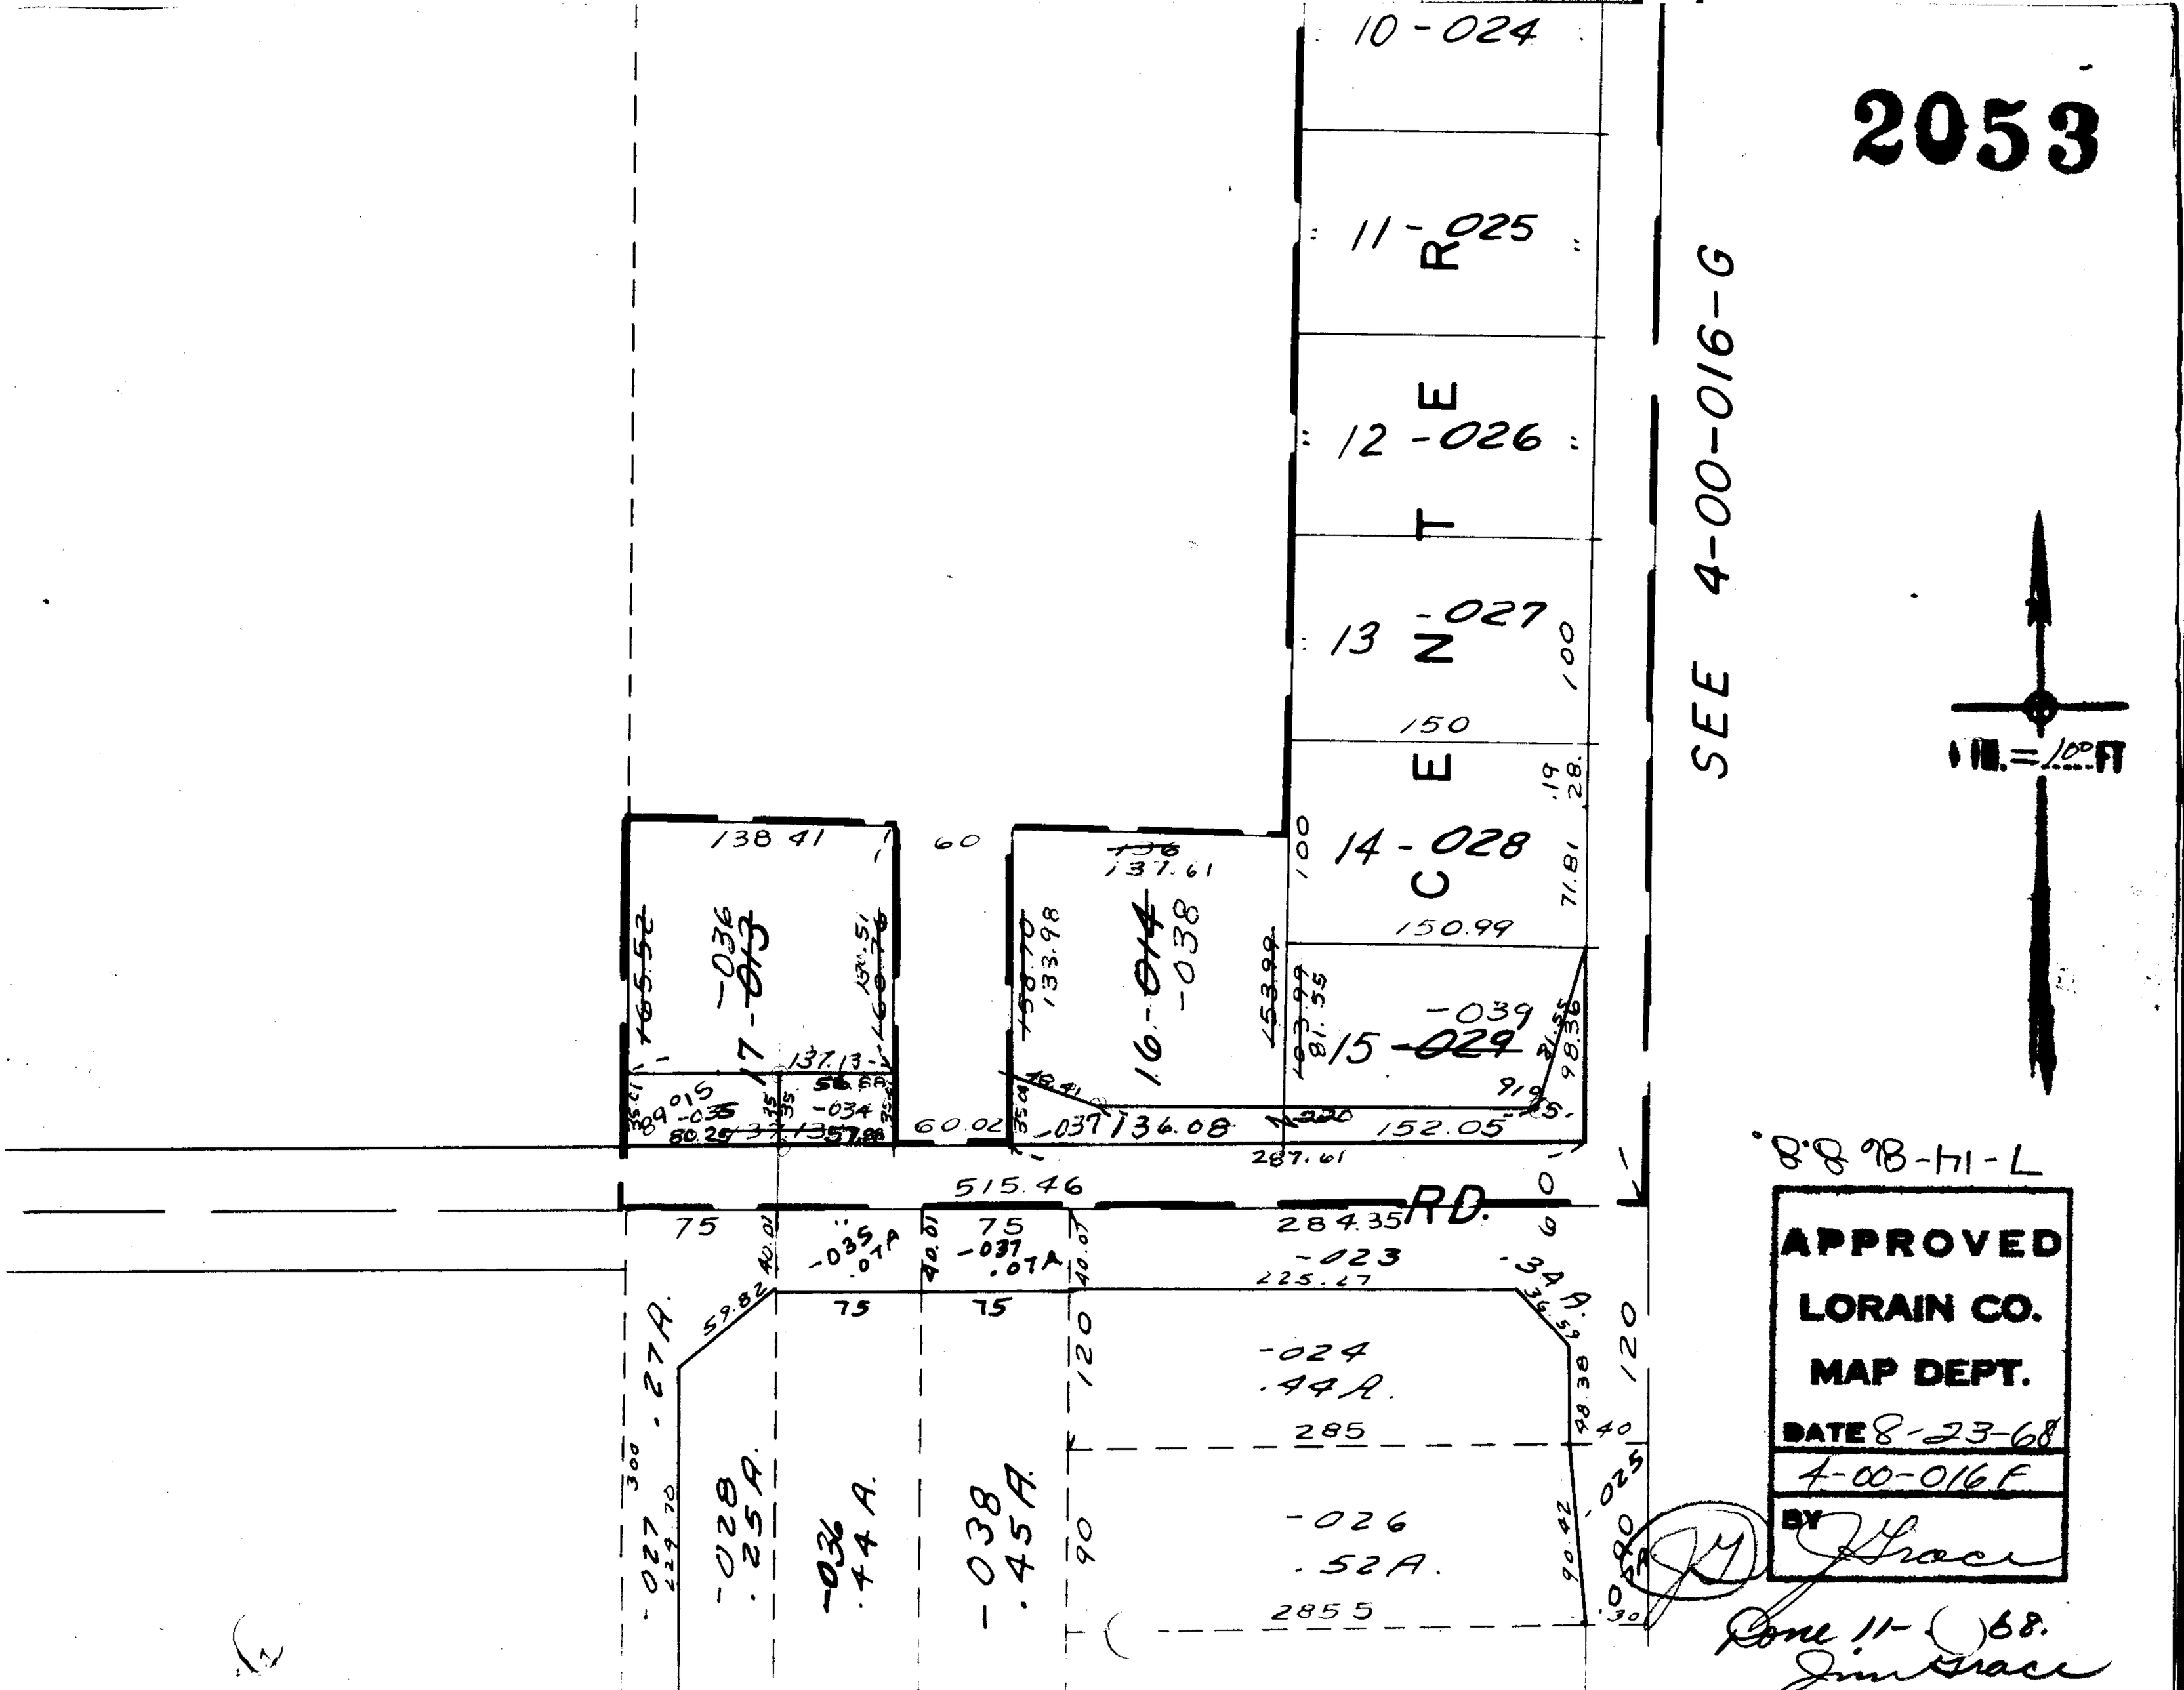
2053
10-024
11-025
12-026
13-027
14-028
15-029
16-014
17-013
-036
-039
-038
-037
-035
-034
-023
-024
.44A.
-026
.52A.
-028
.25A.
-036
.44A.
-038
.45A.
-027
.27A.
-035
.07A
-037
.07A
.34A.
-025
.05A
RD.
SEE 4-00-016-G
1 IN. = 100 FT
138.41
60
137.61
150.99
152.05
136.08
287.61
515.46
284.35
225.27
285
285.5
60.02
75
120
90
100
150
71.81
98.36
81.55
133.98
137.13
56.68
80.25
59.82
40.01
40.07
36.59
48.38
90.42
.19
.28
.30
300
229.70
8.8.98-41-L
APPROVED
LORAIN CO.
MAP DEPT.
DATE 8-23-68
4-00-016F
BY J Grace
Done 11-( )68.
Jim Grace