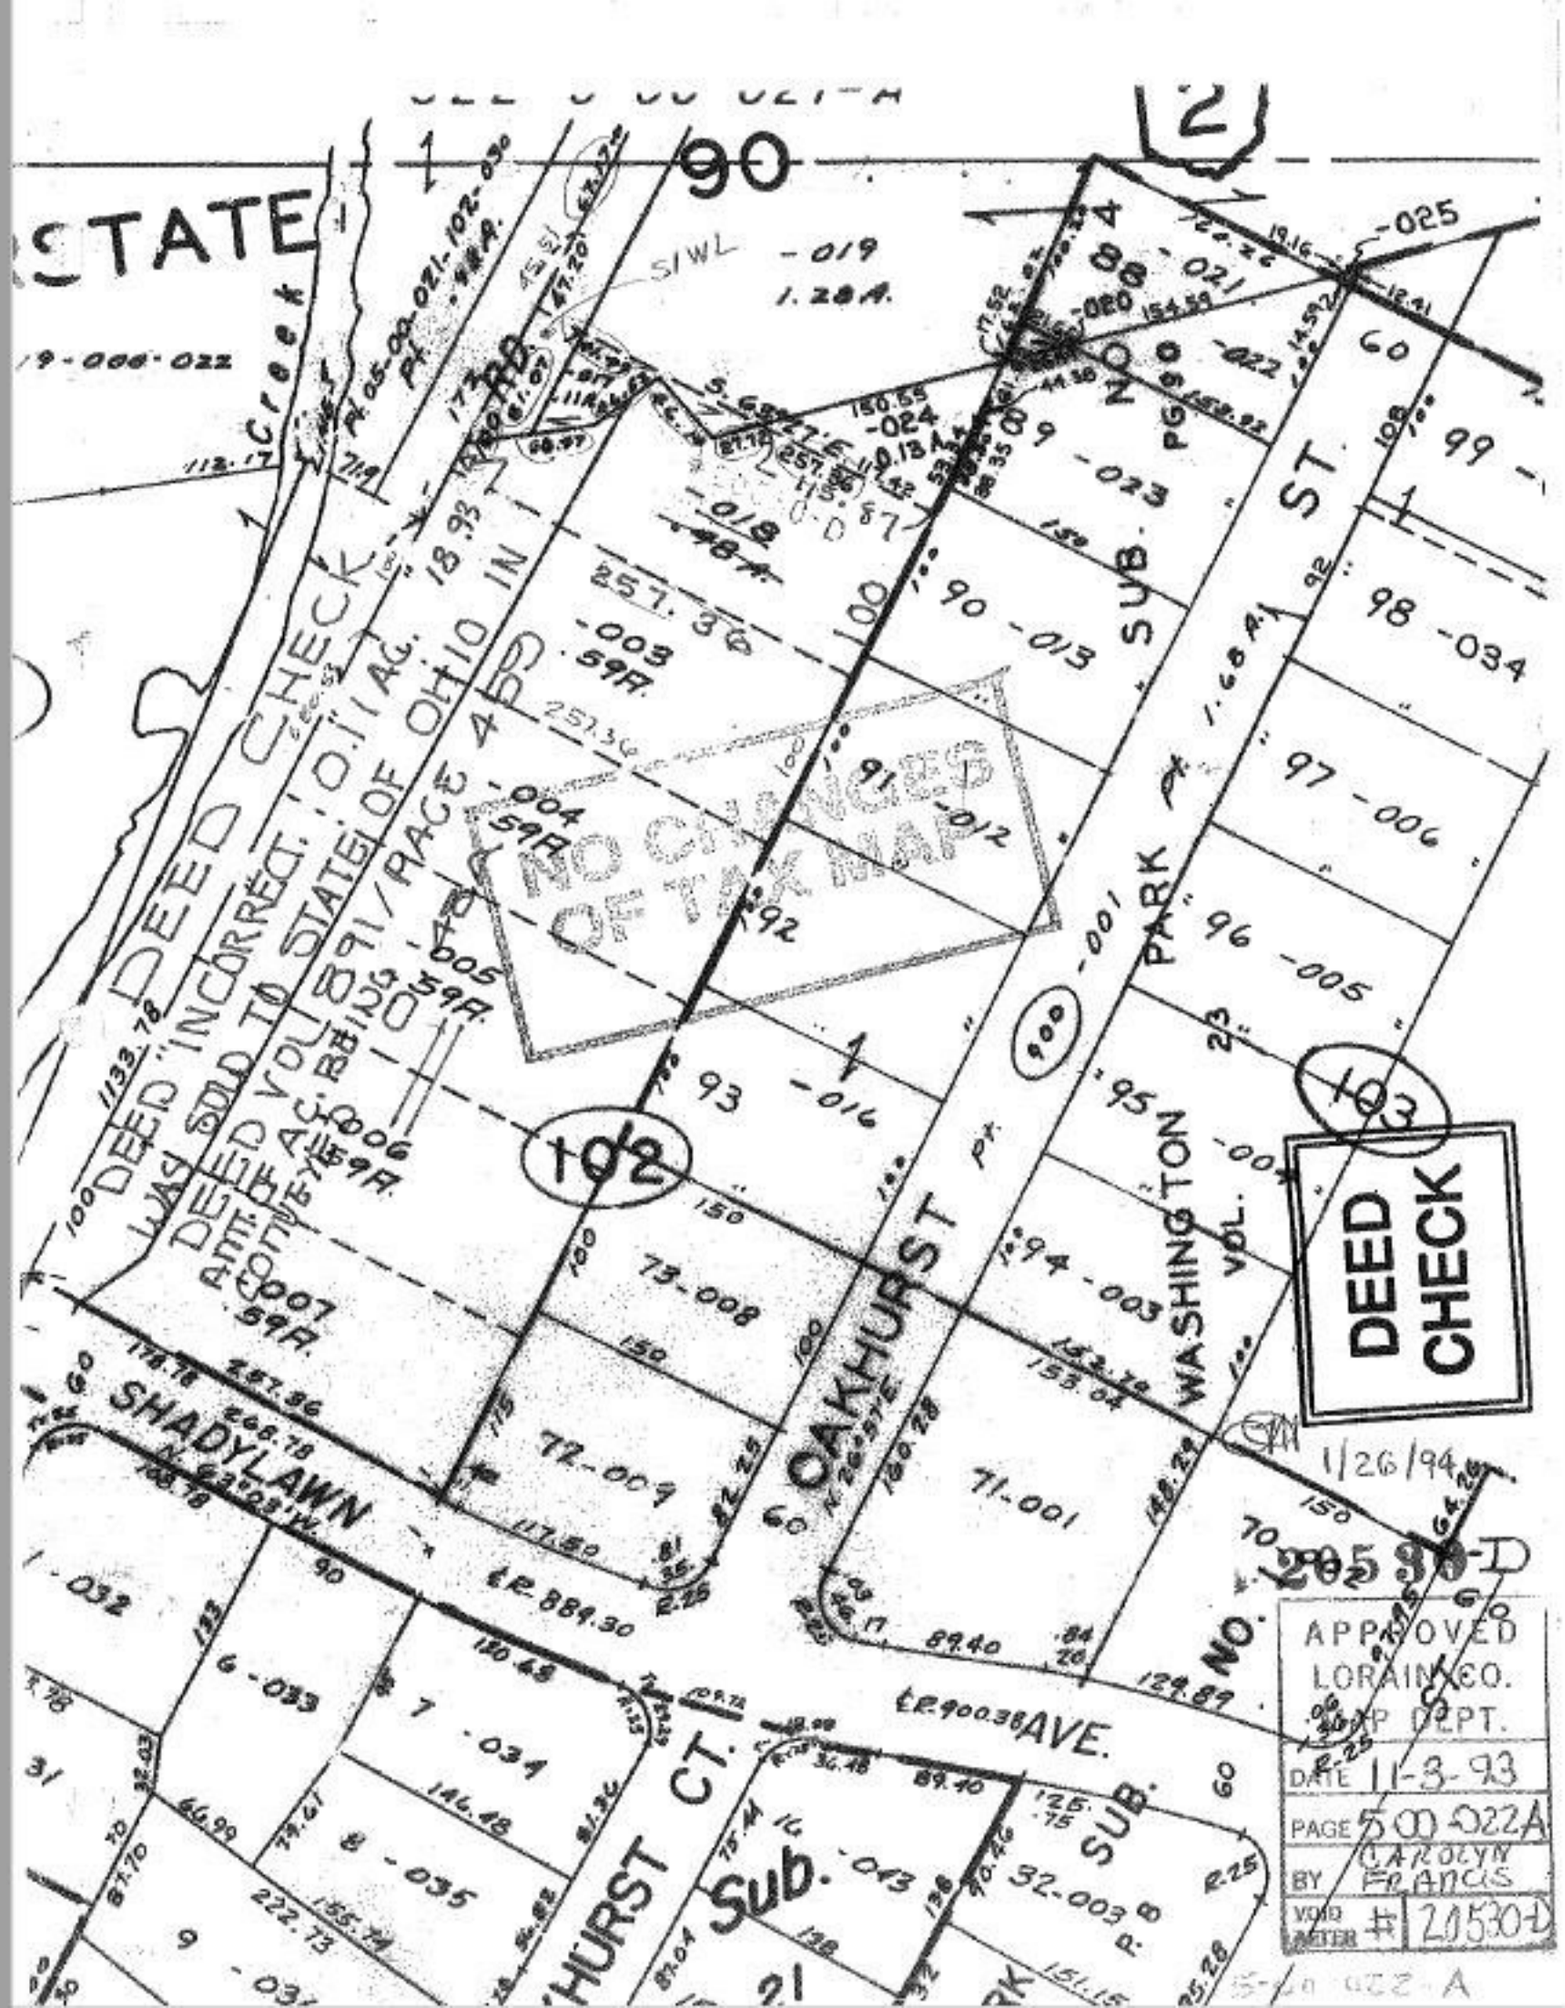
STATE
90
-019
1.28A.
-021
-020
-025
-022
-024
0.13A.
-023
-018
-017
-013
-012
-001
-004
-005
-006
-007
-016
-008
-009
-032
-033
-031
-035
-036
-043
-003
-034
-012
-022
DEED CHECK
INCORRECT. O.T. AG.
DEED "INCORRECT" O.T. AG.
NO CHANGES OF TAX MAP
DEED CHECK
SUB.
PARK ST.
OAKHURST
OAKHURST CT.
SHADYLAWN AVE.
WASHINGTON
VOL.
PG.
1/26/94
APPROVED
LORAIN CO.
MAP DEPT.
DATE 11-3-93
PAGE 500-022A
BY CAROLYN FRANCIS
VOID AFTER # 205301-D
500-022-A