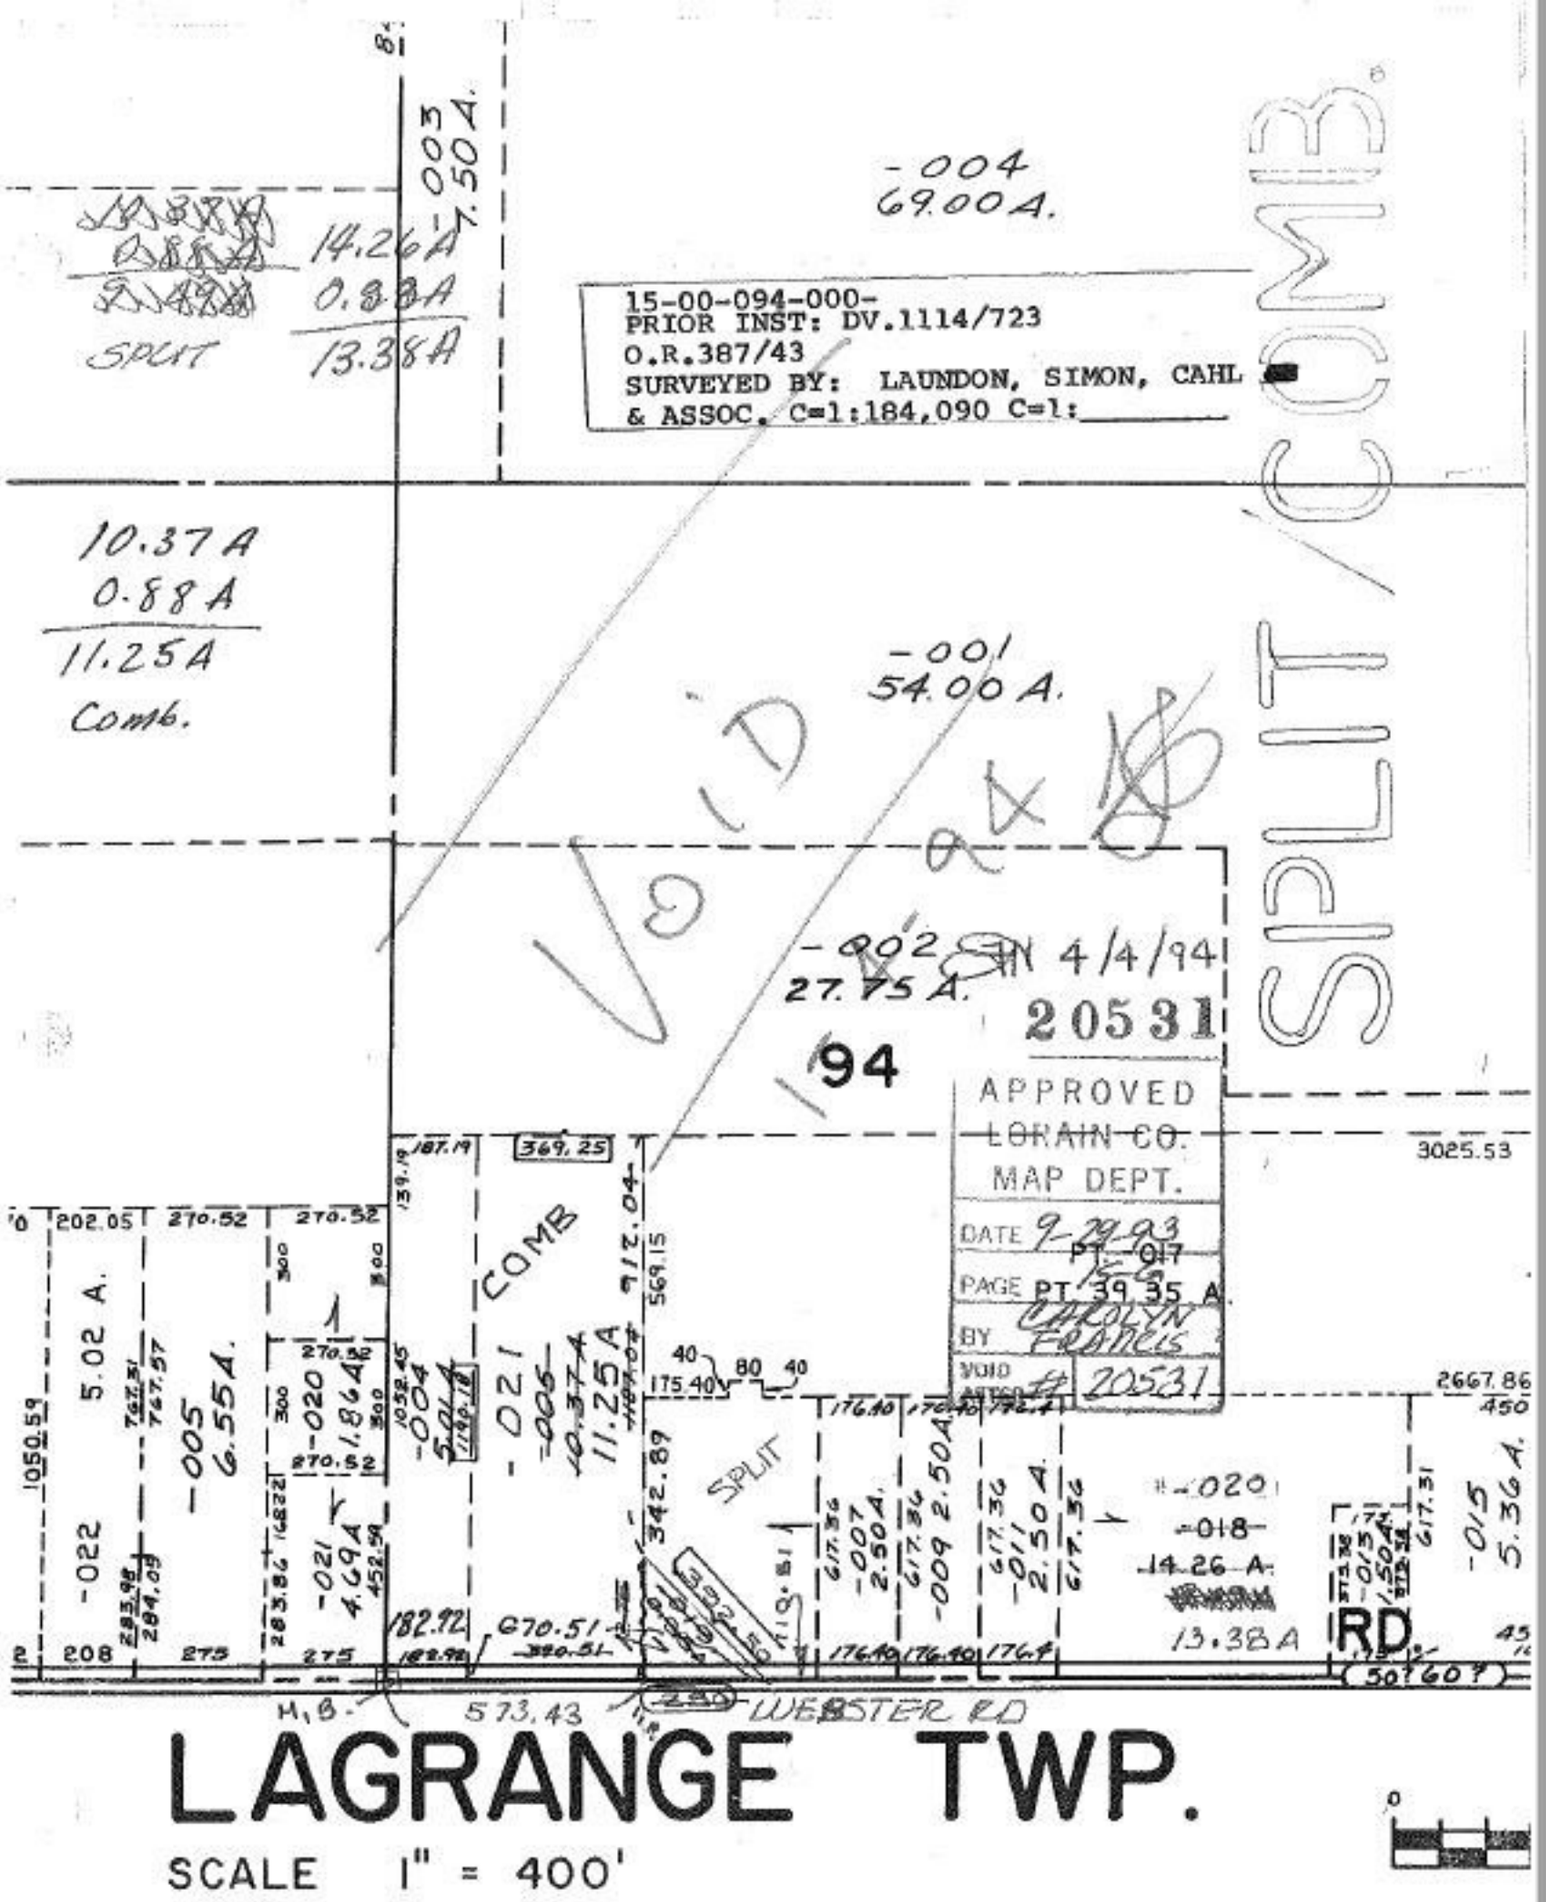
-003
7.50A.
14.26A
0.88A
13.38A
SPLIT
-004
69.00A.
15-00-094-000-
PRIOR INST: DV.1114/723
O.R.387/43
SURVEYED BY: LAUNDON, SIMON, CAHL & ASSOC. C=1:184,090 C=1:
10.37A
0.88A
11.25A
Comb.
-001
54.00A.
-002
27.75A.
4/4/94
20531
94
APPROVED
LORAIN CO.
MAP DEPT.
DATE 9-29-93
PAGE PT 39.35 A.
BY CAROLYN FRANCIS
VOID AFFID. # 20531
SPLIT/COMB.
5.02 A.
-022
-005
6.554A.
-020
1.864A
-021
4.694A
-021
COMB
-005
10.37A
11.25A
-004
5.01A
SPLIT
-007
2.504A.
-009
2.504A.
-011
2.504A.
-020
-018
14.26 A.
13.38A
-015
5.36A.
RD
WEBSTER RD
LAGRANGE TWP.
SCALE 1" = 400'