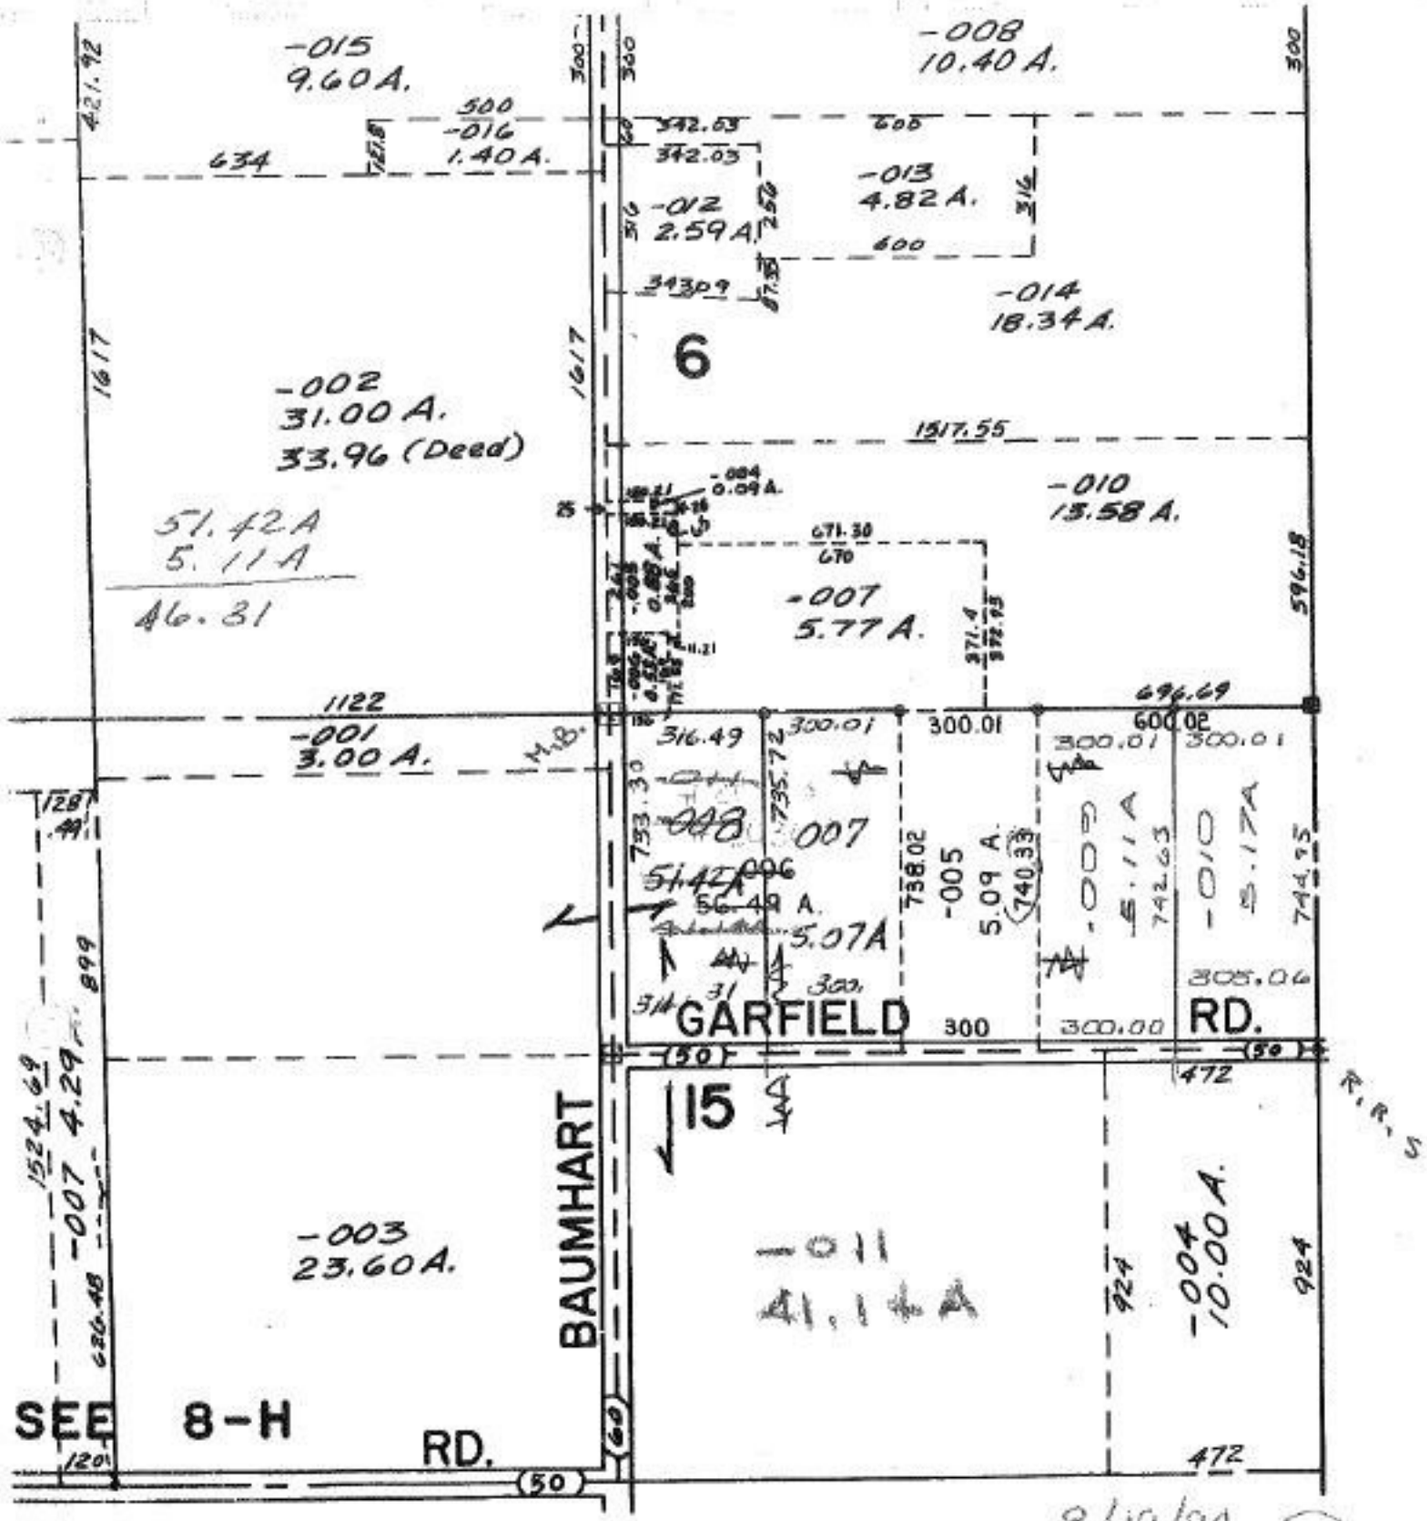

08-15-015-000- PRIOR INST: O.R.553/948
SURVEYED BY: RICHARD A. ROSEBECK
C=1:360,791 5.11 ac. C REG. SURVEYOR
C=1:997,171 5.17 ac.

8/19/94

20534

APPROVED
LORAIN CO.
MAP DEPT.
DATE 9-30-93
PAGE 8-D
BY CAROLYN FRANCIS
VOID AFTER # 20534