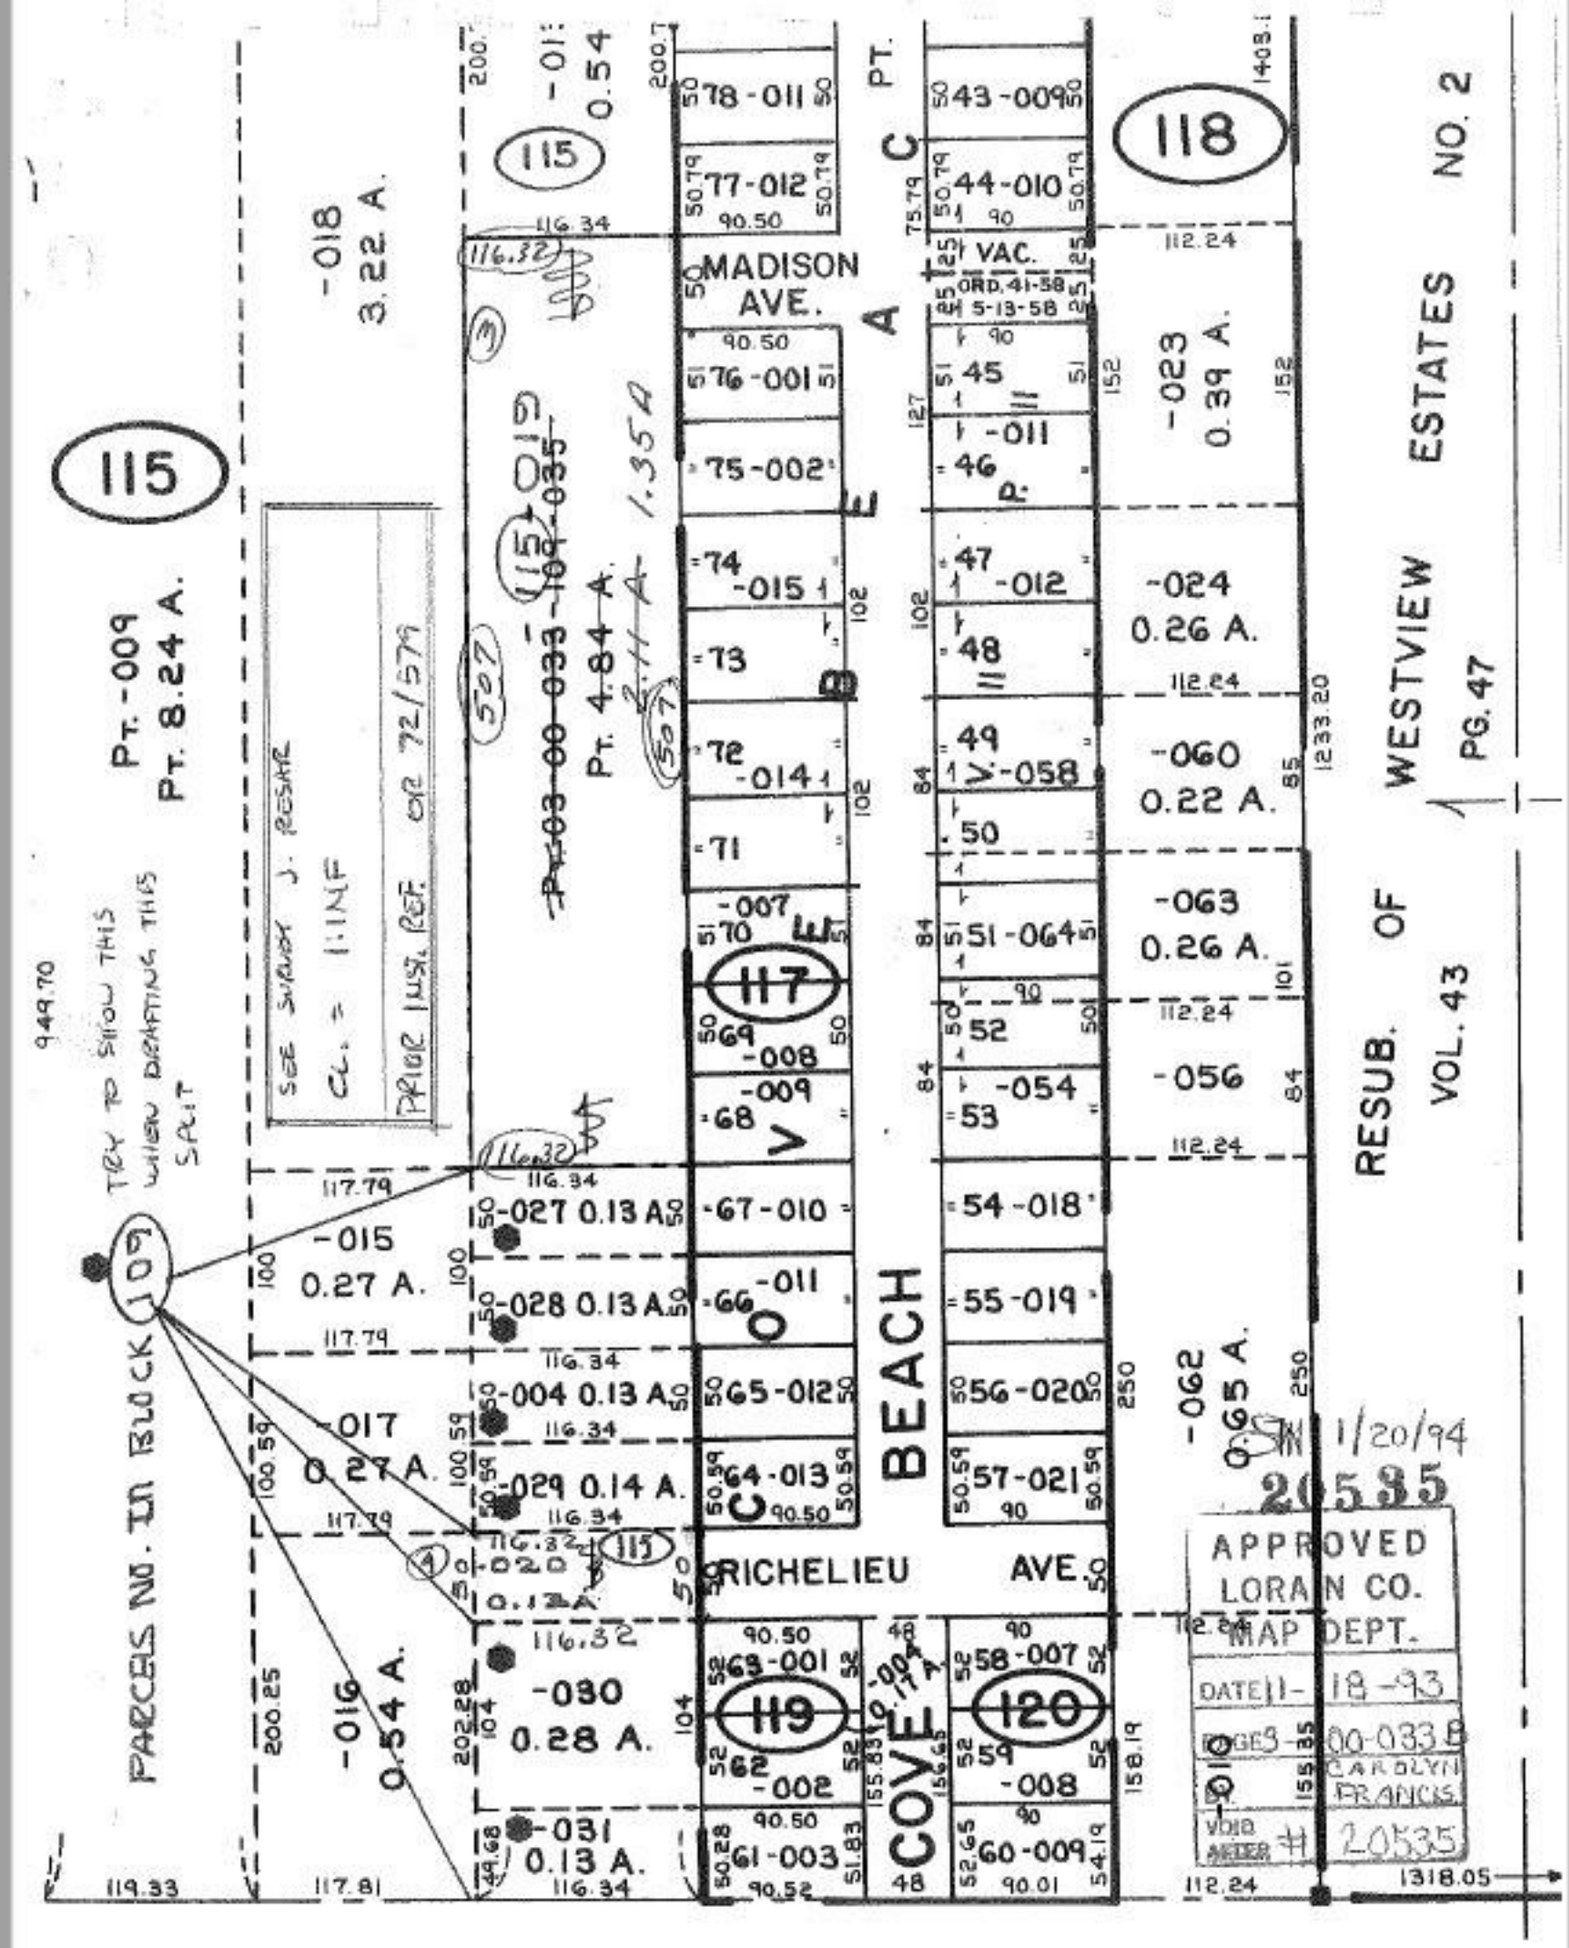

115
118
117
119
120
109
MADISON AVE.
RICHELIEU AVE.
COVE BEACH
RESUB. OF WESTVIEW ESTATES NO. 2
VOL. 43
PG. 47
PARCELS NO. IN BLOCK
TRY TO SHOW THIS WHEN DRAFTING THIS SPLIT
SEE SURVEY J. RESAR
CL. = 1:1NF
PRIOR INST. REF. OR 72/579
-018 3.22 A.
-015 0.27 A.
-017 0.27 A.
-016 0.54 A.
-027 0.13 A.
-028 0.13 A.
-004 0.13 A.
-029 0.14 A.
-030 0.28 A.
-031 0.13 A.
-023 0.39 A.
-024 0.26 A.
-060 0.22 A.
-063 0.26 A.
-056
-062 0.65 A.
VAC.
ORD. 41-58 5-13-58
1/20/94
20535
APPROVED
LORAIN CO.
MAP DEPT.
DATE 11-18-93
PAGES 3-00-033 B
CAROLYN FRANCIS
VOID AFTER # 20535

3-00-033-B