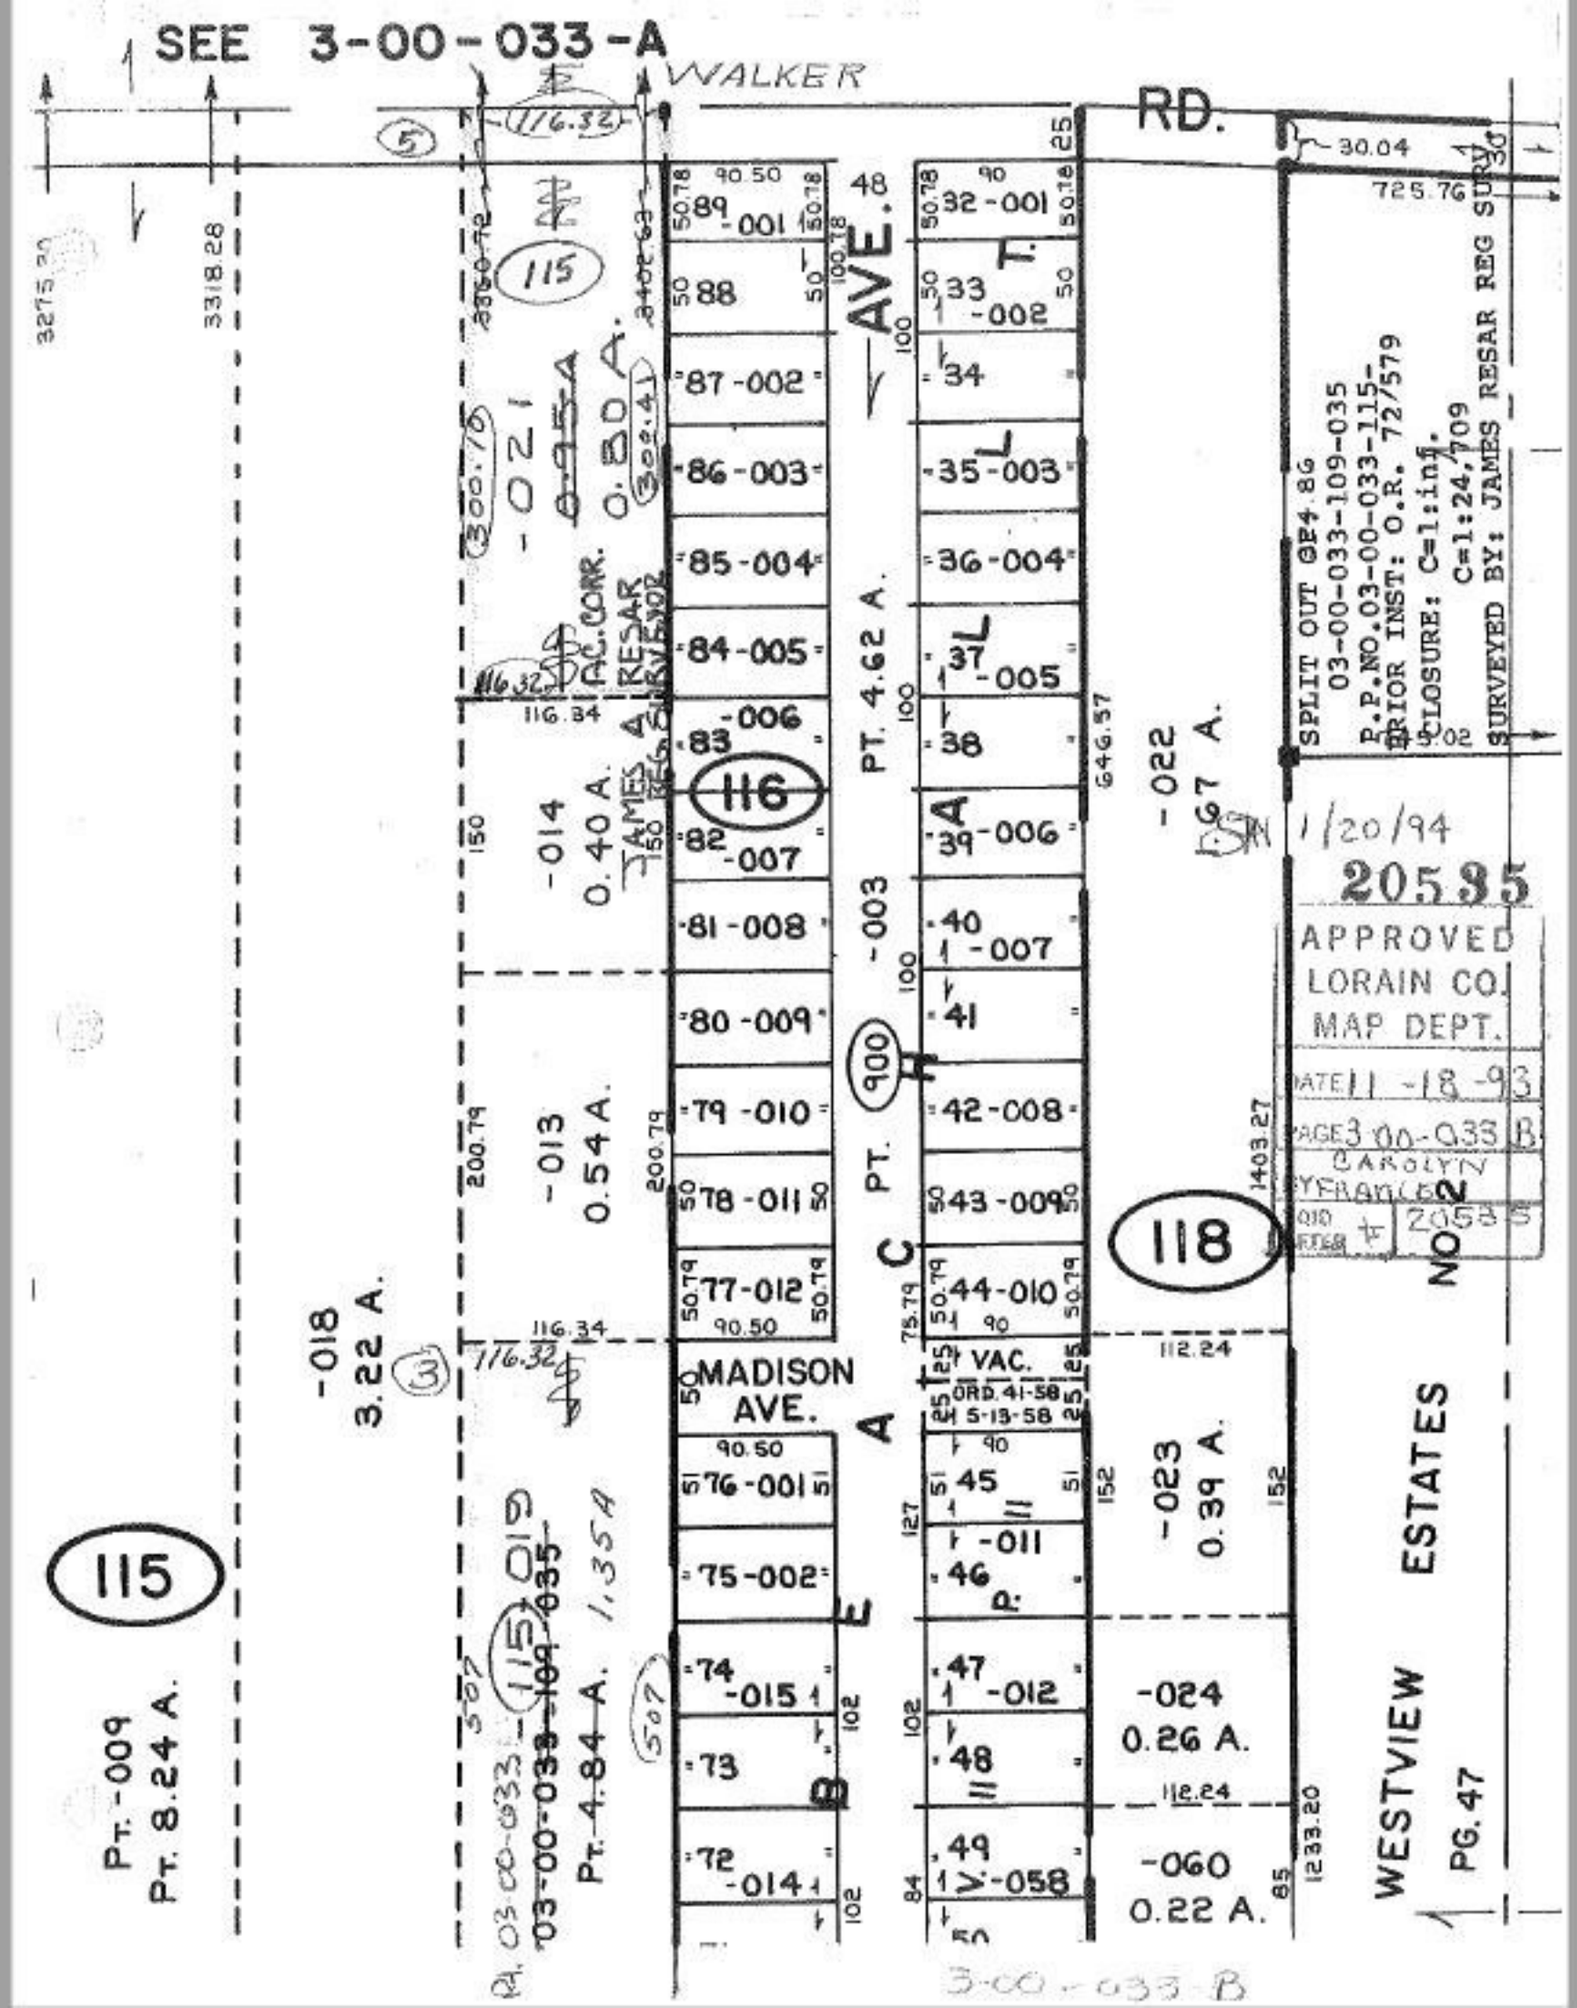
SEE 3-00-033-A
WALKER RD.
MADISON AVE.
WESTVIEW ESTATES NO 2
PG. 47
SPLIT OUT OF 4.86
03-00-033-109-035
P.P.NO.03-00-033-115-
PRIOR INST: O.R. 72/579
CLOSURE: C=1:inf.
C=1:24,709
SURVEYED BY: JAMES RESAR REG SURV.
1/20/94
20535
APPROVED
LORAIN CO.
MAP DEPT.
DATE 11-18-93
PAGE 3-00-033 B
CAROLYN
BY FRANCES
2053 5
PT. 4.62 A.
PT. 4.84 A.
PT. -009
PT. 8.24 A.
-018
3.22 A.
-013
0.54 A.
-014
0.40 A.
-022
0.67 A.
-023
0.39 A.
-024
0.26 A.
-060
0.22 A.
-003
-021
0.80 A.
-015
-019
-035
-011
-058
VAC.
ORD. 41-58
5-13-58
3-00-033-B