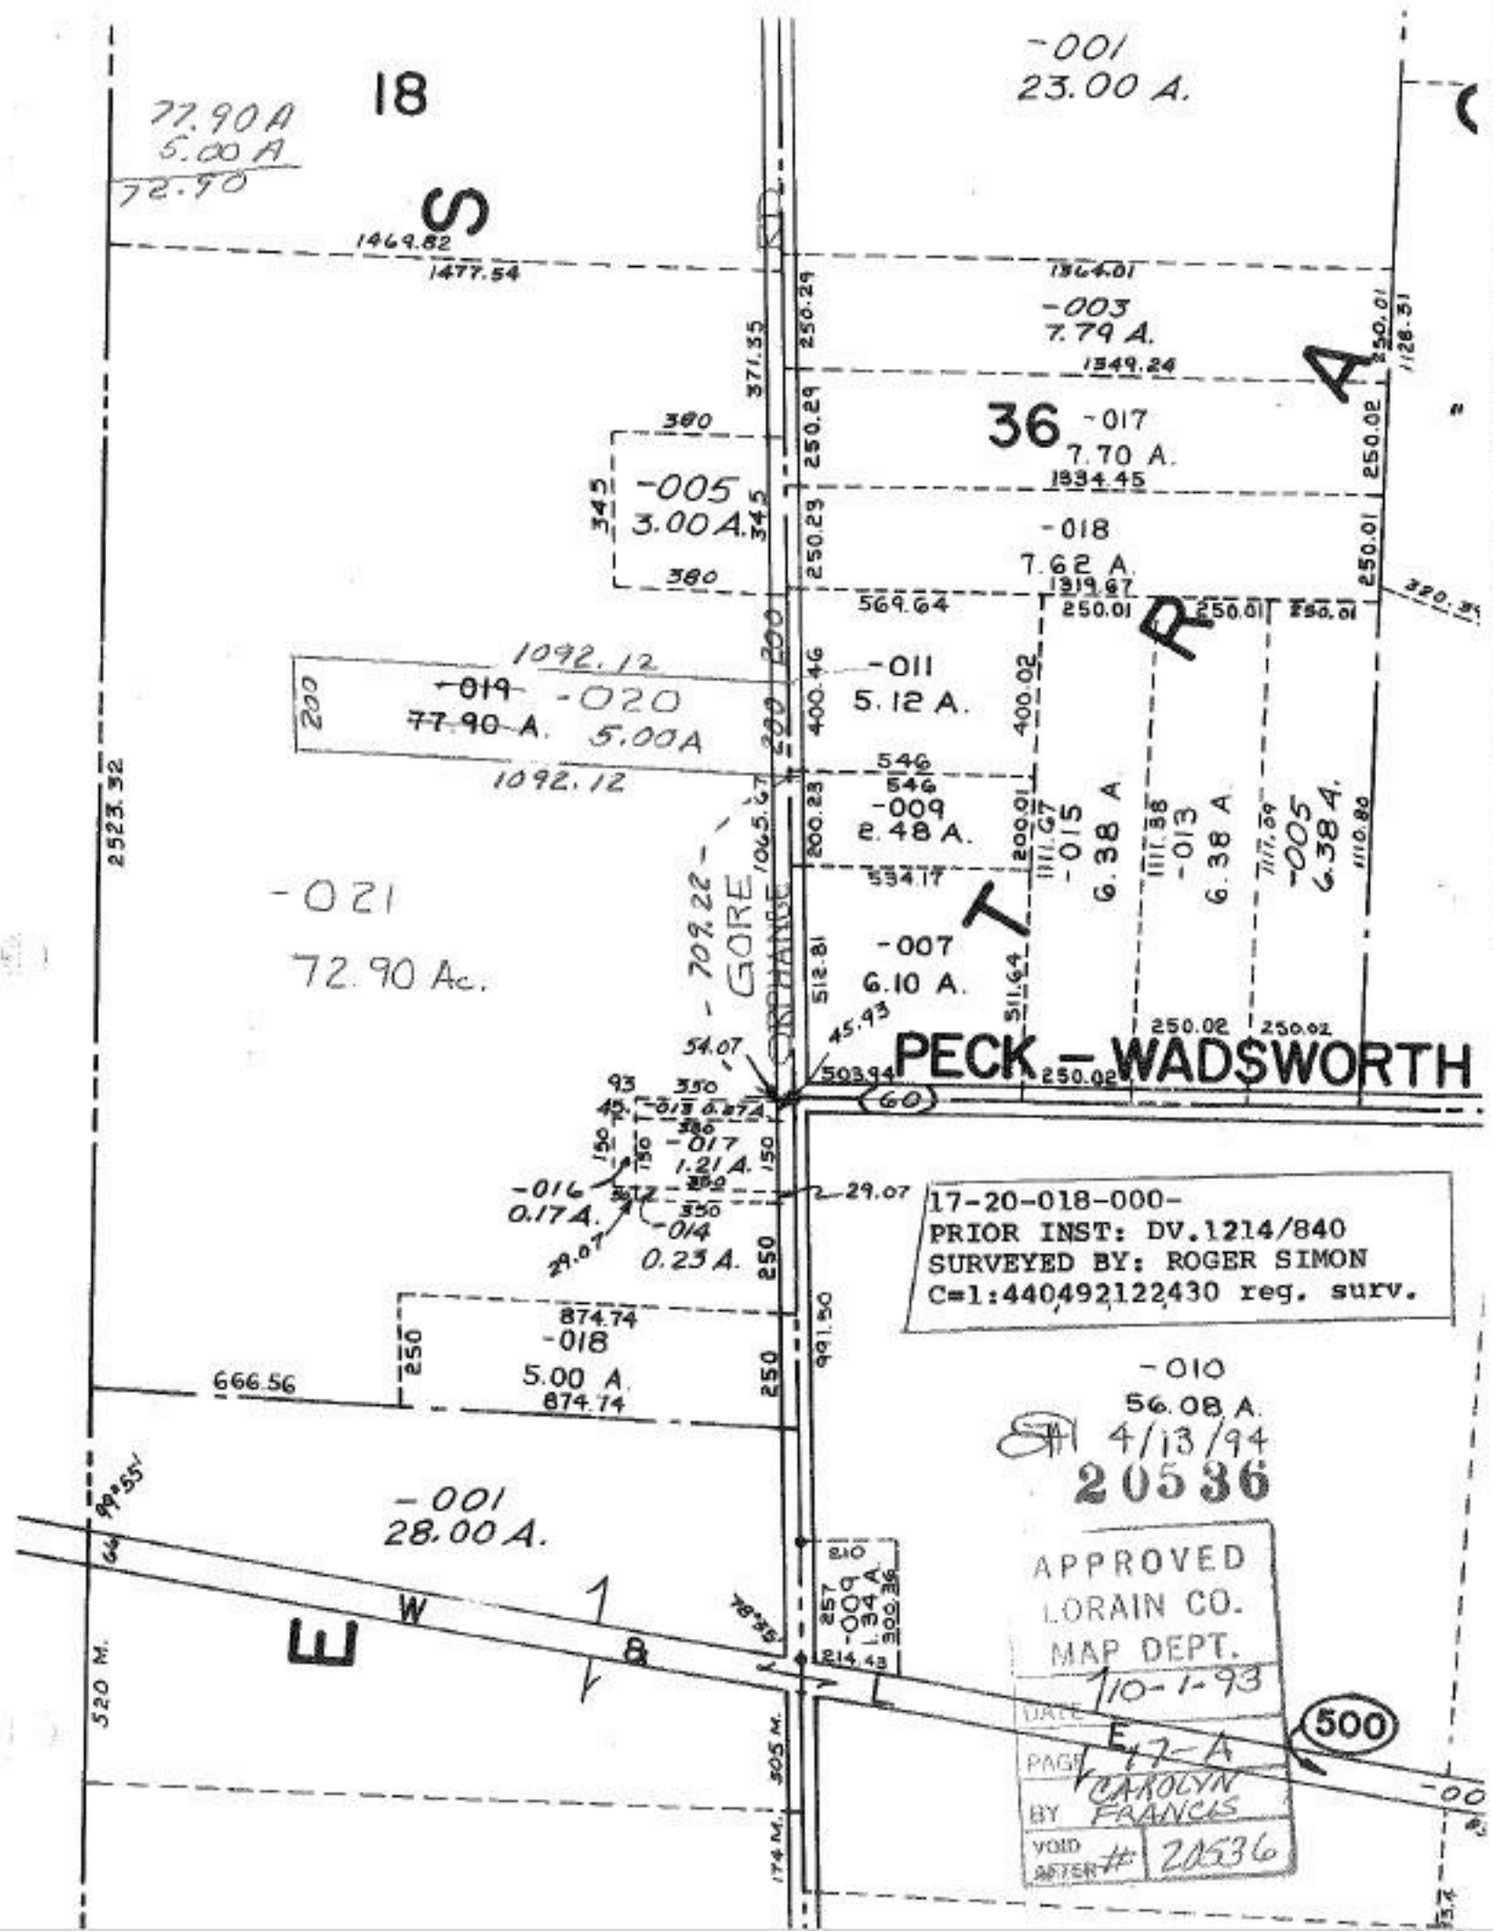
18
77.90A
5.00A
72.90
-001
23.00 A.
-003
7.79 A.
36
-017
7.70 A.
-018
7.62 A.
-005
3.00A.
-011
5.12 A.
-019
-020
77.90 A.
5.00A
-009
2.48 A.
-015
6.38 A
-013
6.38 A
-005
6.384
-007
6.10 A.
-021
72.90 Ac.
-016
0.17A.
-017
1.21 A.
-014
0.23 A.
-018
5.00 A.
-001
28.00 A.
-010
56.08 A.
-004
1.34 A.
PECK — WADSWORTH
GORE ORPHANAGE
17-20-018-000-
PRIOR INST: DV.1214/840
SURVEYED BY: ROGER SIMON
C=1:440492122430 reg. surv.
4/13/94
20536
APPROVED
LORAIN CO.
MAP DEPT.
10-1-93
DATE
PAGE E7-A
BY CAROLYN FRANCIS
VOID AFTER # 20536
E W 1 B
500
60