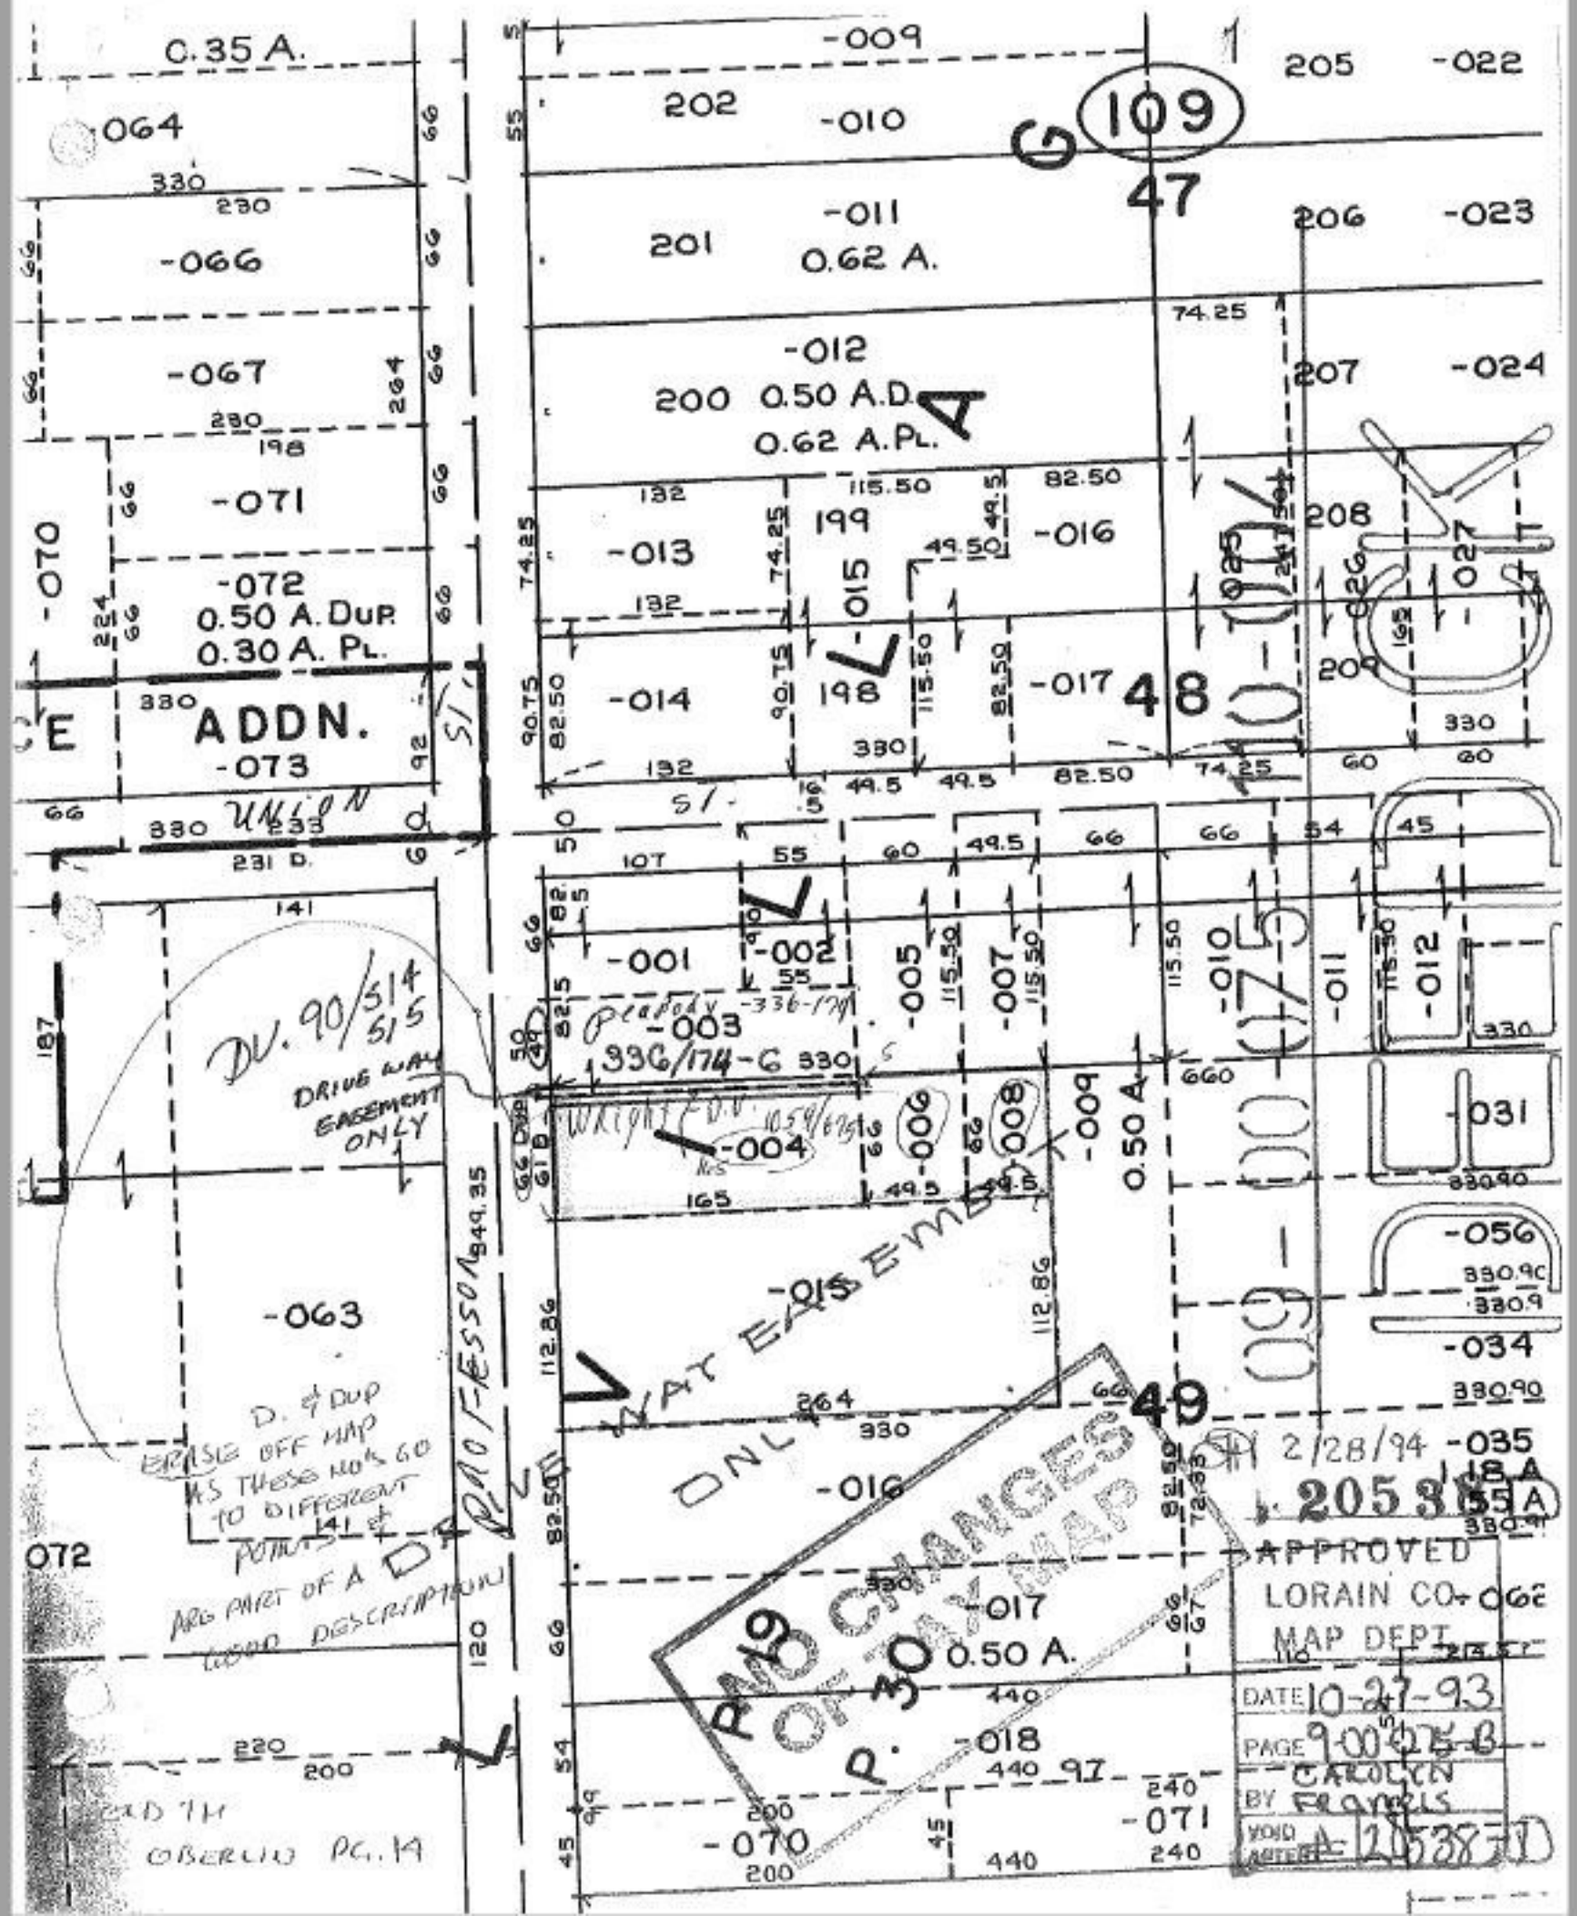

0.35 A.
-064
-066
-067
-071
-070
-072
0.50 A. DUP.
0.30 A. PL.
ADDN.
-073
UNION
-063
-009
202
-010
-011
201
0.62 A.
-012
200 0.50 A.D.
0.62 A.PL.
-013
199
-015
-016
-014
198
-017
205
-022
206
-023
207
-024
208
209
-027
-001
-002
-003
-004
-005
-006
-007
-008
-009
0.50 A.
-010
-011
-012
-031
-056
-034
-035
-016
-017
0.50 A.
-018
-070
-071
-062
DV. 90/514
515
DRIVE WAY EASEMENT ONLY
PROFESSOR
DRIVE WAY EASEMENT ONLY
D. & DUP ERASE OFF MAP AS THESE NO'S GO TO DIFFERENT POINTS & ARE PART OF A GOOD DESCRIPTION
OBERLIN PG. 14
NO CHANGES OF TAX MAP
2/28/94
APPROVED
LORAIN CO.
MAP DEPT.
DATE 10-27-93
PAGE 9-00-075-B
BY CAROLYN FRANCIS
VOID AFTER