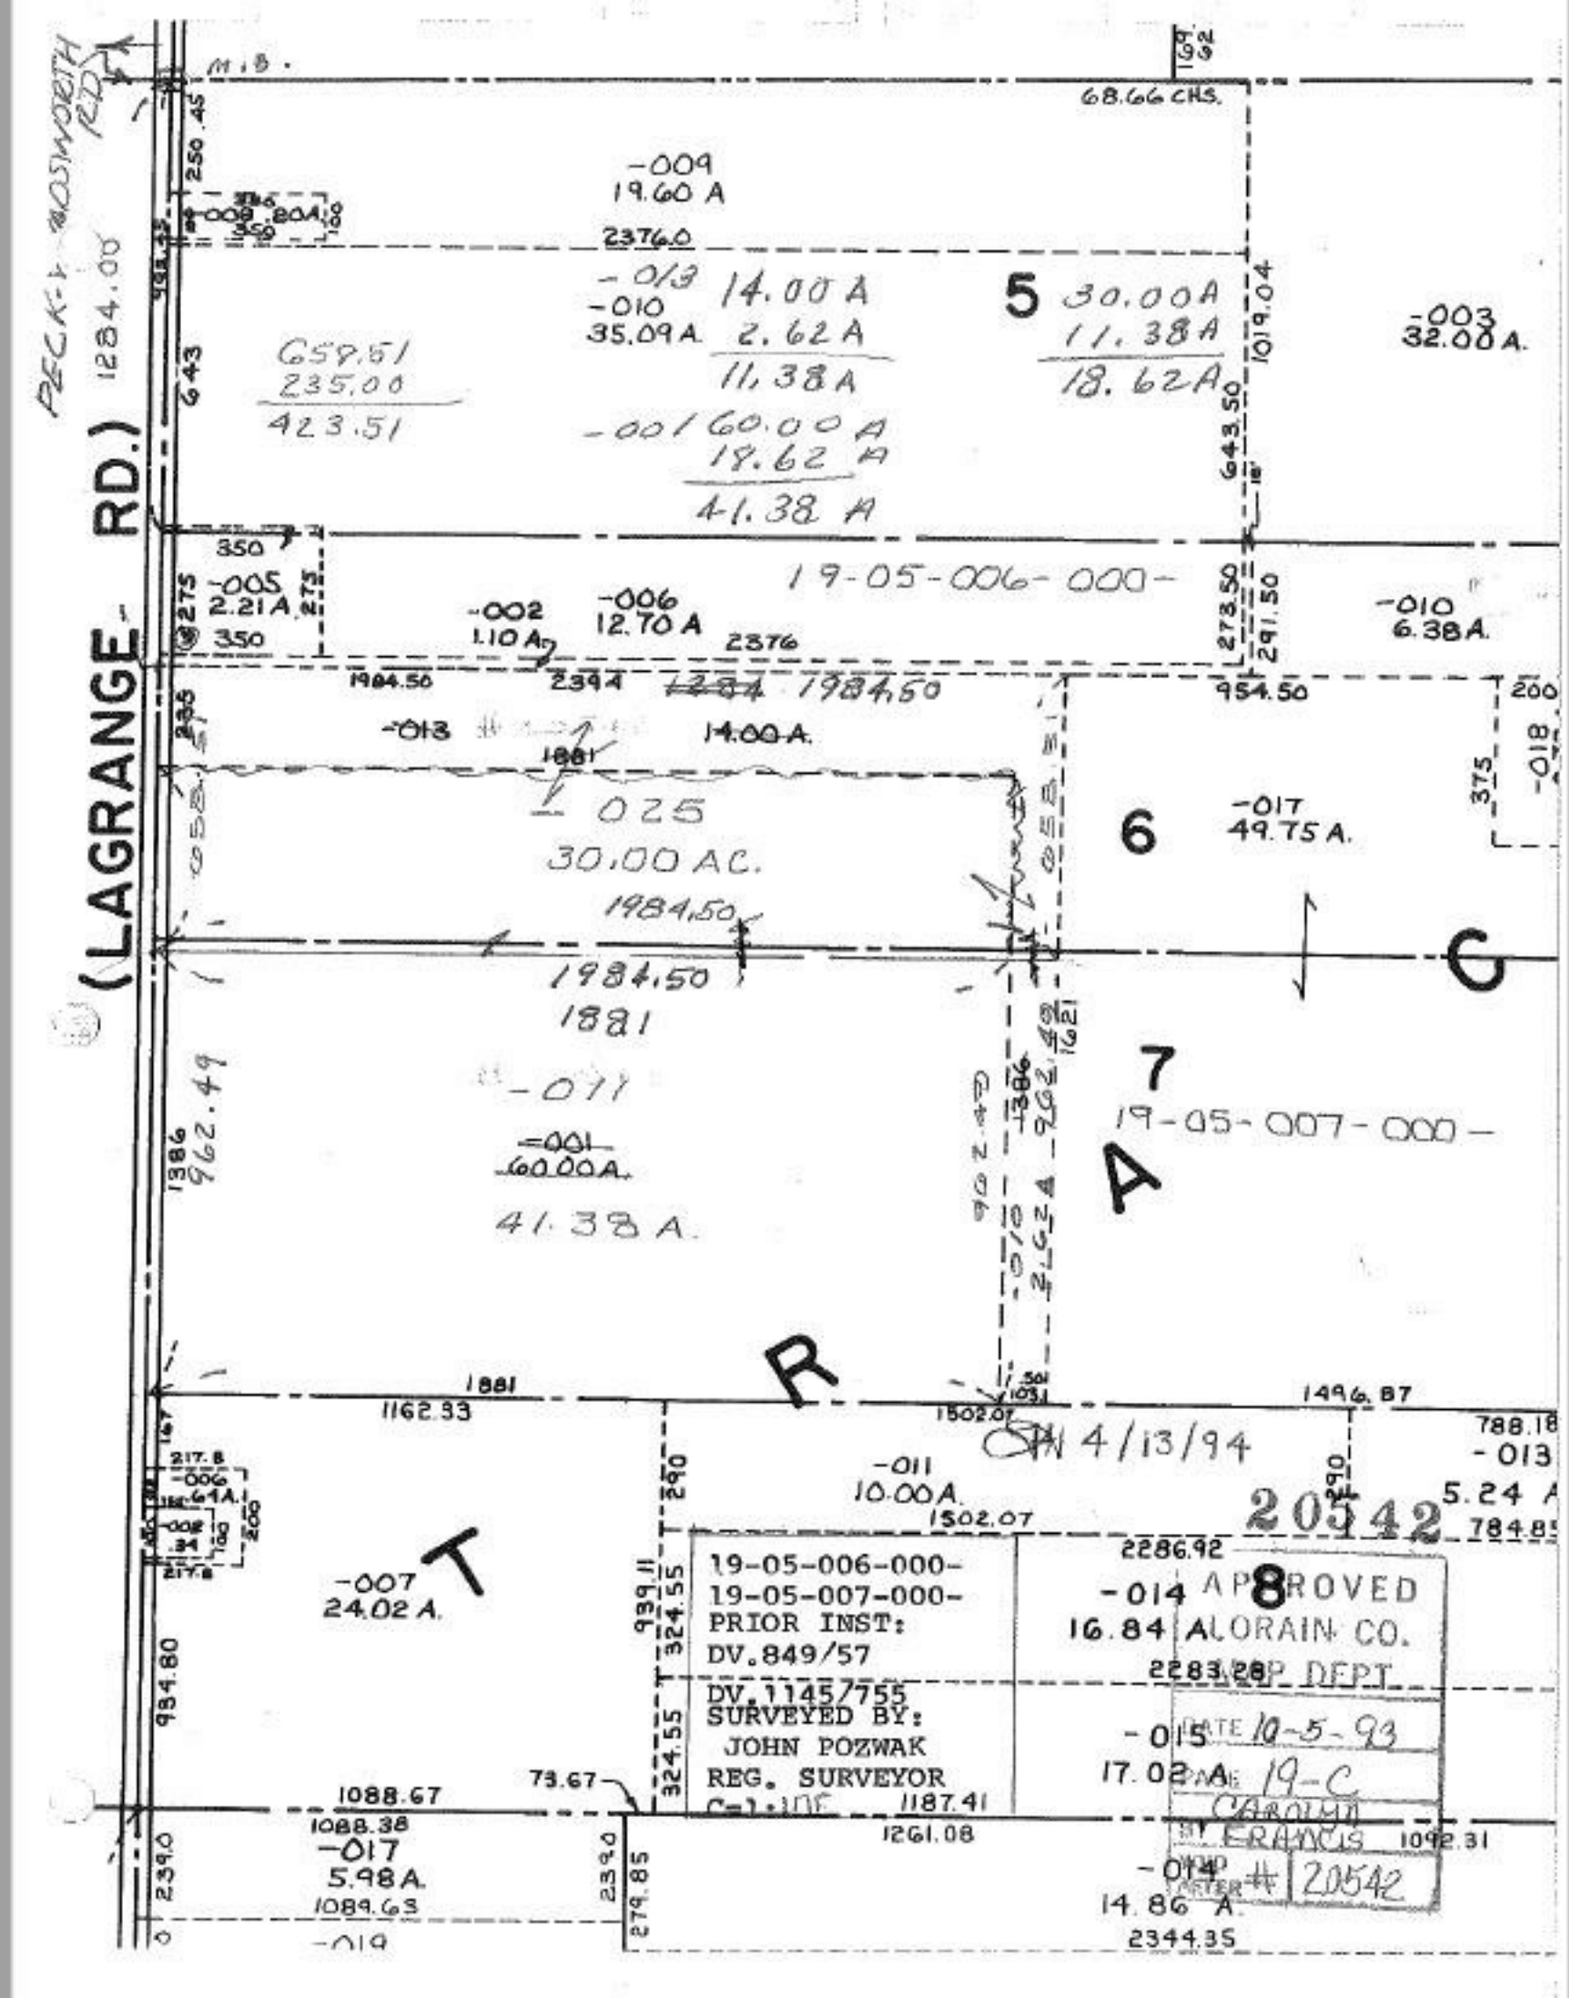

PECK-Y MOSWORTH RD
(LAGRANGE RD.)
68.66 CHS.
-009
19.60 A
2376.0
-013
-010
35.09 A
14.00 A
2.62 A
11.38 A
5
30.00 A
11.38 A
18.62 A
-003
32.00 A.
659.51
235.00
423.51
-001 60.00 A
18.62 A
41.38 A
19-05-006-000-
-005
2.21 A
-002
1.10 A
-006
12.70 A
-010
6.38 A.
1984.50
2394
1984.50
-013
14.00 A.
-025
30.00 AC.
1984.50
6
-017
49.75 A.
1984.50
1881
-011
-001
60.00 A.
41.38 A.
7
19-05-007-000-
1386
962.49
1881
1162.33
1496.87
-011
10.00 A.
1502.07
4/13/94
-013
5.24 A
784.85
20542
-007
24.02 A.
19-05-006-000-
19-05-007-000-
PRIOR INST:
DV.849/57
DV.1145/755
SURVEYED BY:
JOHN POZWAK
REG. SURVEYOR
2286.92
-014
16.84 A
8
APPROVED
LORAIN CO.
DEPT
DATE 10-5-93
PAGE 19-C
CAROLYN
ST FRANCIS
#20542
-015
17.02 A
1088.67
1088.38
-017
5.98 A.
1089.63
-019
1187.41
1261.08
1092.31
-014
14.86 A
2344.35