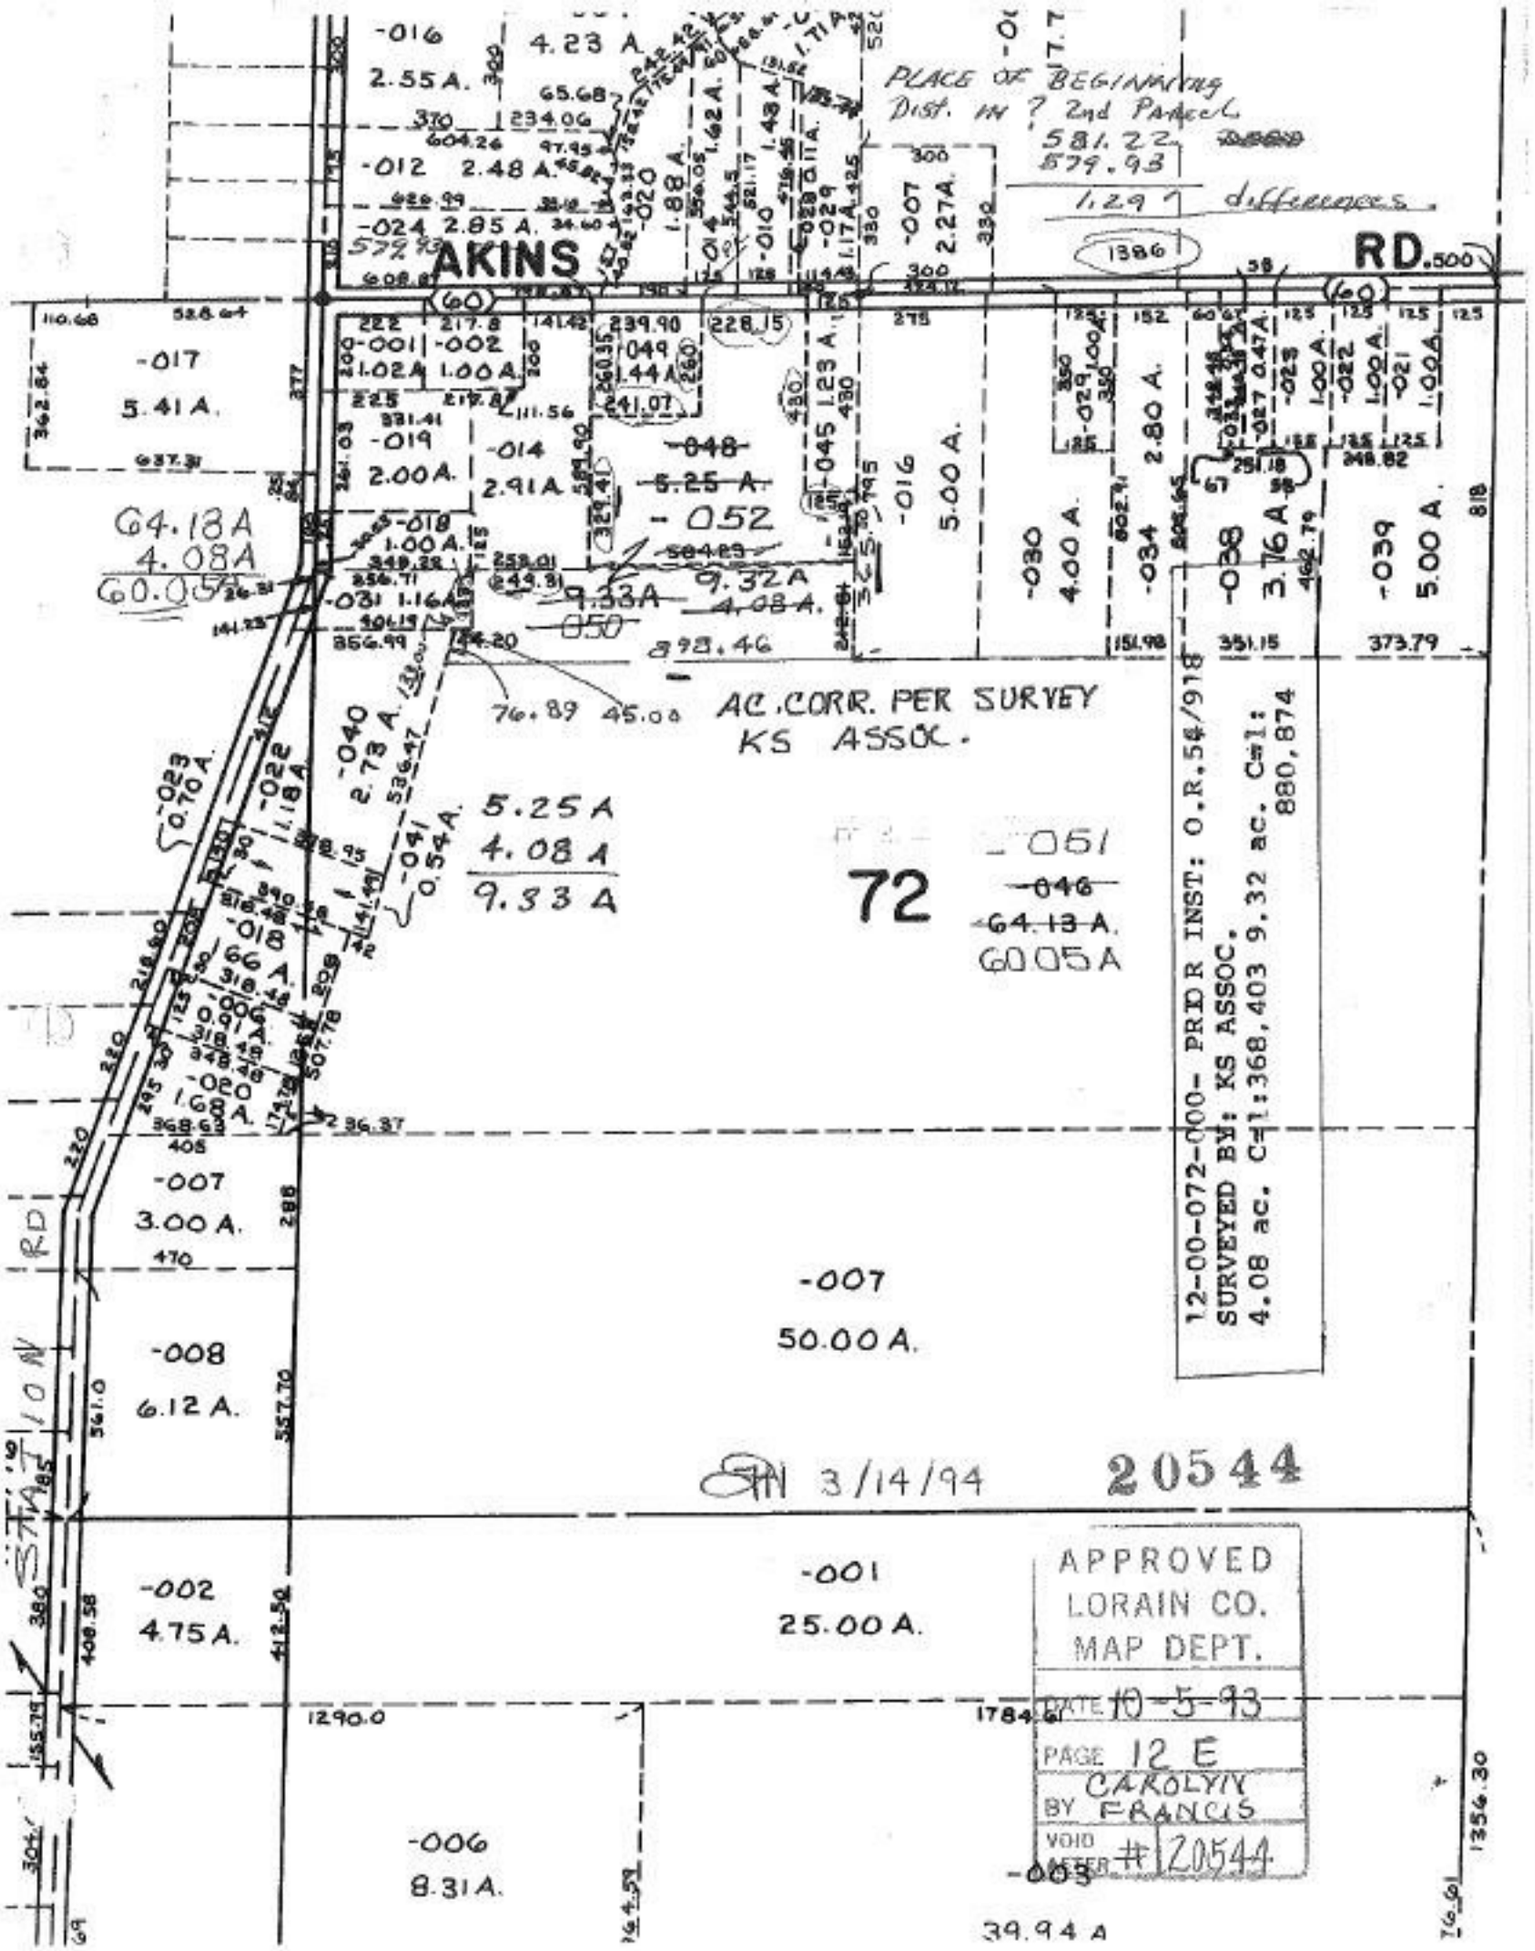
AKINS RD.
PLACE OF BEGINNING
Dist. in ? 2nd Parcel
581.22
579.93
1.29 ? differences
-017
5.41 A.
64.18 A
4.08 A
60.05 A
-052
9.32 A
4.08 A.
-050
5.25 A
4.08 A
9.33 A
AC. CORR. PER SURVEY
KS ASSOC.
72
-051
-046
64.13 A.
60.05 A
-007
50.00 A.
-008
6.12 A.
-007
3.00 A.
-002
4.75 A.
-001
25.00 A.
-006
8.31 A.
-003
39.94 A
STATION RD
12-00-072-000- PRIOR INST: O.R.56/918
SURVEYED BY: KS ASSOC.
4.08 ac. C=1:368,403 9.32 ac. C=1:
880,874
3/14/94
20544
APPROVED
LORAIN CO.
MAP DEPT.
DATE 10-5-93
PAGE 12 E
BY CAROLYN FRANCIS
VOID NUMBER #20544