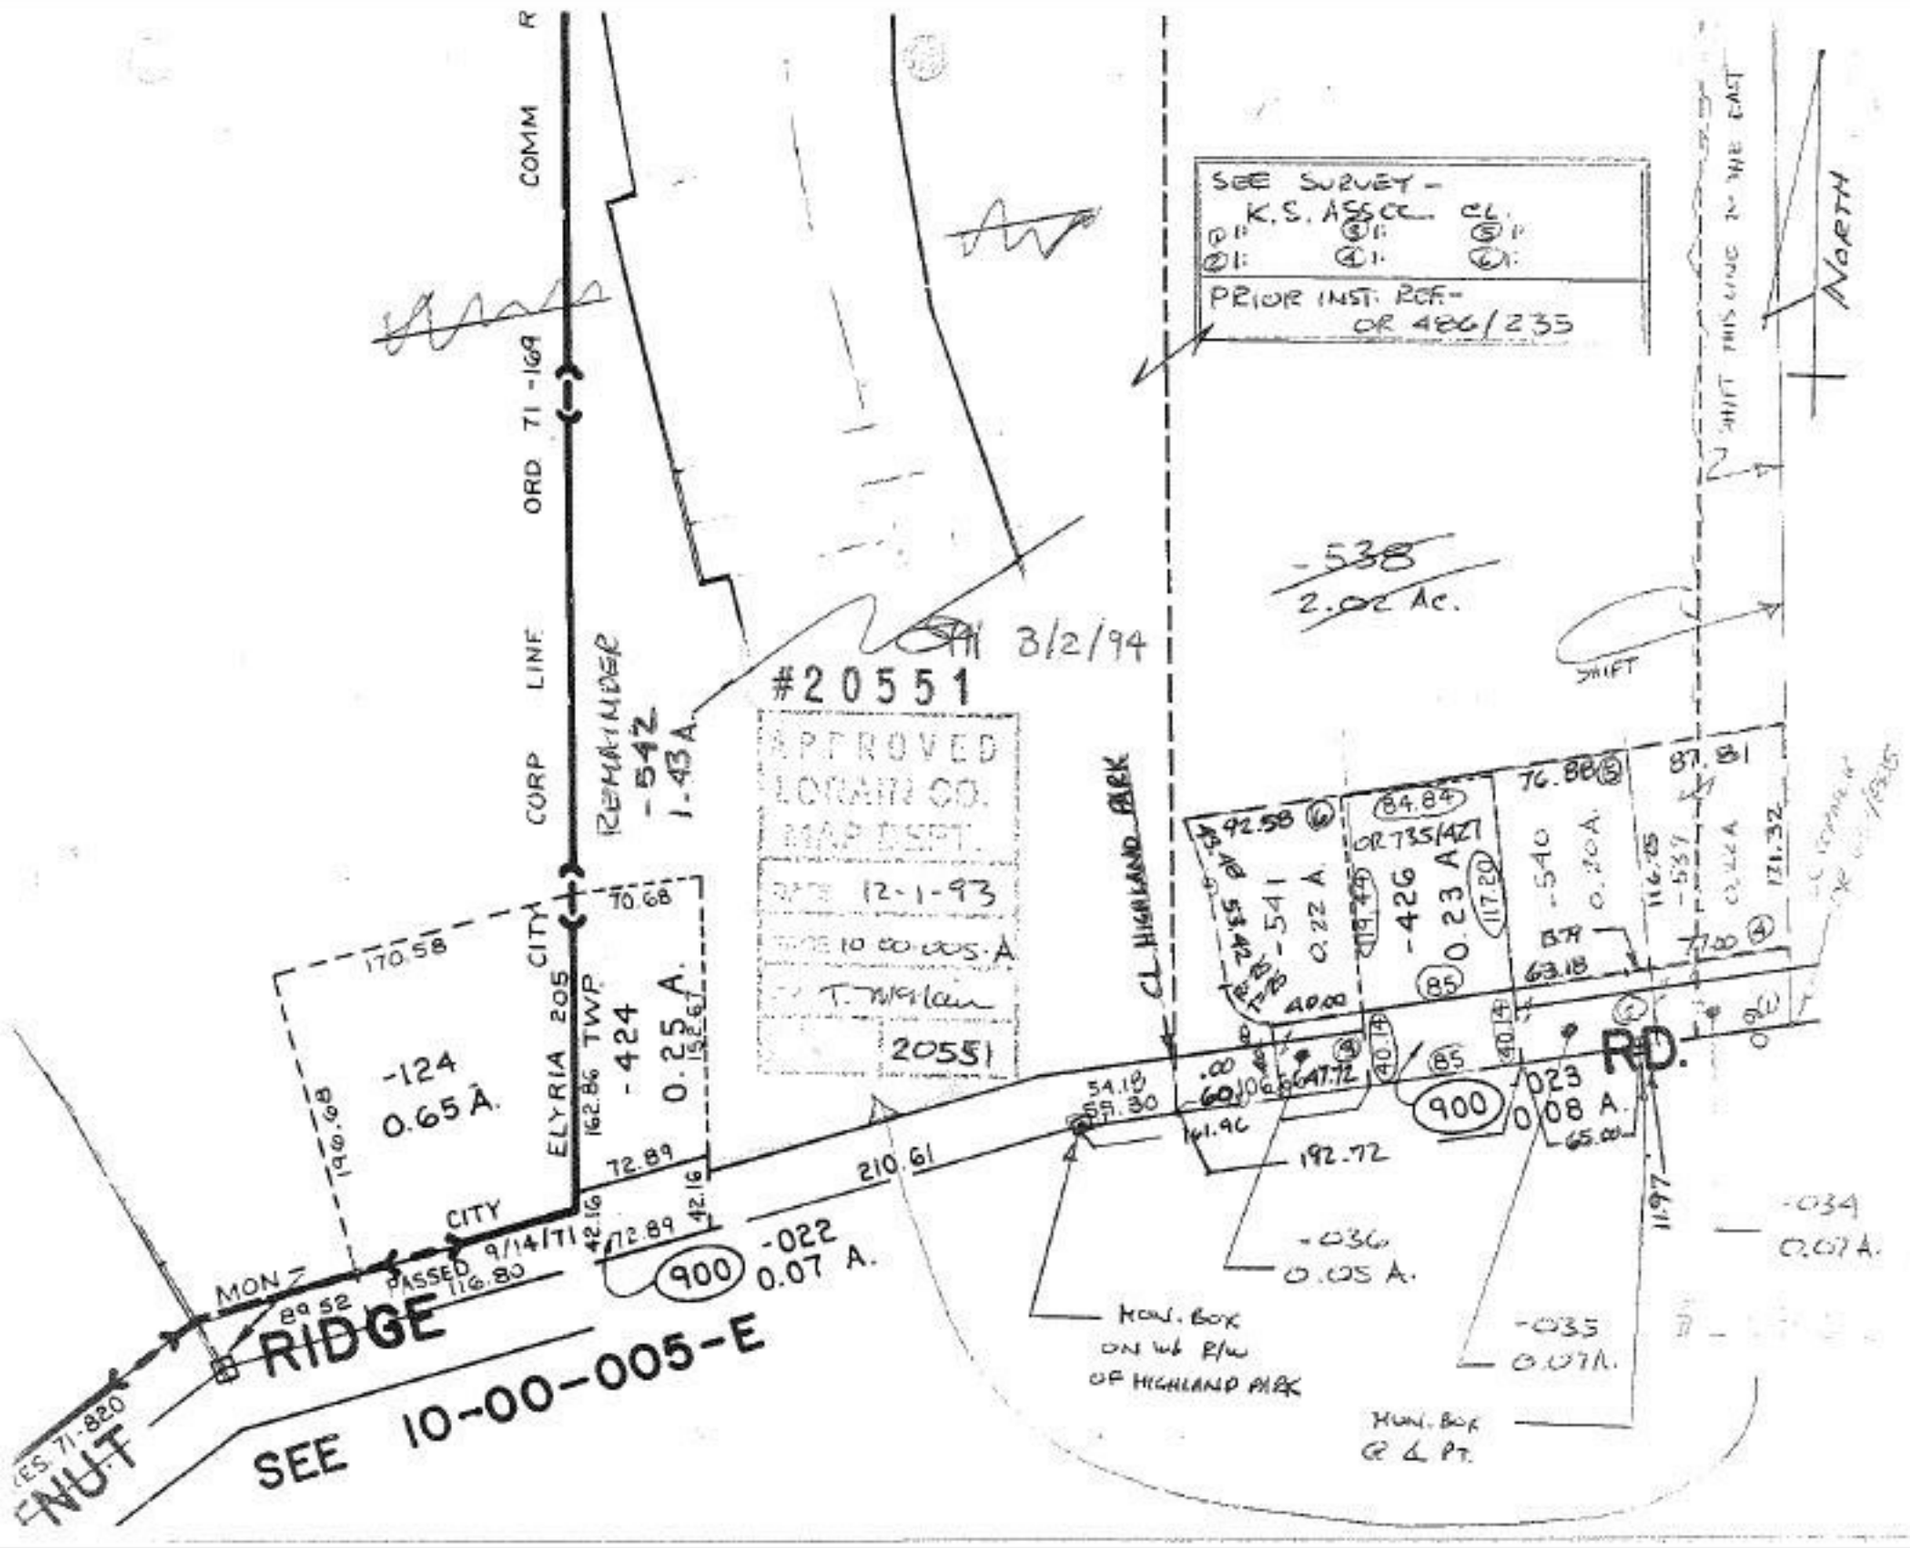
SEE SURVEY -
K.S. ASSOC.
PRIOR INST. REF-
OR 486/235
-538
2.02 Ac.
3/2/94
#20551
APPROVED
MAP DEPT.
12-1-93
20551
NORTH
SHIFT THIS LINE 2' TO THE EAST
SHIFT
COMM
ORD 71-169
CORP LINE
REMAINDER
-542
1.43 A.
CITY
ELYRIA 205
TWP
-424
0.25 A.
-124
0.65 A.
-541
0.22 A.
-426
0.23 A.
-540
0.20 A.
-539
0.22 A.
CL HIGHLAND PARK
RD.
900
-023
0.08 A.
-022
0.07 A.
-036
0.05 A.
-034
0.07 A.
-035
0.07 A.
MON.
RIDGE
CITY
PASSED
9/14/71
MON. BOX
ON W'LY R/W
OF HIGHLAND PARK
MON. BOX
@ L PT.
SEE 10-00-005-E
NUT