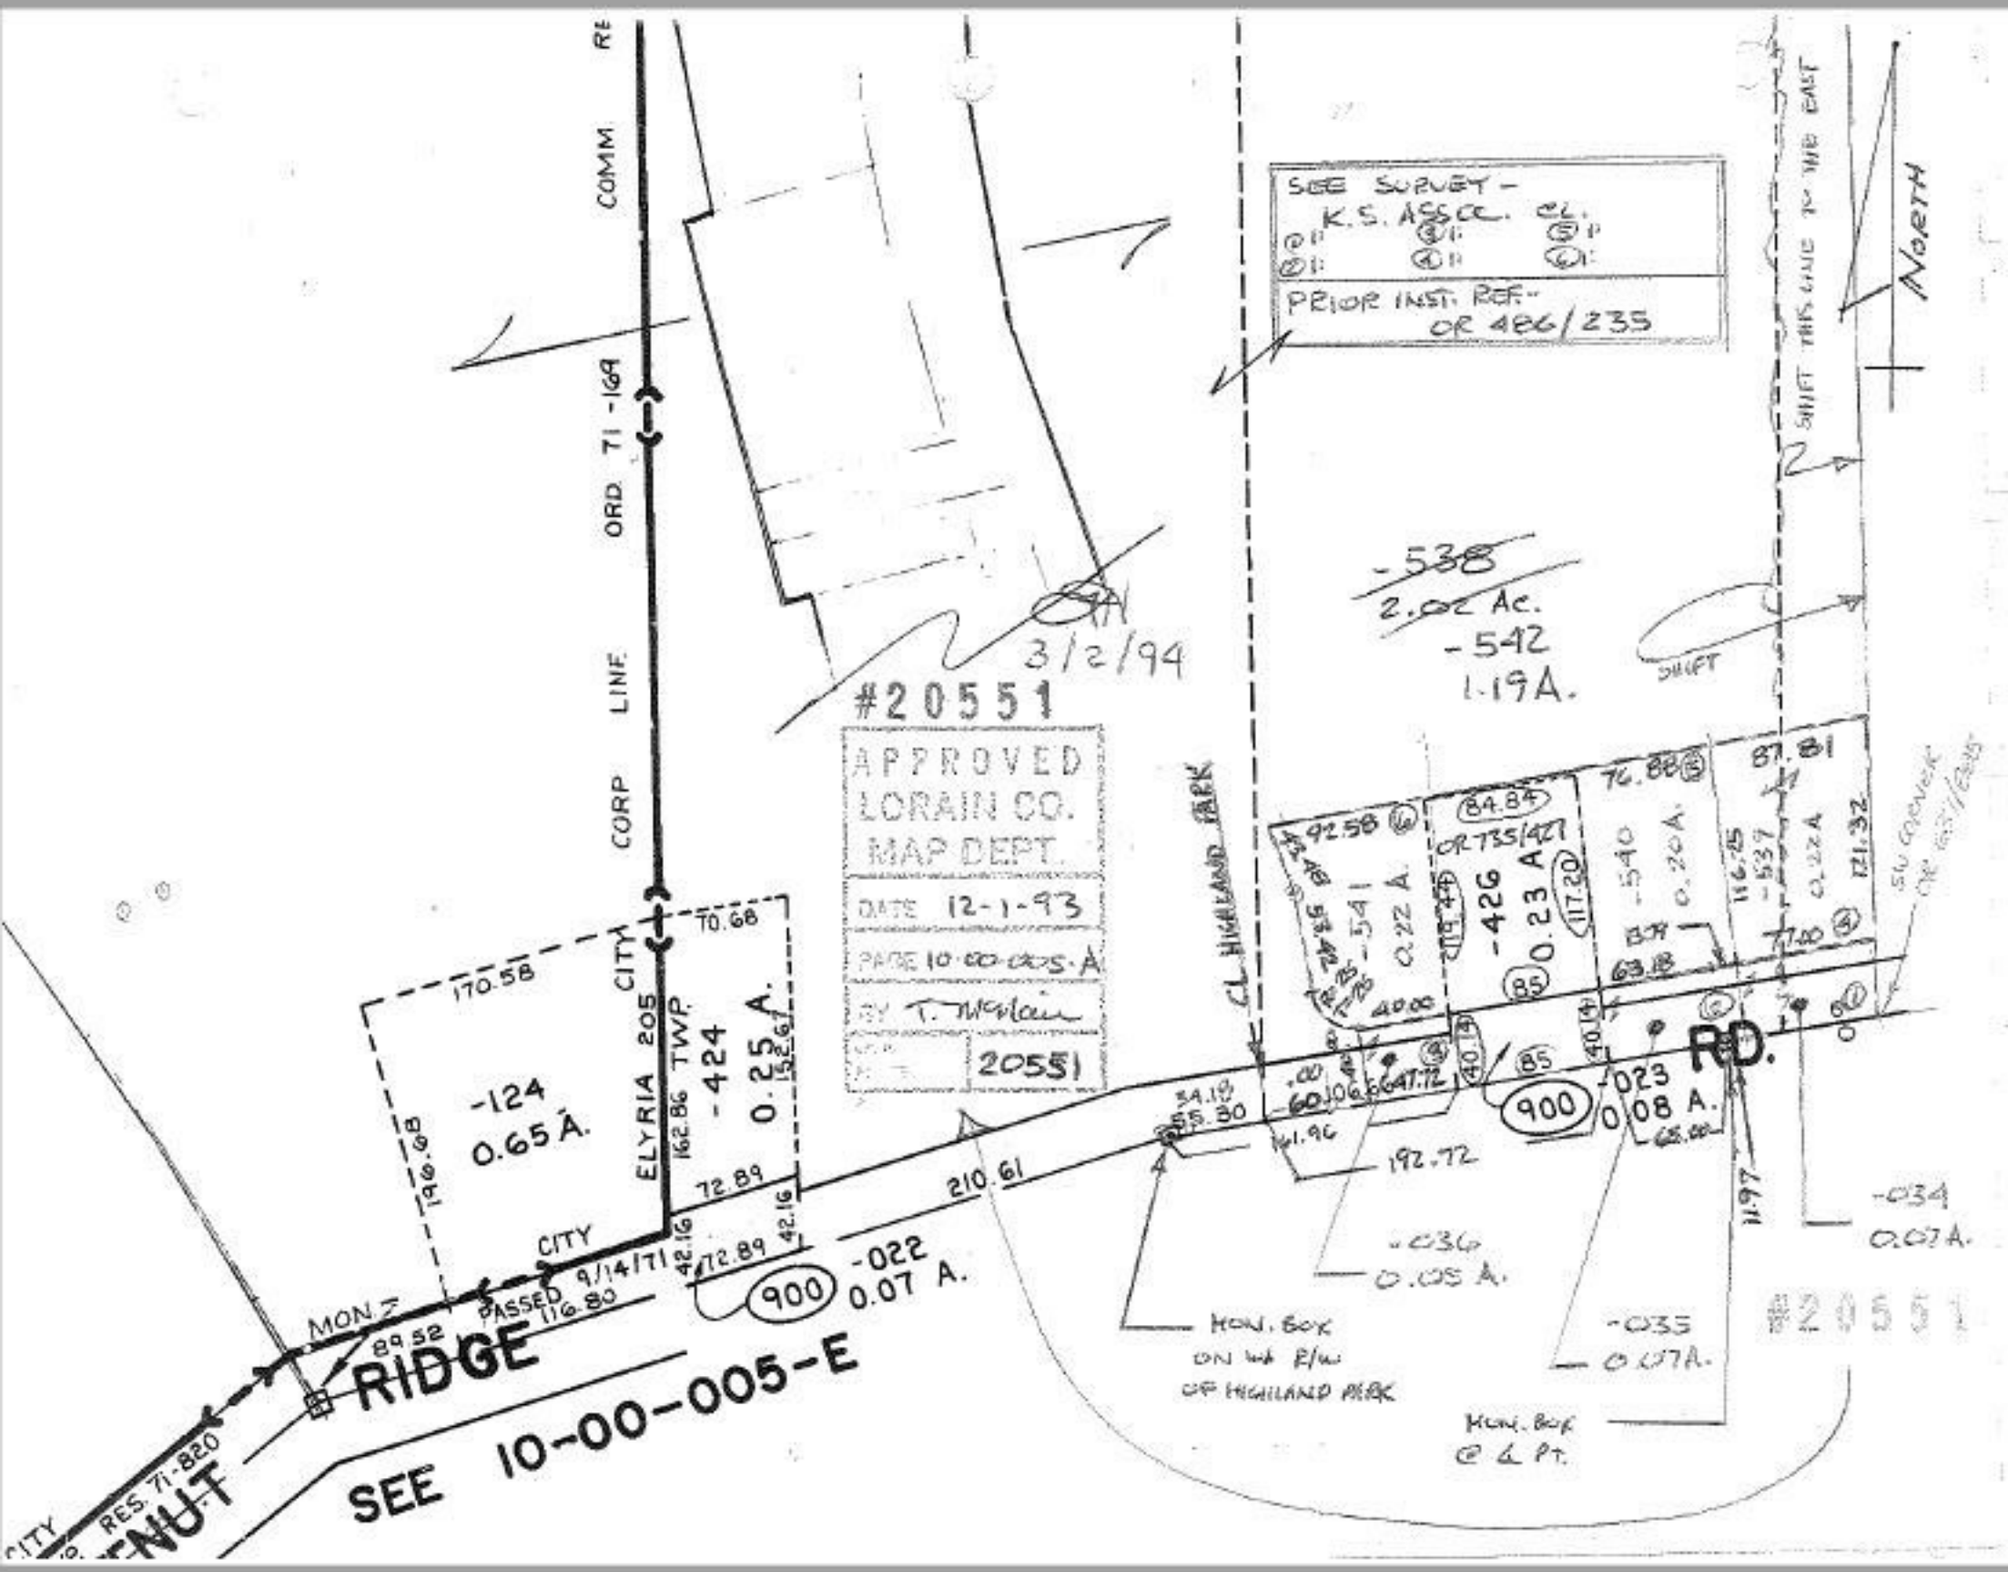

SEE SURVEY -
K.S. ASSOC. CL.
PRIOR INST. REF.-
OR 486/235
NORTH
SHIFT THIS LINE TO THE EAST
SHIFT
-538
2.02 Ac.
-542
1.19A.
3/2/94
#20551
APPROVED
LORAIN CO.
MAP DEPT.
DATE 12-1-93
PAGE 10-00-005-A
BY T. McClain
20551
CORP LINE ORD 71-169 COMM RE
CITY
ELYRIA 205 TWP.
-124
0.65 A.
-424
0.25 A.
-426
0.23 A
-541
0.22 A.
-540
0.20 A.
-539
0.22 A
-023
0.08 A.
-022
0.07 A.
-036
0.05 A.
-035
0.07A.
-034
0.07A.
900
RD.
CL HIGHLAND PARK
MON. BOX
ON WA R/W
OF HIGHLAND PARK
MON. BOX
@ 4 PT.
MON.
PASSED 9/14/71
RIDGE
SEE 10-00-005-E
RES. 71-820
#20551