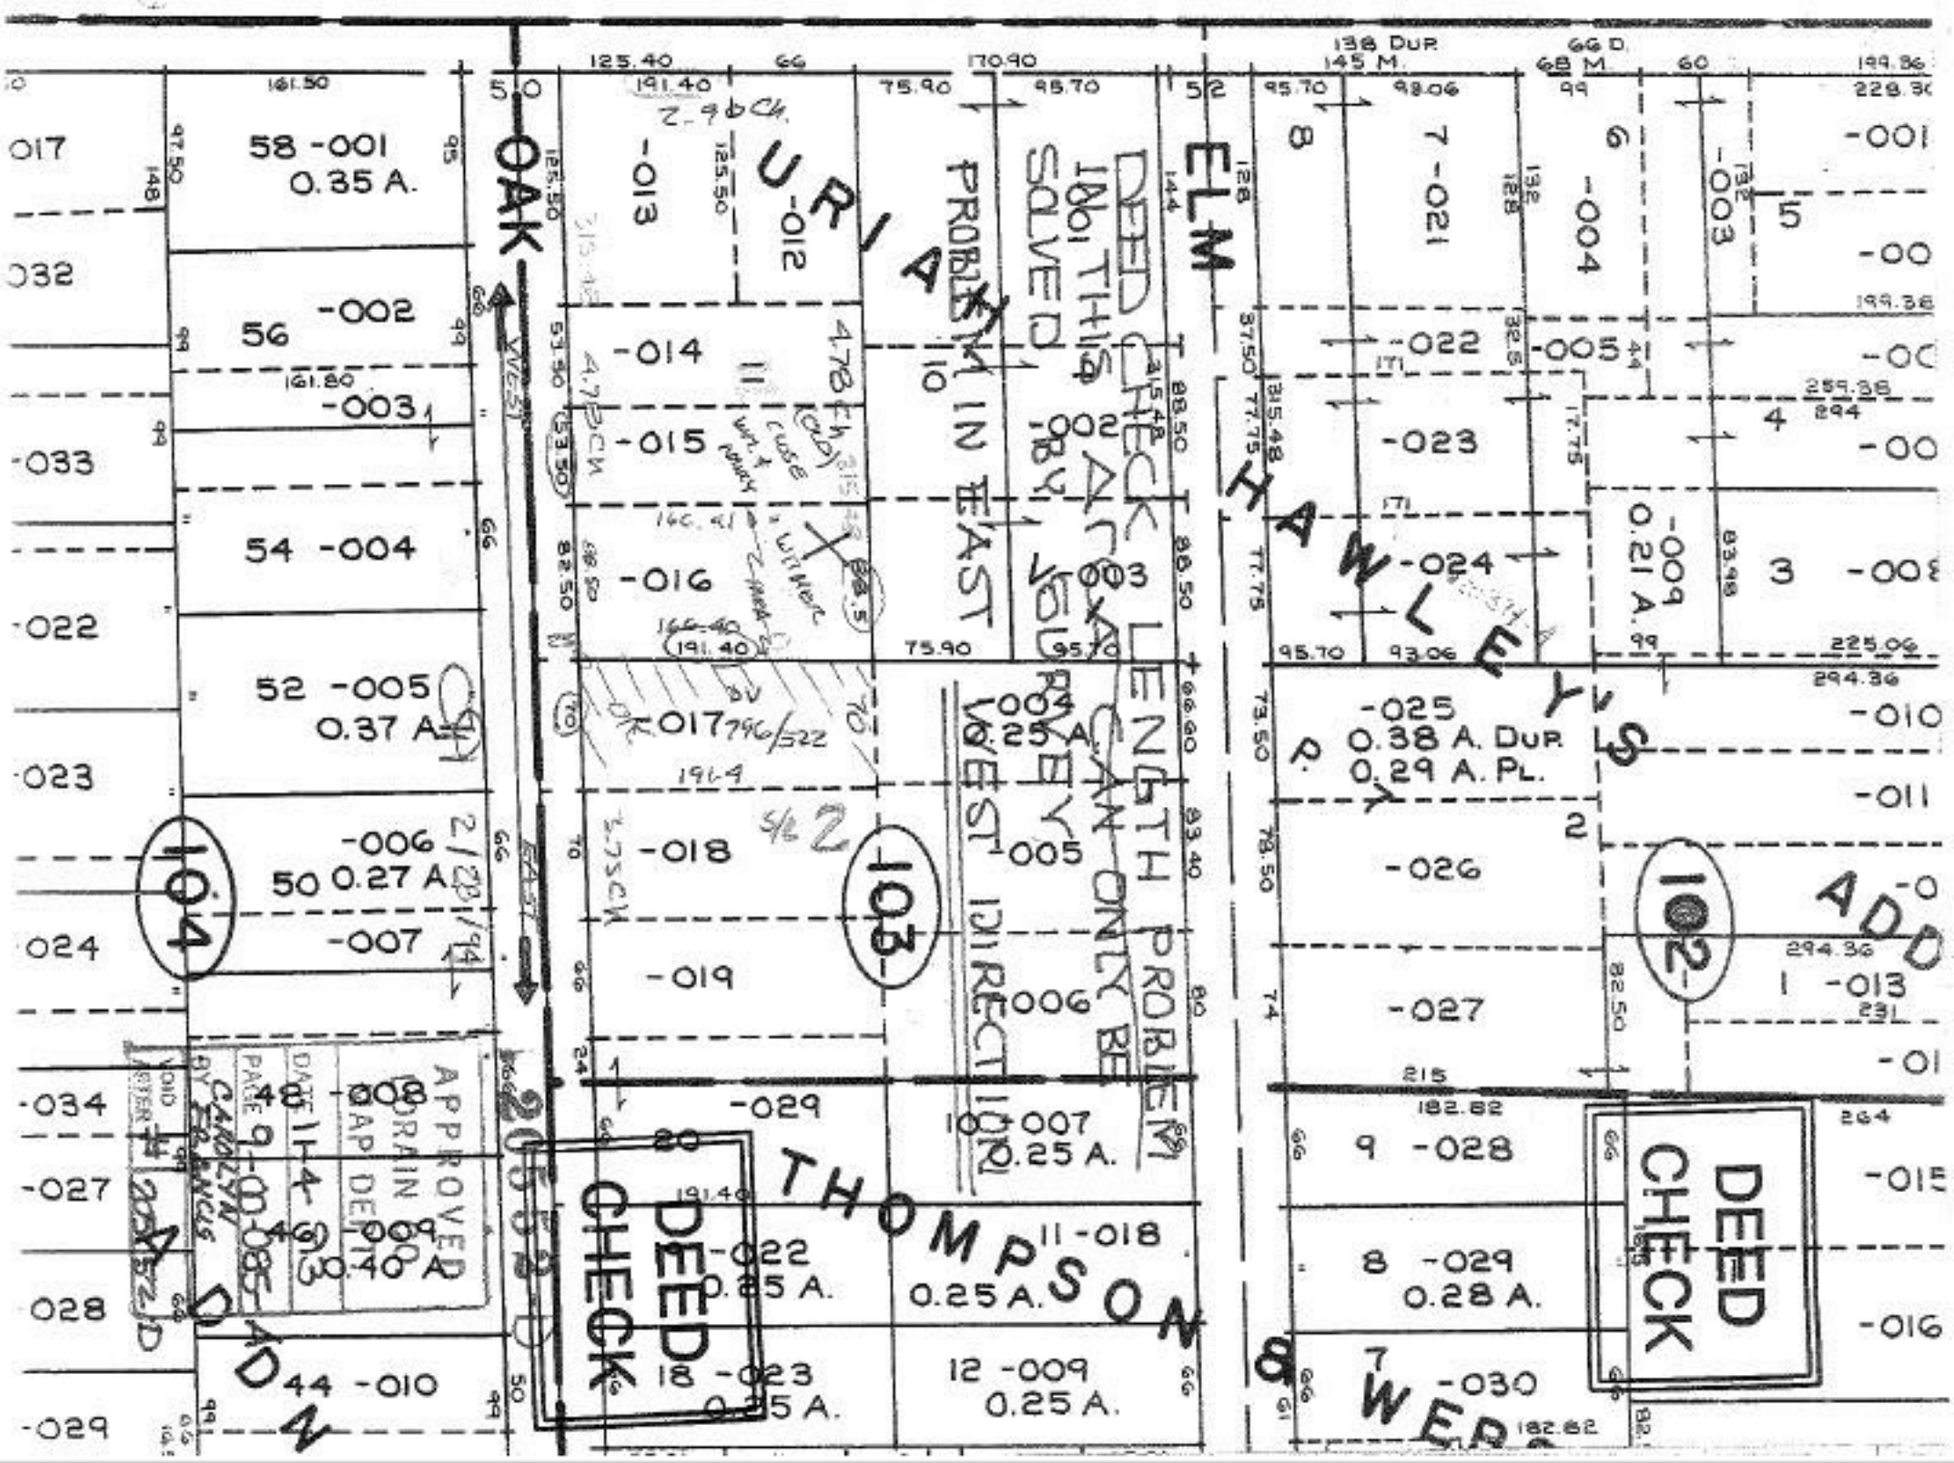
PROSPECT
SEE 9-00-084-B
OAK
URIAH
ELM
HAWLEY'S
THOMPSON & WEBB
ADDN
DEED CHECK
DEED CHECK
DEED CHECK
PROBLEM IN EAST
DEED CHECK LENGTH PROBLEM
1001 THIS AREA CAN ONLY BE SOLVED BY SURVEY
WEST DIRECTION
APPROVED DRAIN CO. MAP DEPT.
DATE 11-4-93
PAGE 9-00-085-A
BY CAROLYN FRANCIS
VOID AFTER
58 -001
0.35 A.
56 -002
-003
54 -004
52 -005
0.37 A.
50 -006
0.27 A.
-007
48 -008
46 -009
0.40 A.
44 -010
-013
-012
-014
-015
-016
-017
-018
-019
-029
-022
0.25 A.
18 -023
0.25 A.
-002
-003
-004
0.25 A.
-005
-006
10 -007
0.25 A.
11 -018
0.25 A.
12 -009
0.25 A.
8
7 -021
6
-004
-003
5
-022
-005
-023
-024
-009
0.21 A.
3
-025
0.38 A. DUP.
0.29 A. PL.
-026
-027
9 -028
8 -029
0.28 A.
7 -030
-001
-010
-011
-013
-015
-016
104
103
102