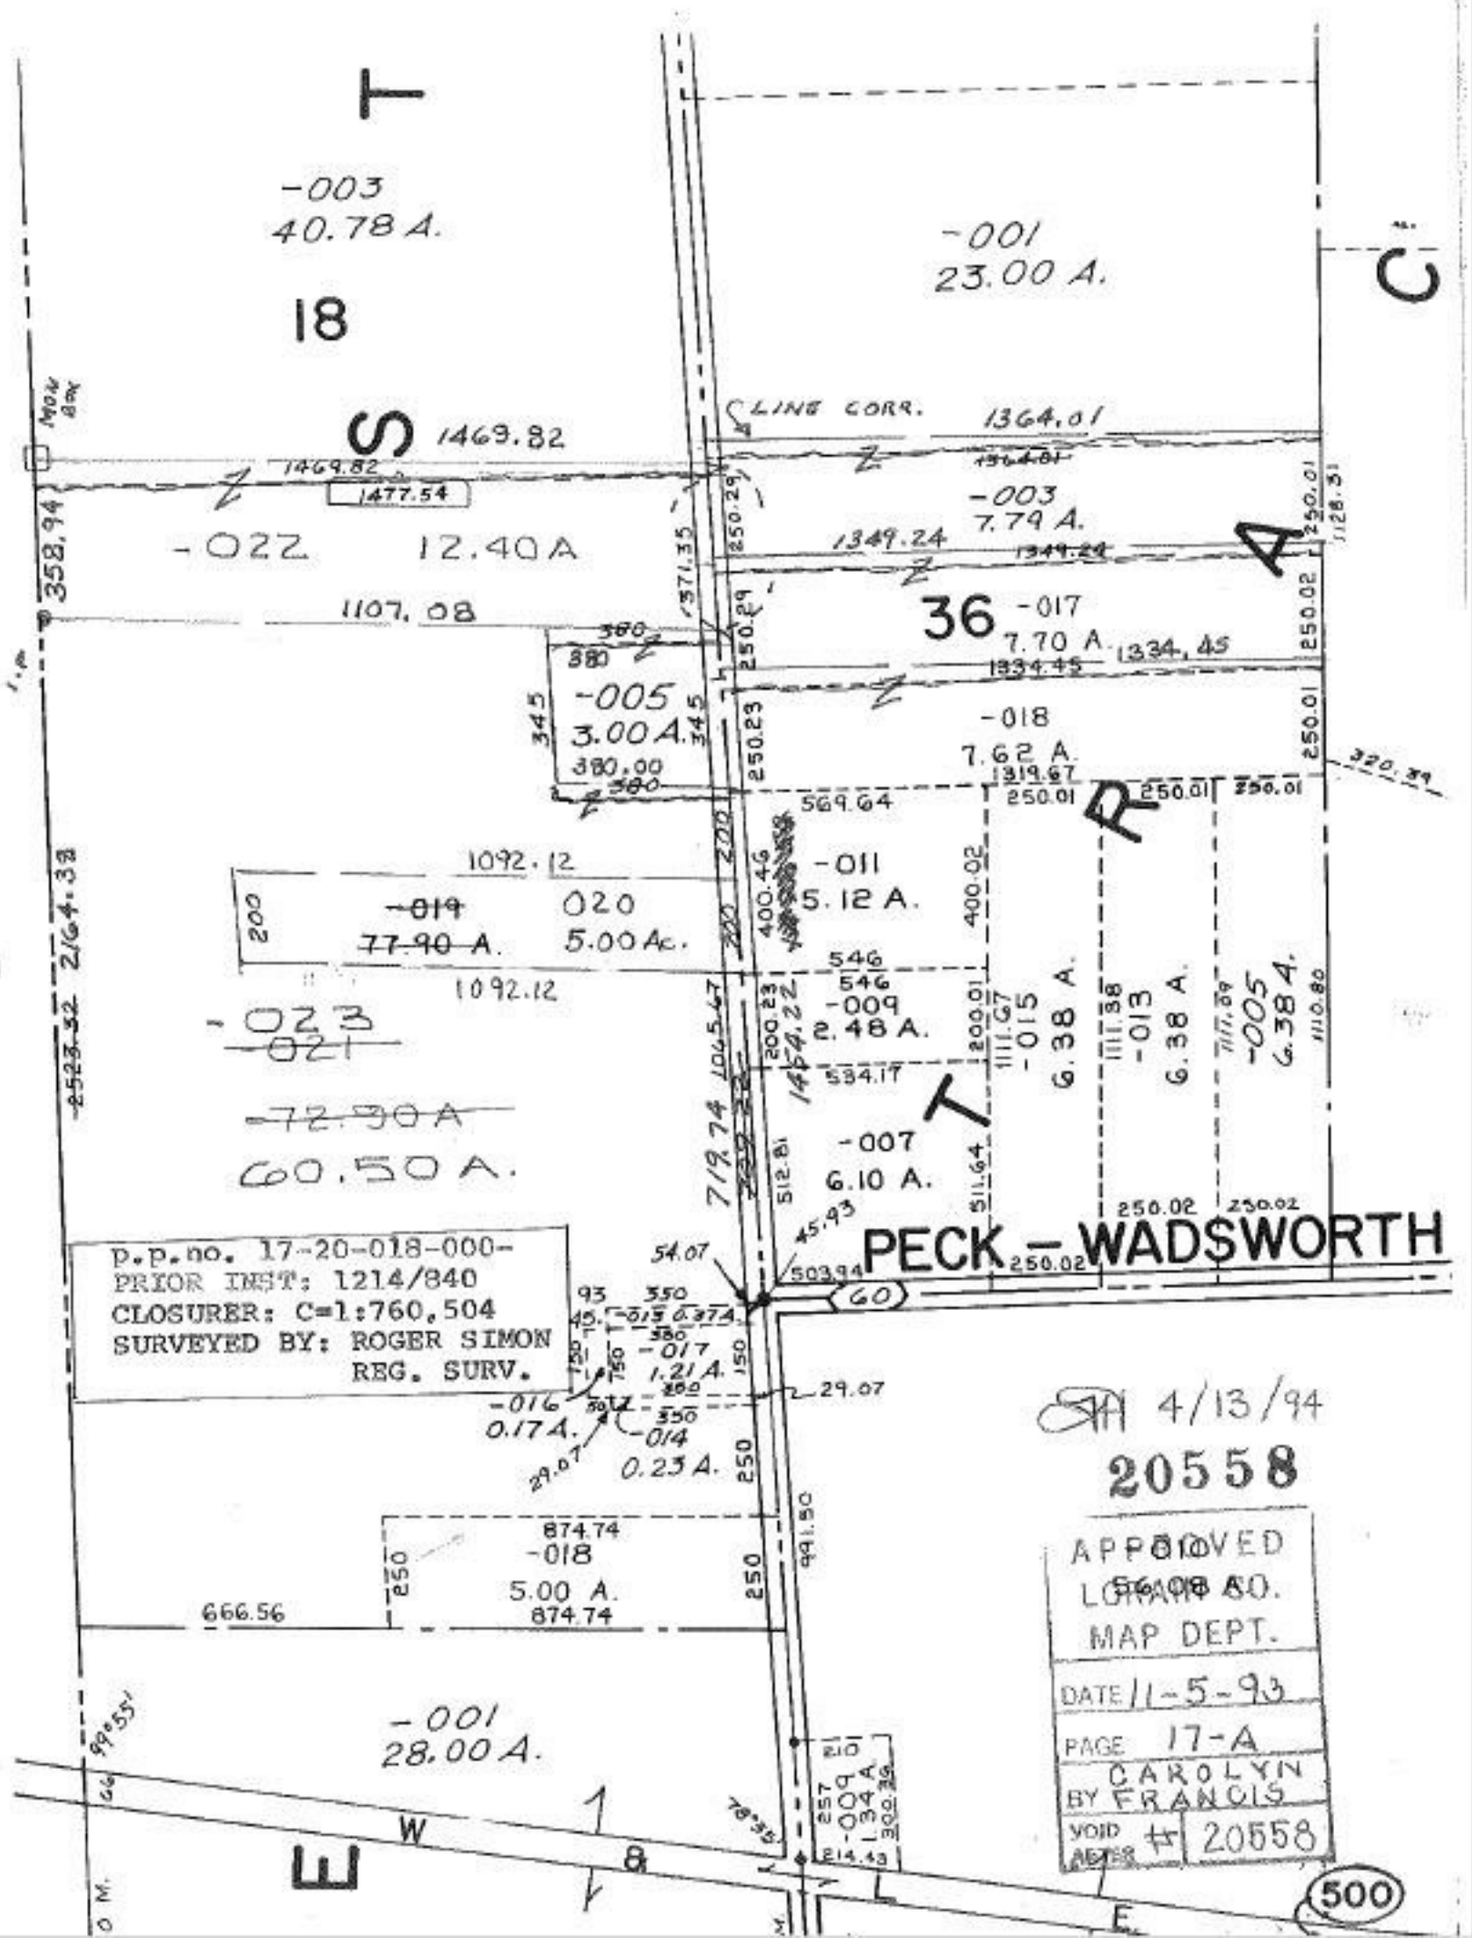
T
-003
40.78 A.
18
-001
23.00 A.
S
1469.82
1469.82
1477.54
-022 12.40A
358.94
1107.08
LINE CORR.
1364.01
1364.01
-003
7.79 A.
1349.24
1349.24
A
36
-017
7.70 A.
1334.45
1334.45
-018
7.62 A.
1319.97
-005
3.00A.
380.00
380
380
345
345
250.29
250.23
250.01
250.01
250.01
320.39
569.64
R
1092.12
-019
77.90 A.
020
5.00 Ac.
1092.12
-011
5.12 A.
400.46
400.02
546
546
-009
2.48 A.
200.01
200.23
1464.22
534.17
-015
6.38 A.
-013
6.38 A.
-005
6.384.
-023
-021
72.90A
60.50 A.
719.74
512.81
511.64
-007
6.10 A.
250.02
250.02
503.94
45.93
PECK - WADSWORTH
60
p.p.no. 17-20-018-000-
PRIOR INST: 1214/840
CLOSURER: C=1:760,504
SURVEYED BY: ROGER SIMON
REG. SURV.
54.07
93
350
-015 0.37A.
380
-017
1.21 A.
200
-016
0.17A.
-014
0.23 A.
29.07
29.07
150
250
250
874.74
-018
5.00 A.
874.74
666.56
991.50
-001
28.00 A.
E. 8 MILE
500
4/13/94
20558
APPROVED
LORAIN CO.
MAP DEPT.
DATE 11-5-93
PAGE 17-A
BY CAROLYN FRANCIS
VOID AFTER # 20558