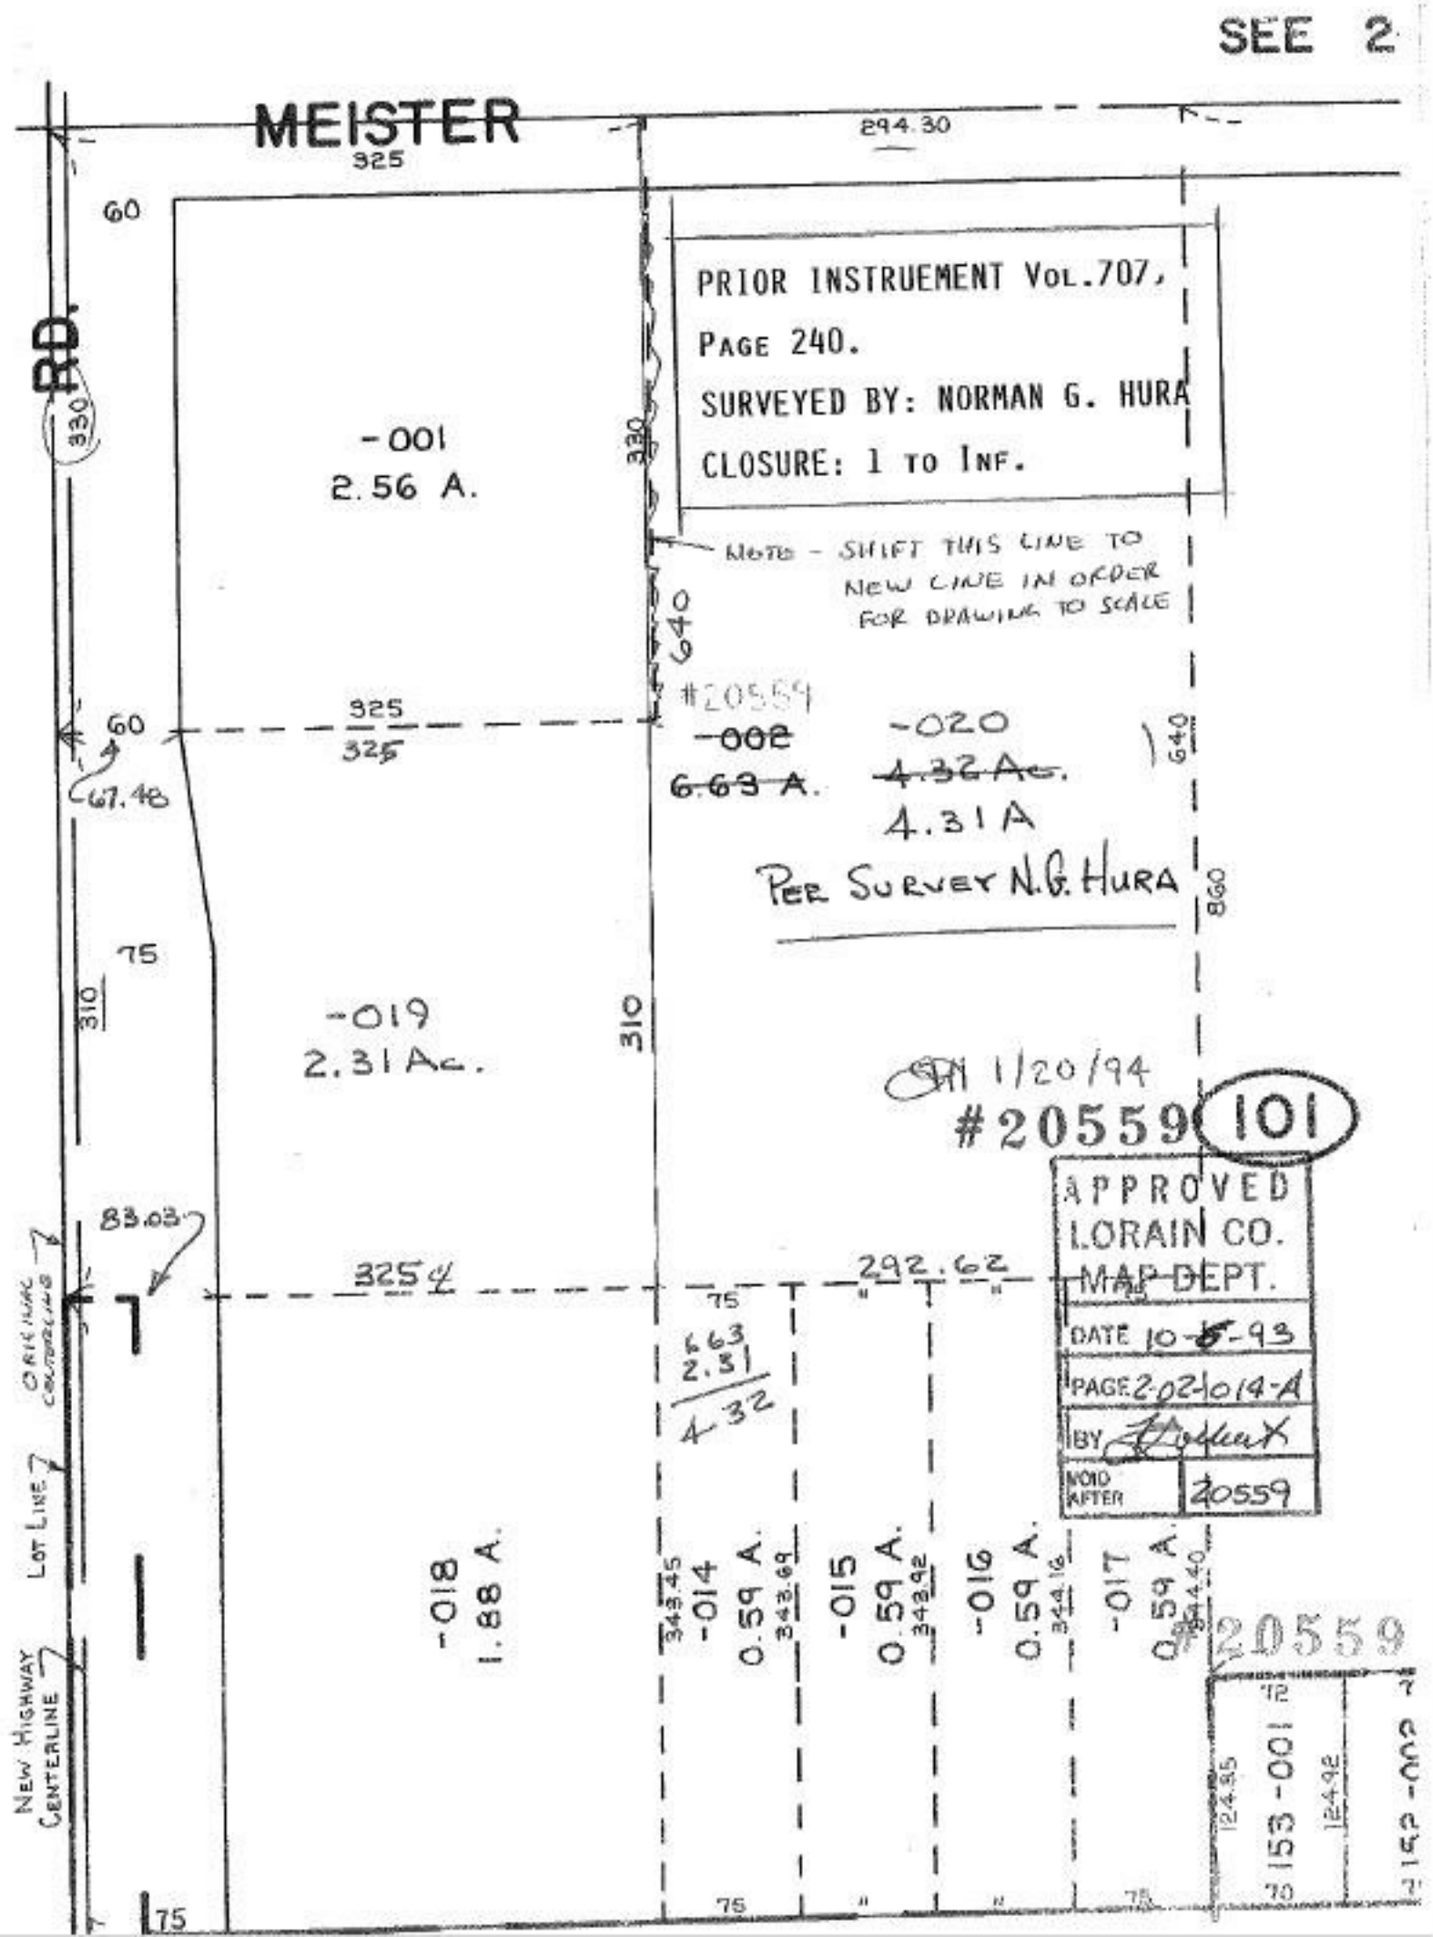
SEE 2
MEISTER
RD.
325
294.30
60
330
-001
2.56 A.
PRIOR INSTRUEMENT VOL.707,
PAGE 240.
SURVEYED BY: NORMAN G. HURA
CLOSURE: 1 TO INF.
NOTE - SHIFT THIS LINE TO NEW LINE IN ORDER FOR DRAWING TO SCALE
640
#20559
-002
6.63 A.
-020
4.32 Ac.
4.31 A
PER SURVEY N.G. HURA
67.48
75
310
-019
2.31 Ac.
860
1/20/94
#20559
101
APPROVED
LORAIN CO.
MAP DEPT.
DATE 10-5-93
PAGE 2-02-014-A
BY
VOID AFTER 20559
83.03
325
292.62
663
2.31
4.32
ORIGINAL CENTERLINE
LOT LINE
NEW HIGHWAY CENTERLINE
-018
1.88 A.
343.45
-014
0.59 A.
343.69
-015
0.59 A.
343.92
-016
0.59 A.
344.16
-017
0.59 A.
344.40
#20559
72
124.85
153-001
124.92
70
75