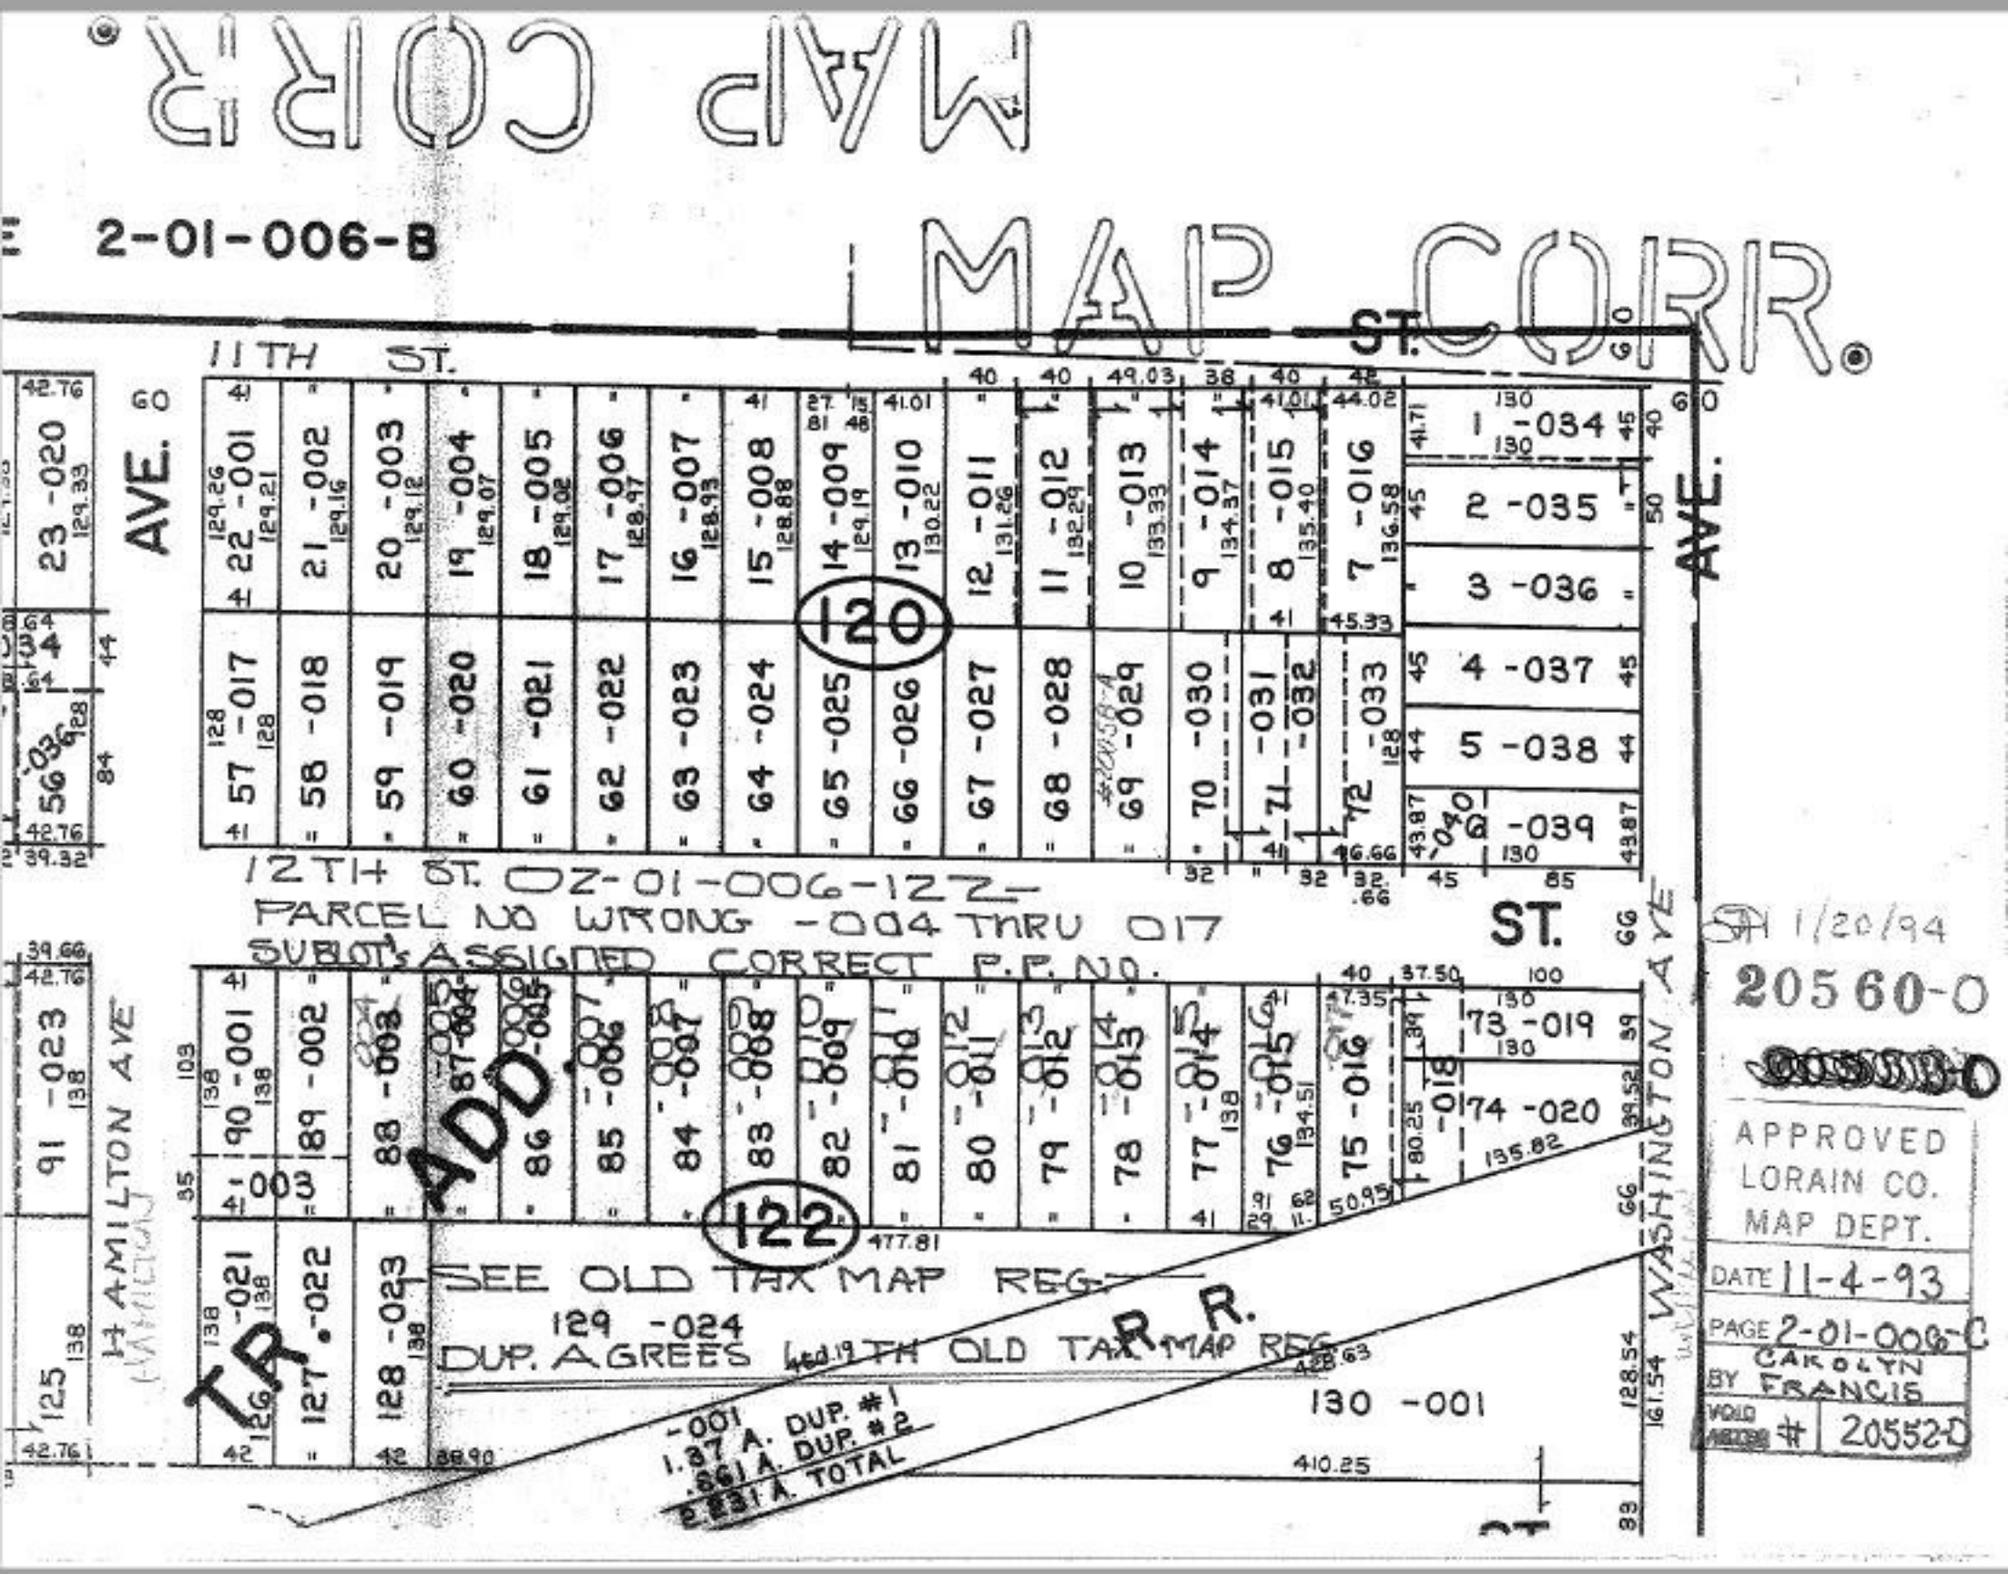
MAP CORR.
2-01-006-B
MAP CORR.
11TH ST.
12TH ST. 02-01-006-122-
PARCEL NO WRONG -004 THRU 017
SUBLOT'S ASSIGNED CORRECT P.P. NO.
SEE OLD TAX MAP REG.
129 -024
DUP. AGREES 11TH OLD TAX MAP REG.
130 -001
-001
1.37 A. DUP. #1
.861 A. DUP. #2
2.231 A. TOTAL
120
122
ADD.
TR.
R.R.
AVE.
ST.
HAMILTON AVE
WASHINGTON AVE
1 -034
2 -035
3 -036
4 -037
5 -038
6 -039
73 -019
74 -020
130 -001
1/20/94
20560-0
APPROVED
LORAIN CO.
MAP DEPT.
DATE 11-4-93
PAGE 2-01-006-C
BY CAROLYN FRANCIS
VOID ABOVE # 20552-D