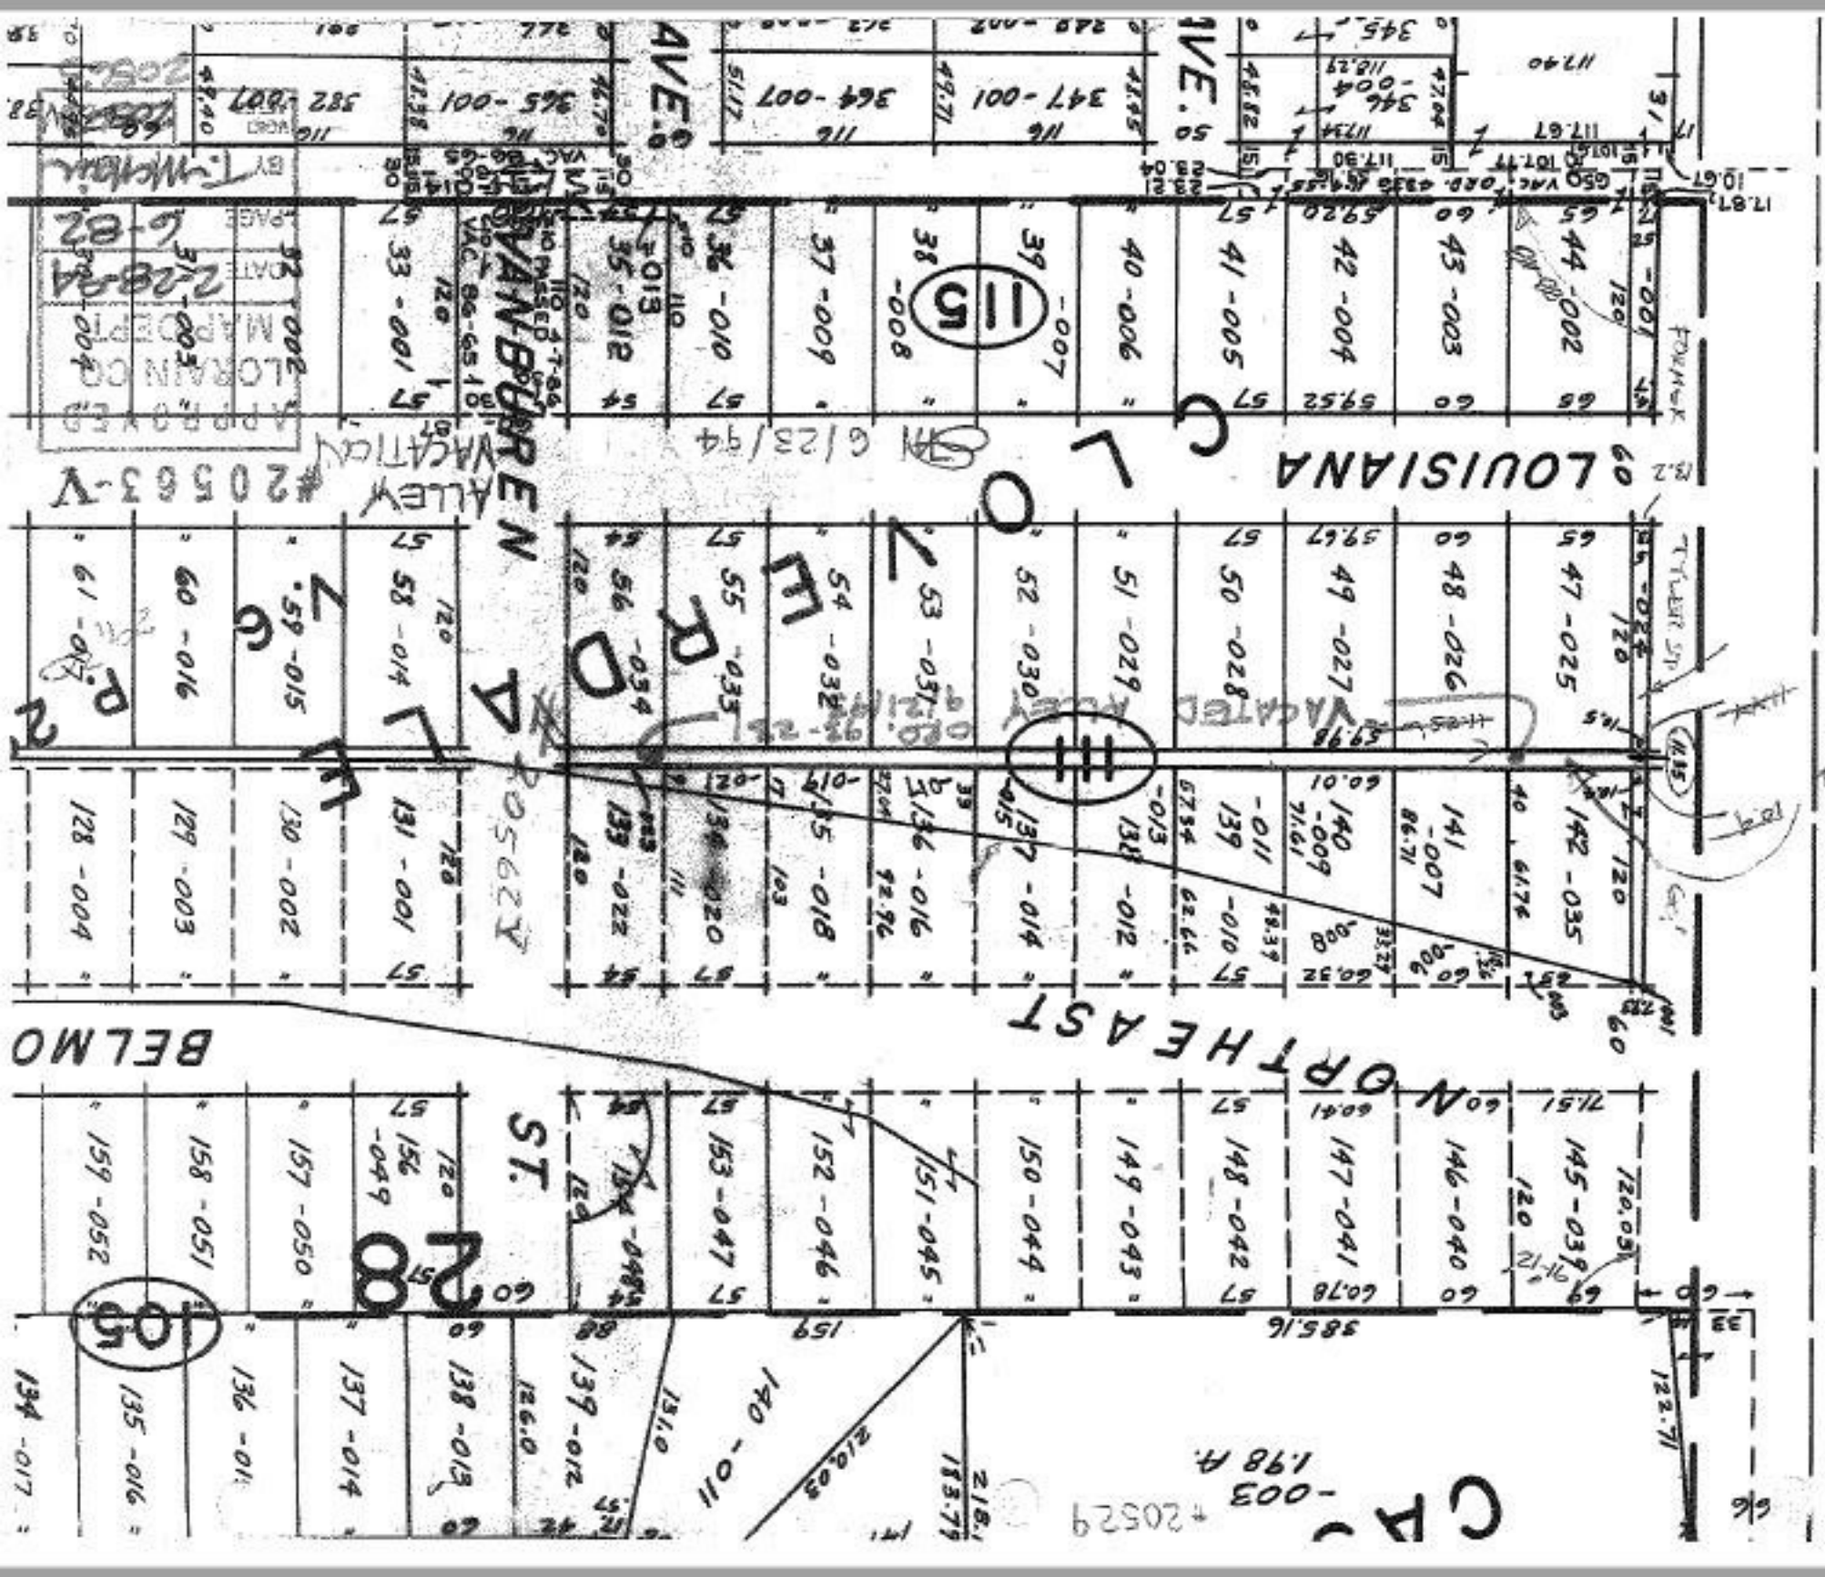
LOUISIANA
NORTH EAST
BELMONT
ST.
AVE.
ALLEY
VACATED
ALLEY VACATION #20563-V
APPROVED
LORAIN CO.
MAP DEPT.
DATE
PAGE
