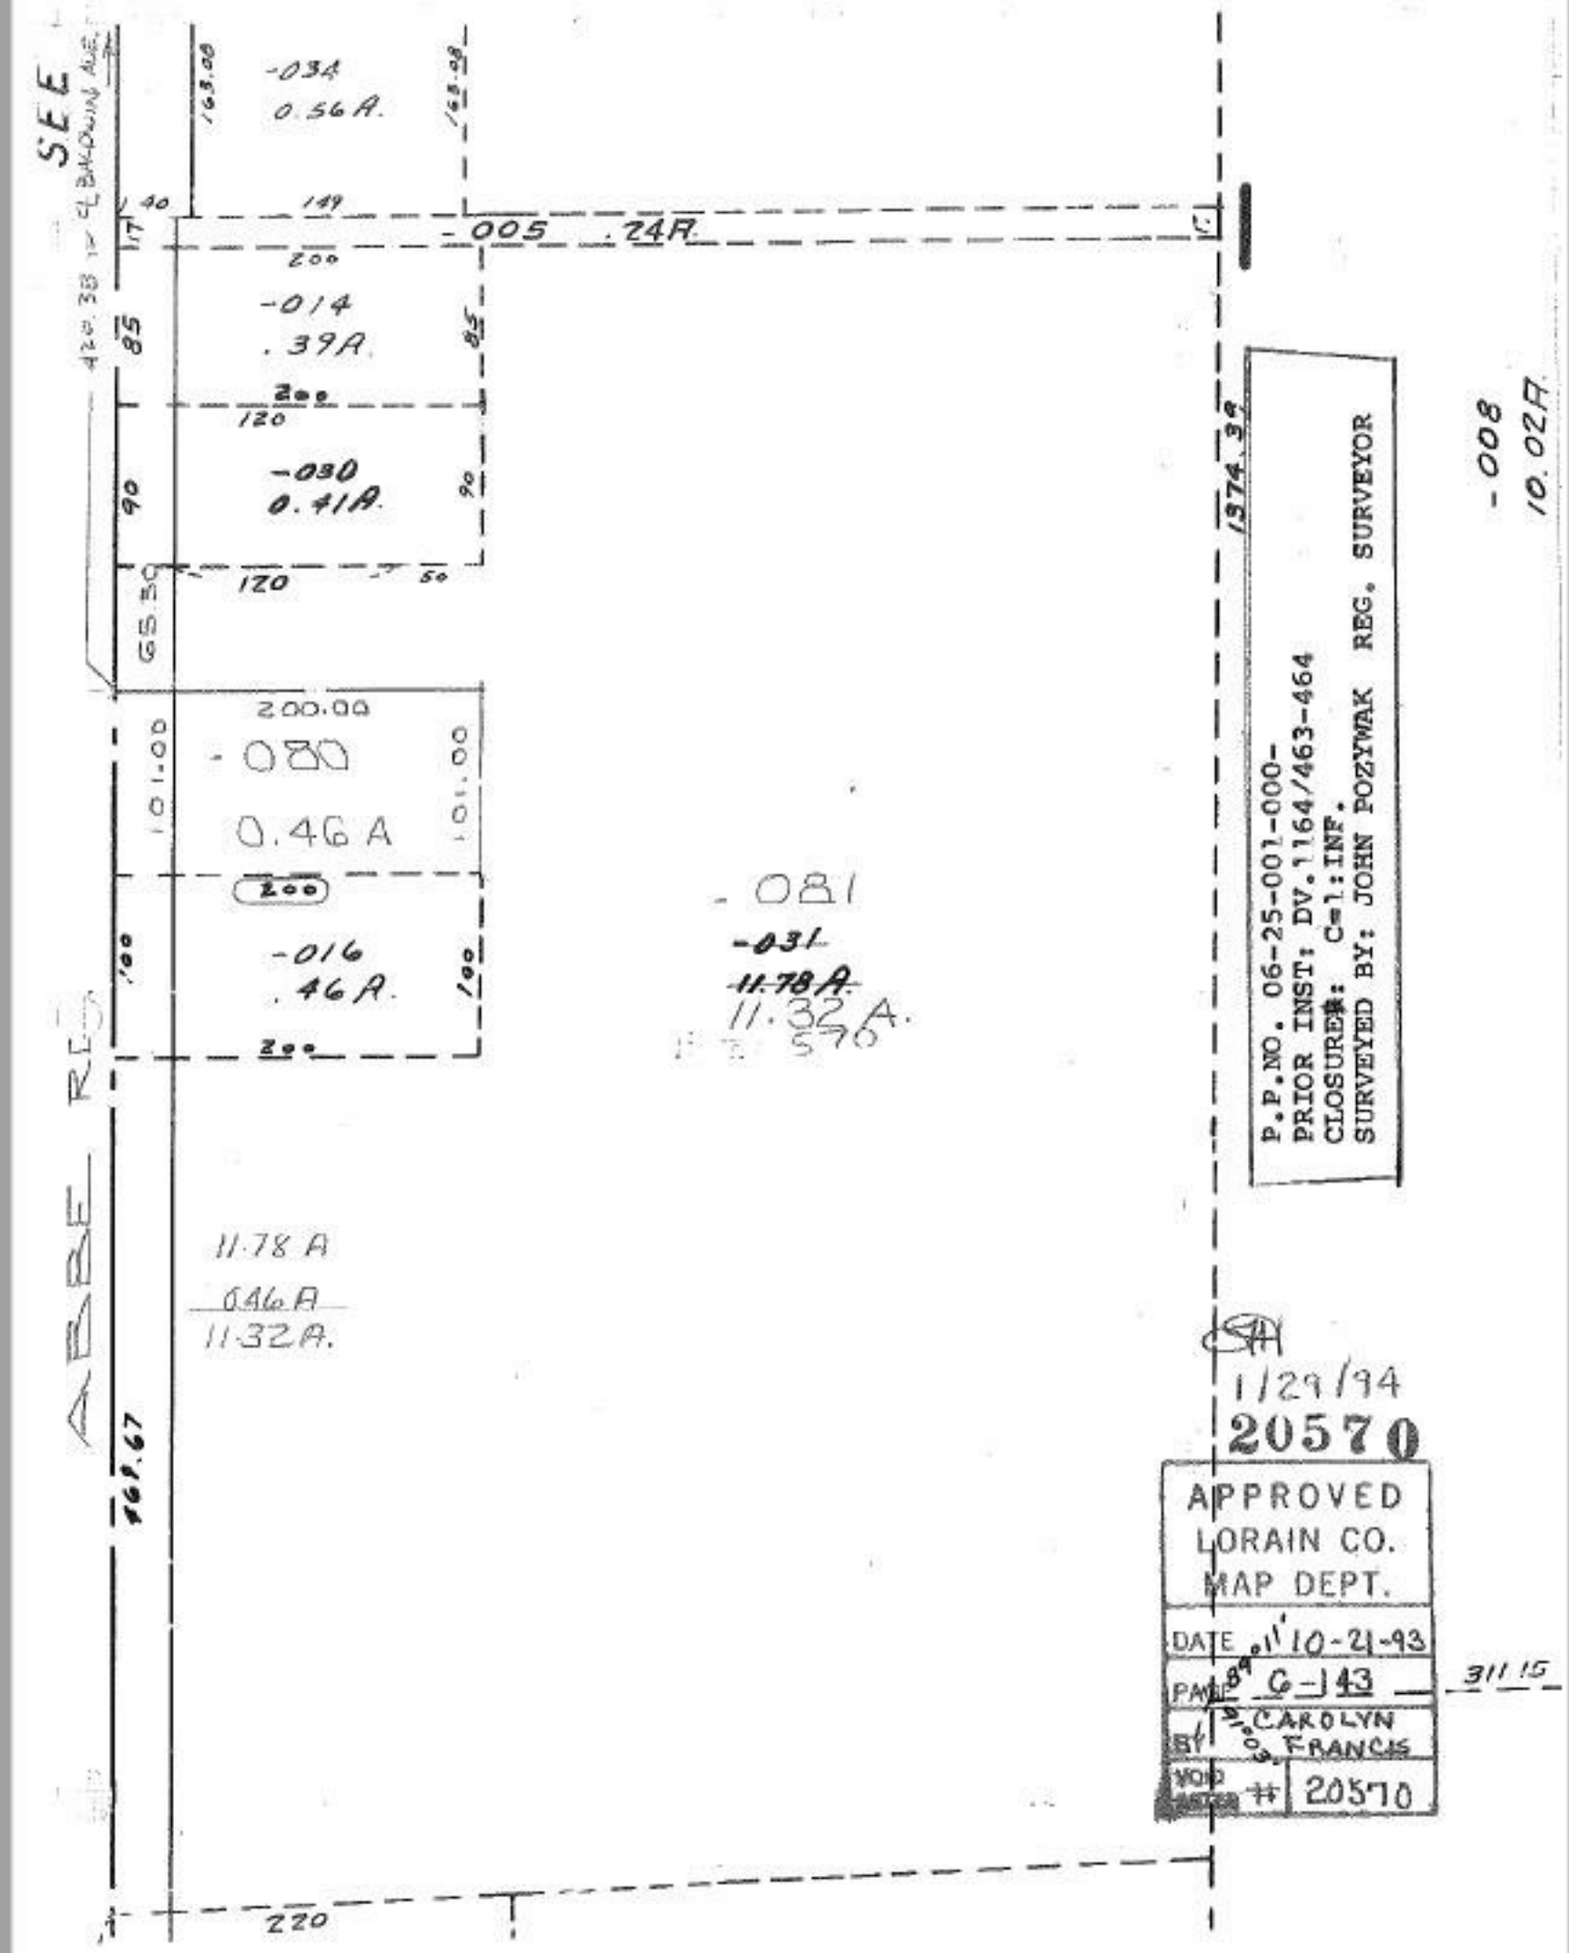
SEE
ABBE RD
-034
0.56A.
-005 .24A.
-014
.39A.
-030
0.41A.
200.00
-080
0.46 A
-016
.46A.
-081
-031
11.78A.
11.32 A.
11.78 A
0.46 A
11.32A.
-008
10.02A.
1374.39
469.67
220
P.P.NO. 06-25-001-000-
PRIOR INST: DV.1164/463-464
CLOSURE#: C=1:INF.
SURVEYED BY: JOHN POZYWAK REG. SURVEYOR
1/29/94
20570
APPROVED
LORAIN CO.
MAP DEPT.
DATE 10-21-93
PAGE 6-143
BY CAROLYN FRANCIS
VOID # 20570