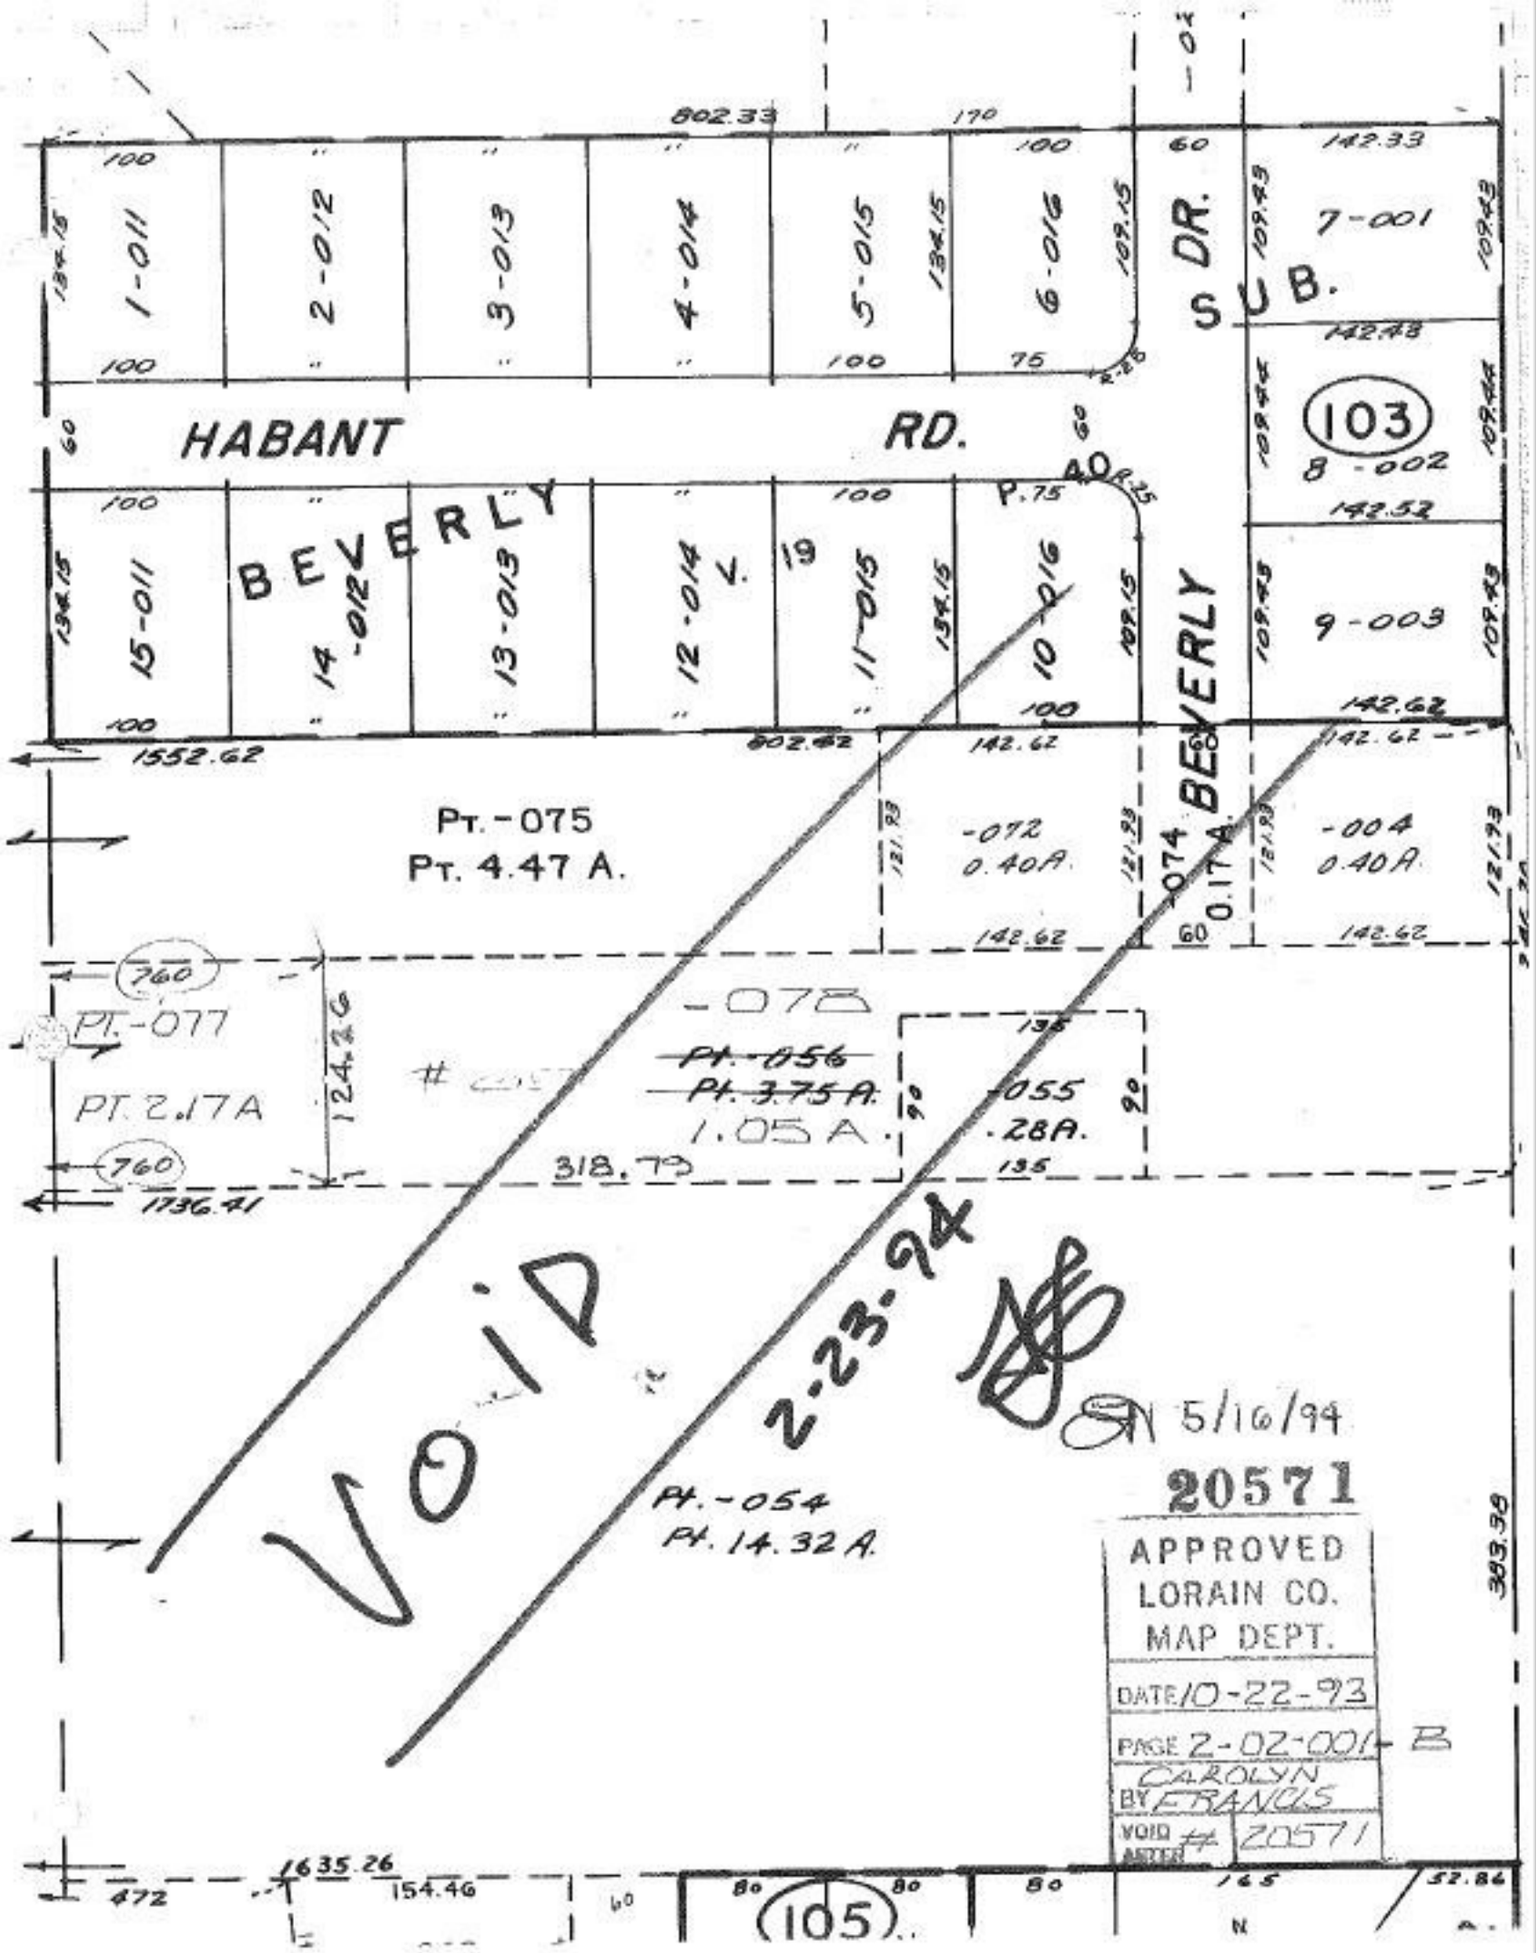

HABANT RD.
BEVERLY DR.
BEVERLY SUB.
1-011
2-012
3-013
4-014
5-015
6-016
7-001
8-002
9-003
15-011
14-012
13-013
12-014
11-015
10-016
103
Pt.-075
Pt. 4.47 A.
-072
0.40A.
-004
0.40A.
-074
0.17 A.
-078
Pt.-056
Pt. 3.75 A.
1.05 A.
-055
.28A.
PT.-077
PT. 2.17A
760
124.26
318.79
1552.62
1736.41
802.33
802.42
142.33
142.43
142.52
142.62
Pt.-054
Pt. 14.32 A.
VOID
2-23-94
5/16/94
20571
APPROVED
LORAIN CO.
MAP DEPT.
DATE 10-22-93
PAGE 2-02-001-B
BY CAROLYN FRANCIS
VOID AFTER # 20571
383.38
1635.26
154.46
472
105