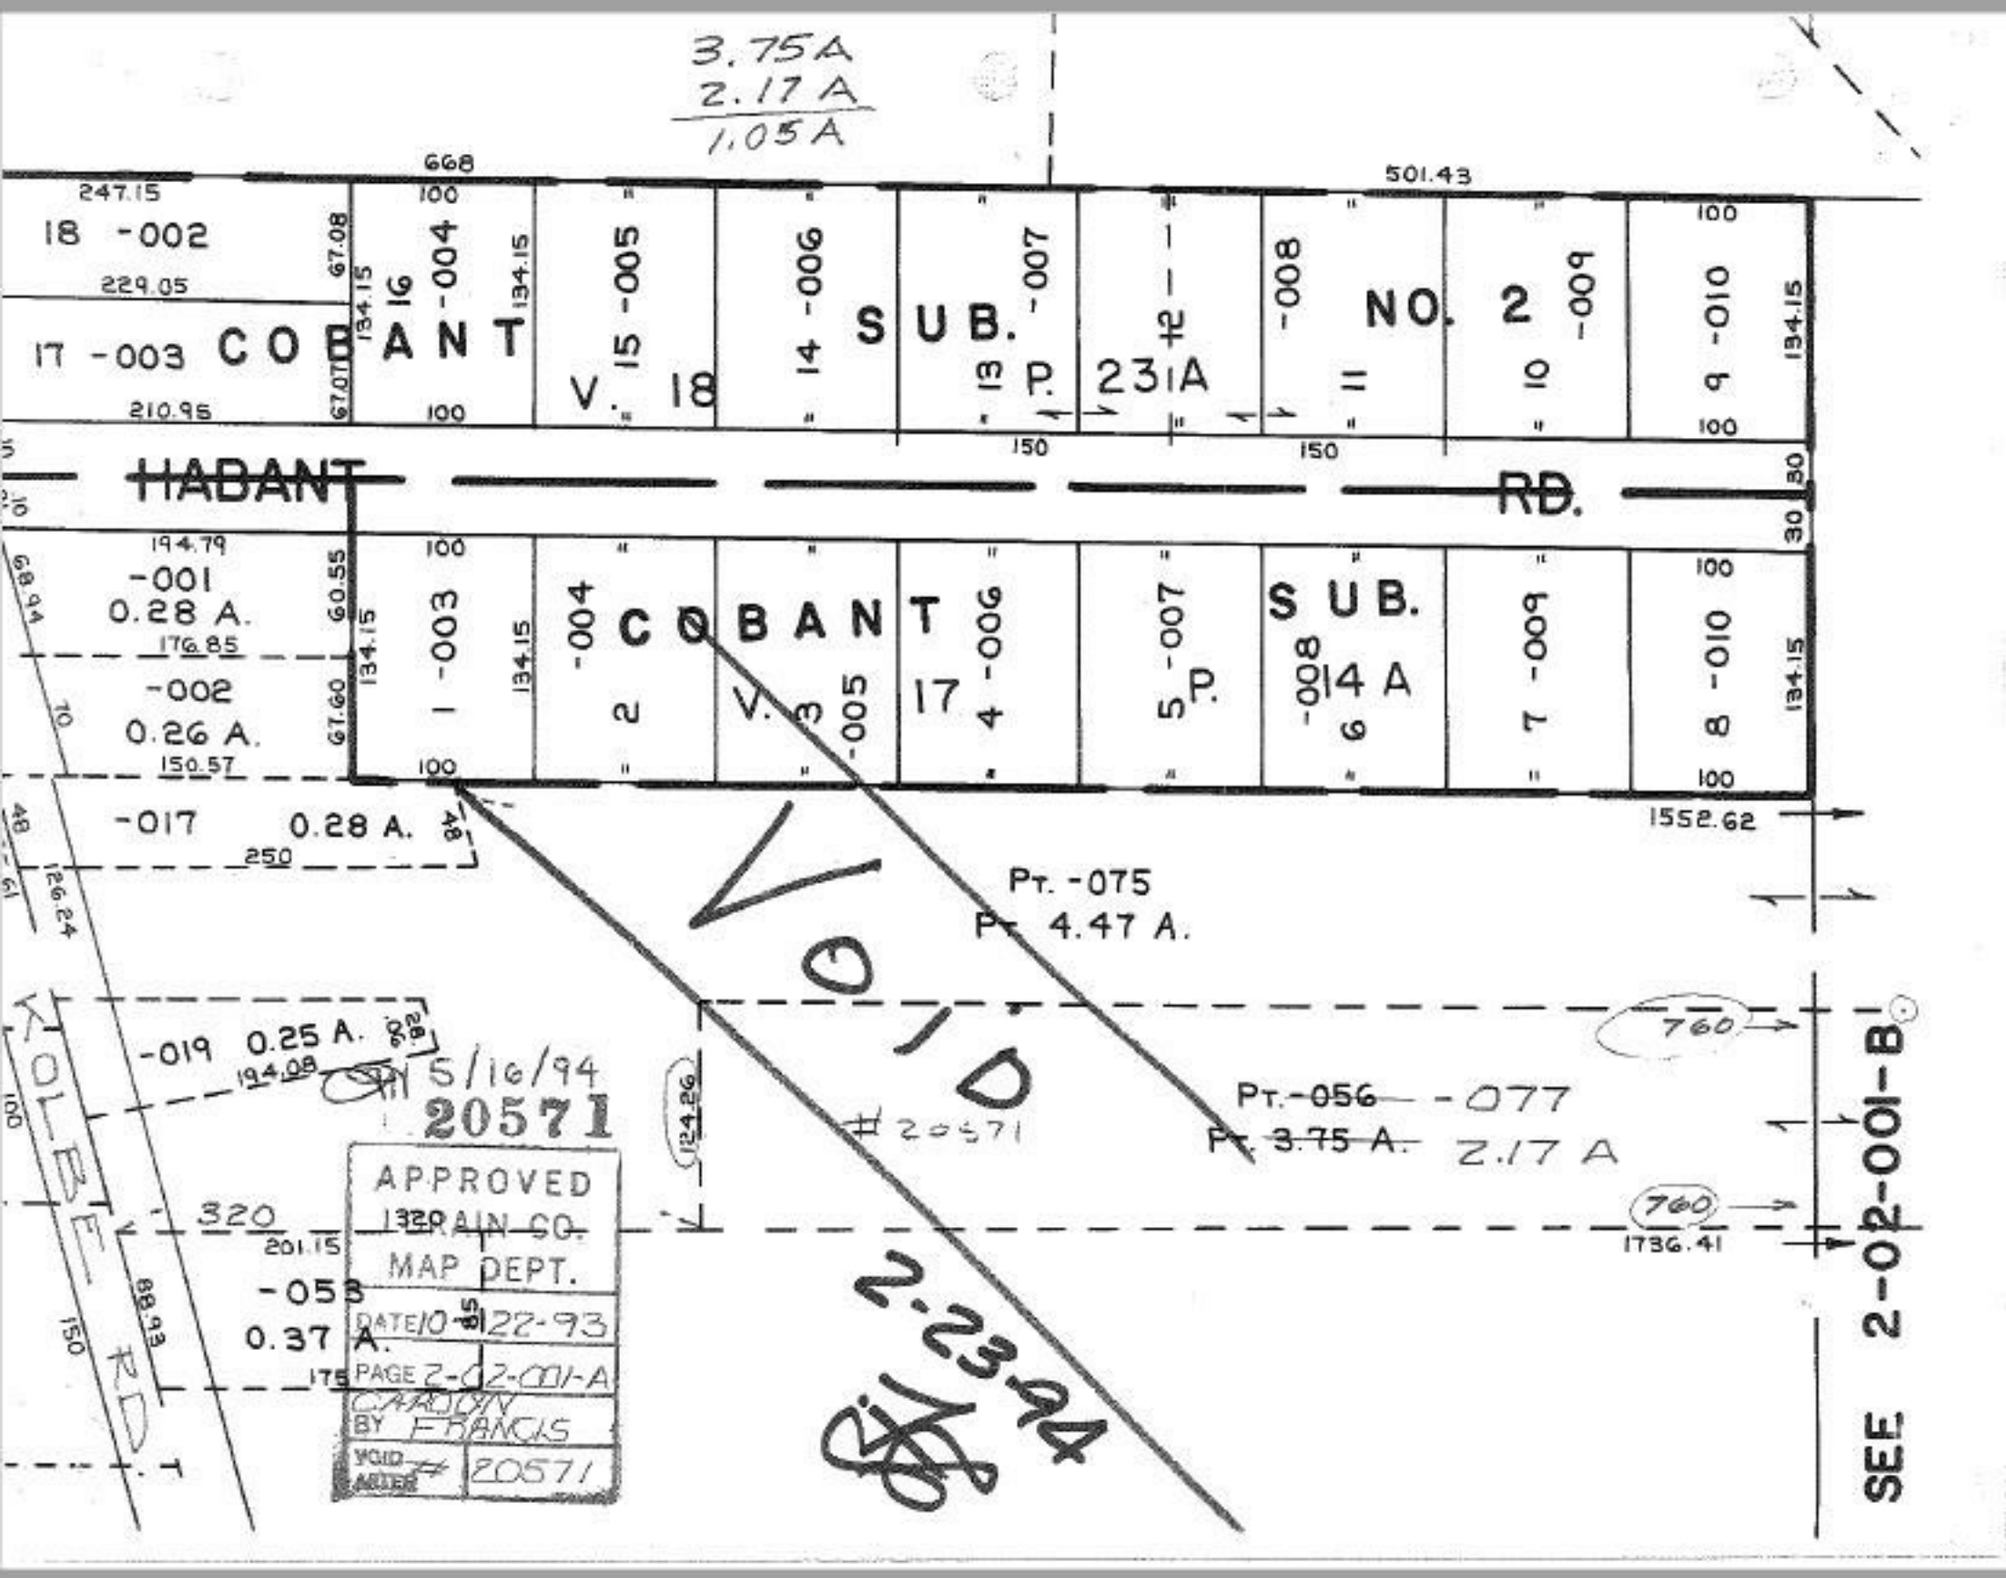
3.75A
2.17A
1.05A
668
501.43
247.15
18 -002
229.05
17 -003
COBANT
210.95
16 -004
V. 18
15 -005
14 -006
SUB.
13 -007
P. 23 A
12
-008
NO. 2
11
10 -009
9 -010
HABANT
RD.
194.79
-001
0.28 A.
176.85
-002
0.26 A.
150.57
1 -003
2 -004
COBANT
V. 3 -005
17
4 -006
5 -007
P.
SUB.
6 -008
14 A
7 -009
8 -010
1552.62
-017
0.28 A.
250
Pt. -075
Pt. 4.47 A.
VOID
-019
0.25 A.
194.08
5/16/94
20571
#20571
Pt. -056
Pt. 3.75 A.
-077
2.17 A
760
760
1736.41
320
201.15
-053
0.37 A.
175
KOLBE RD
APPROVED
GRAIN CO.
MAP DEPT.
DATE 10-22-93
PAGE 2-02-001-A
CARDON
BY FRANCIS
VOID AFTER # 20571
2-23-94
SEE 2-02-001-B