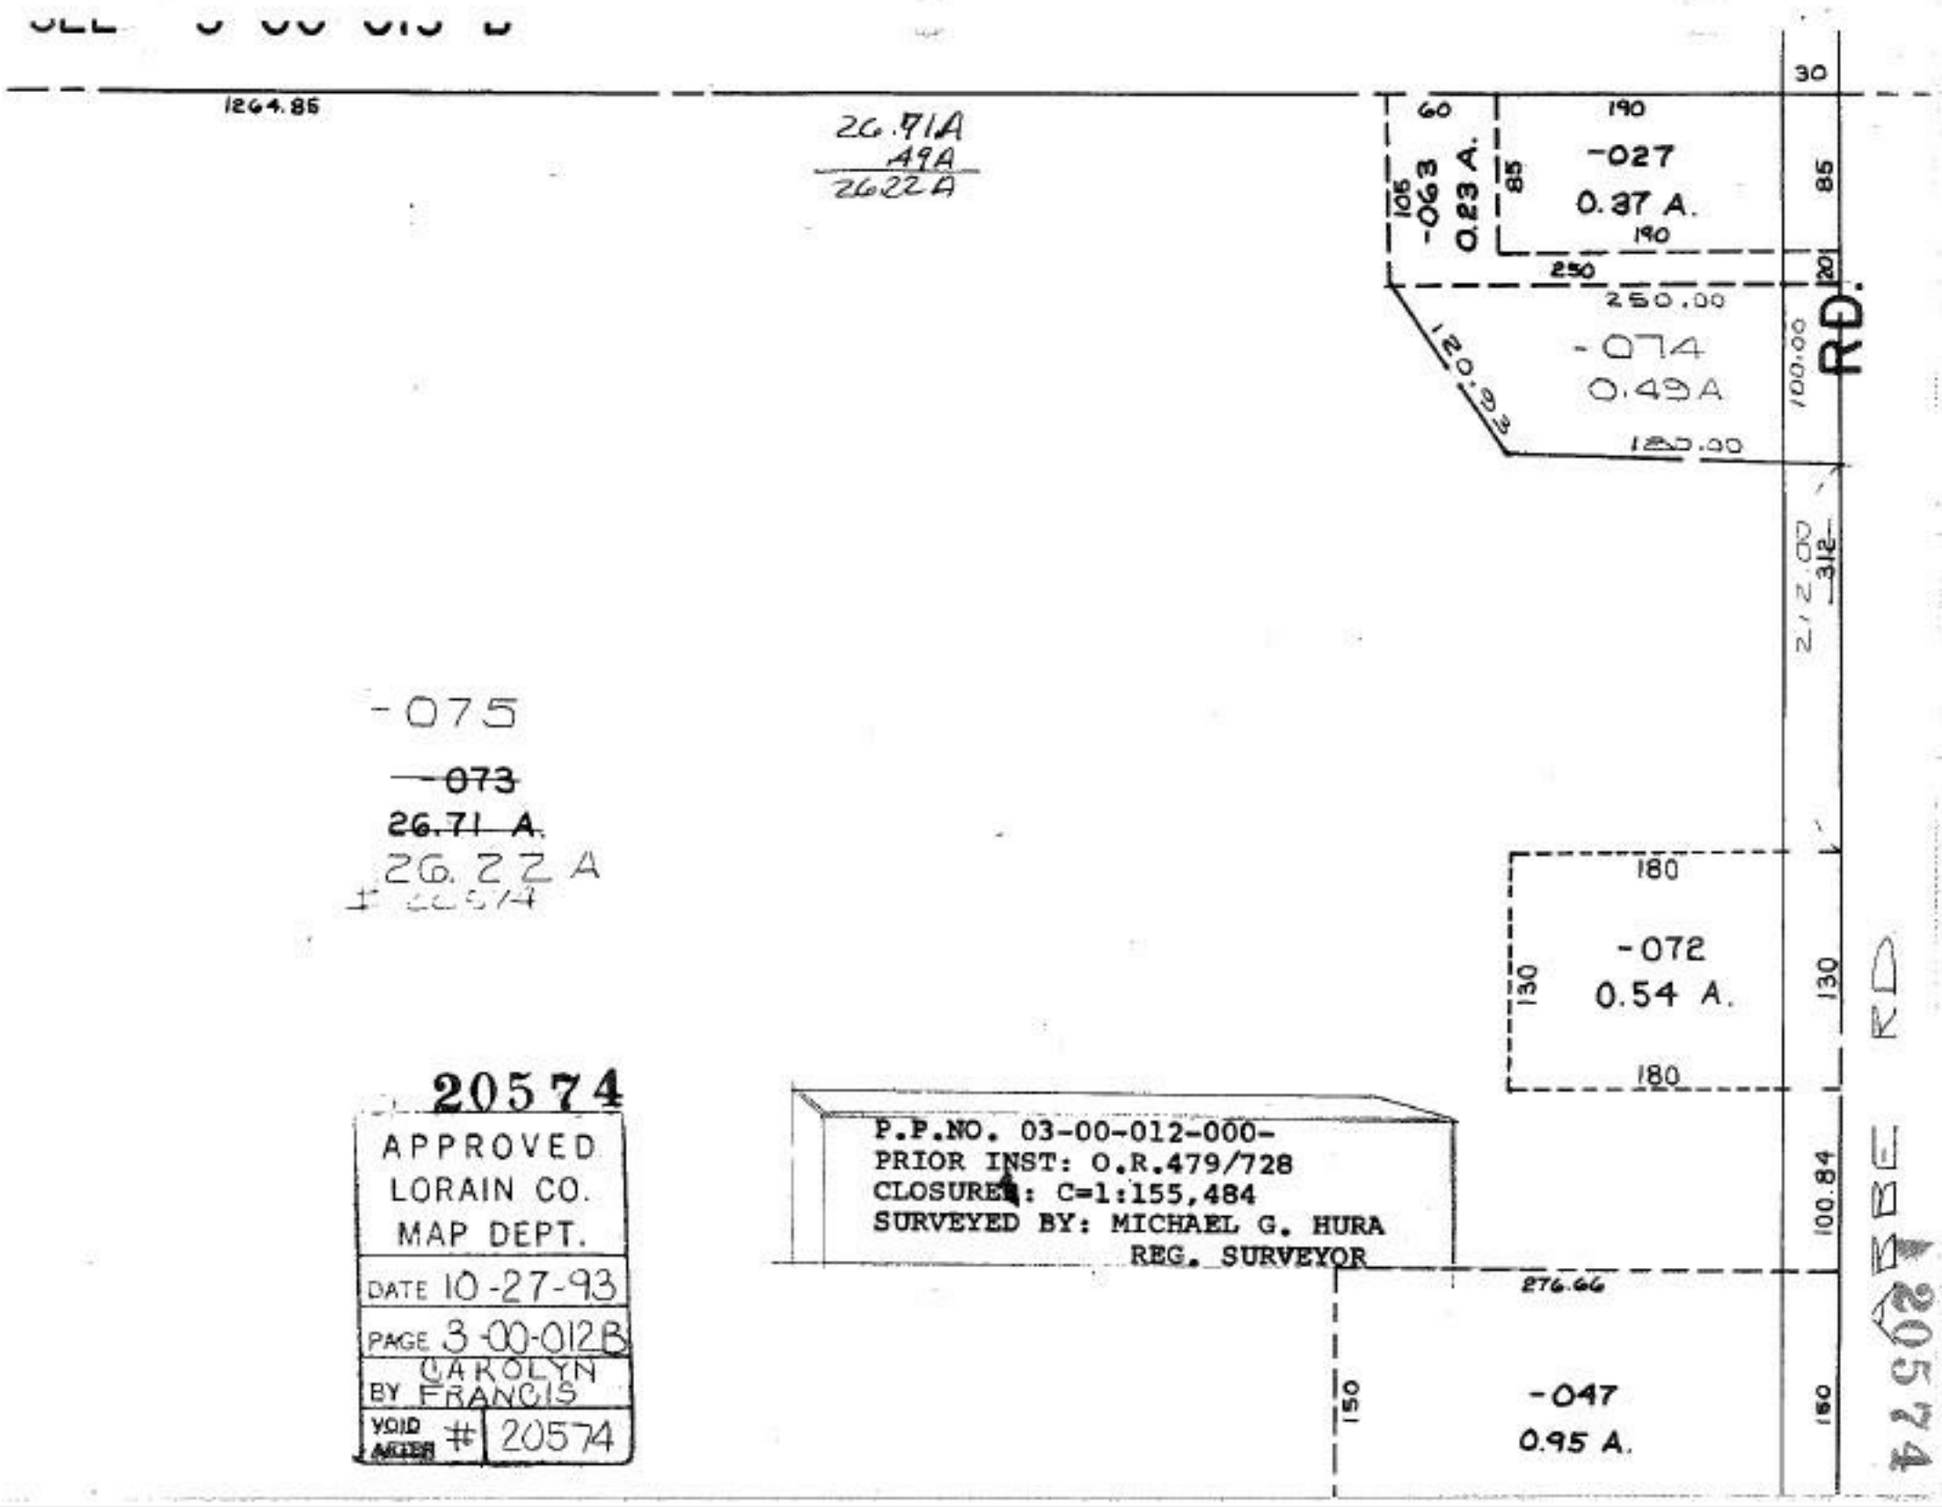

20574

APPROVED
LORAIN CO.
MAP DEPT.

DATE 10-27-93

PAGE 3-00-012B

BY CAROLYN FRANCIS

VOID AFTER # 20574