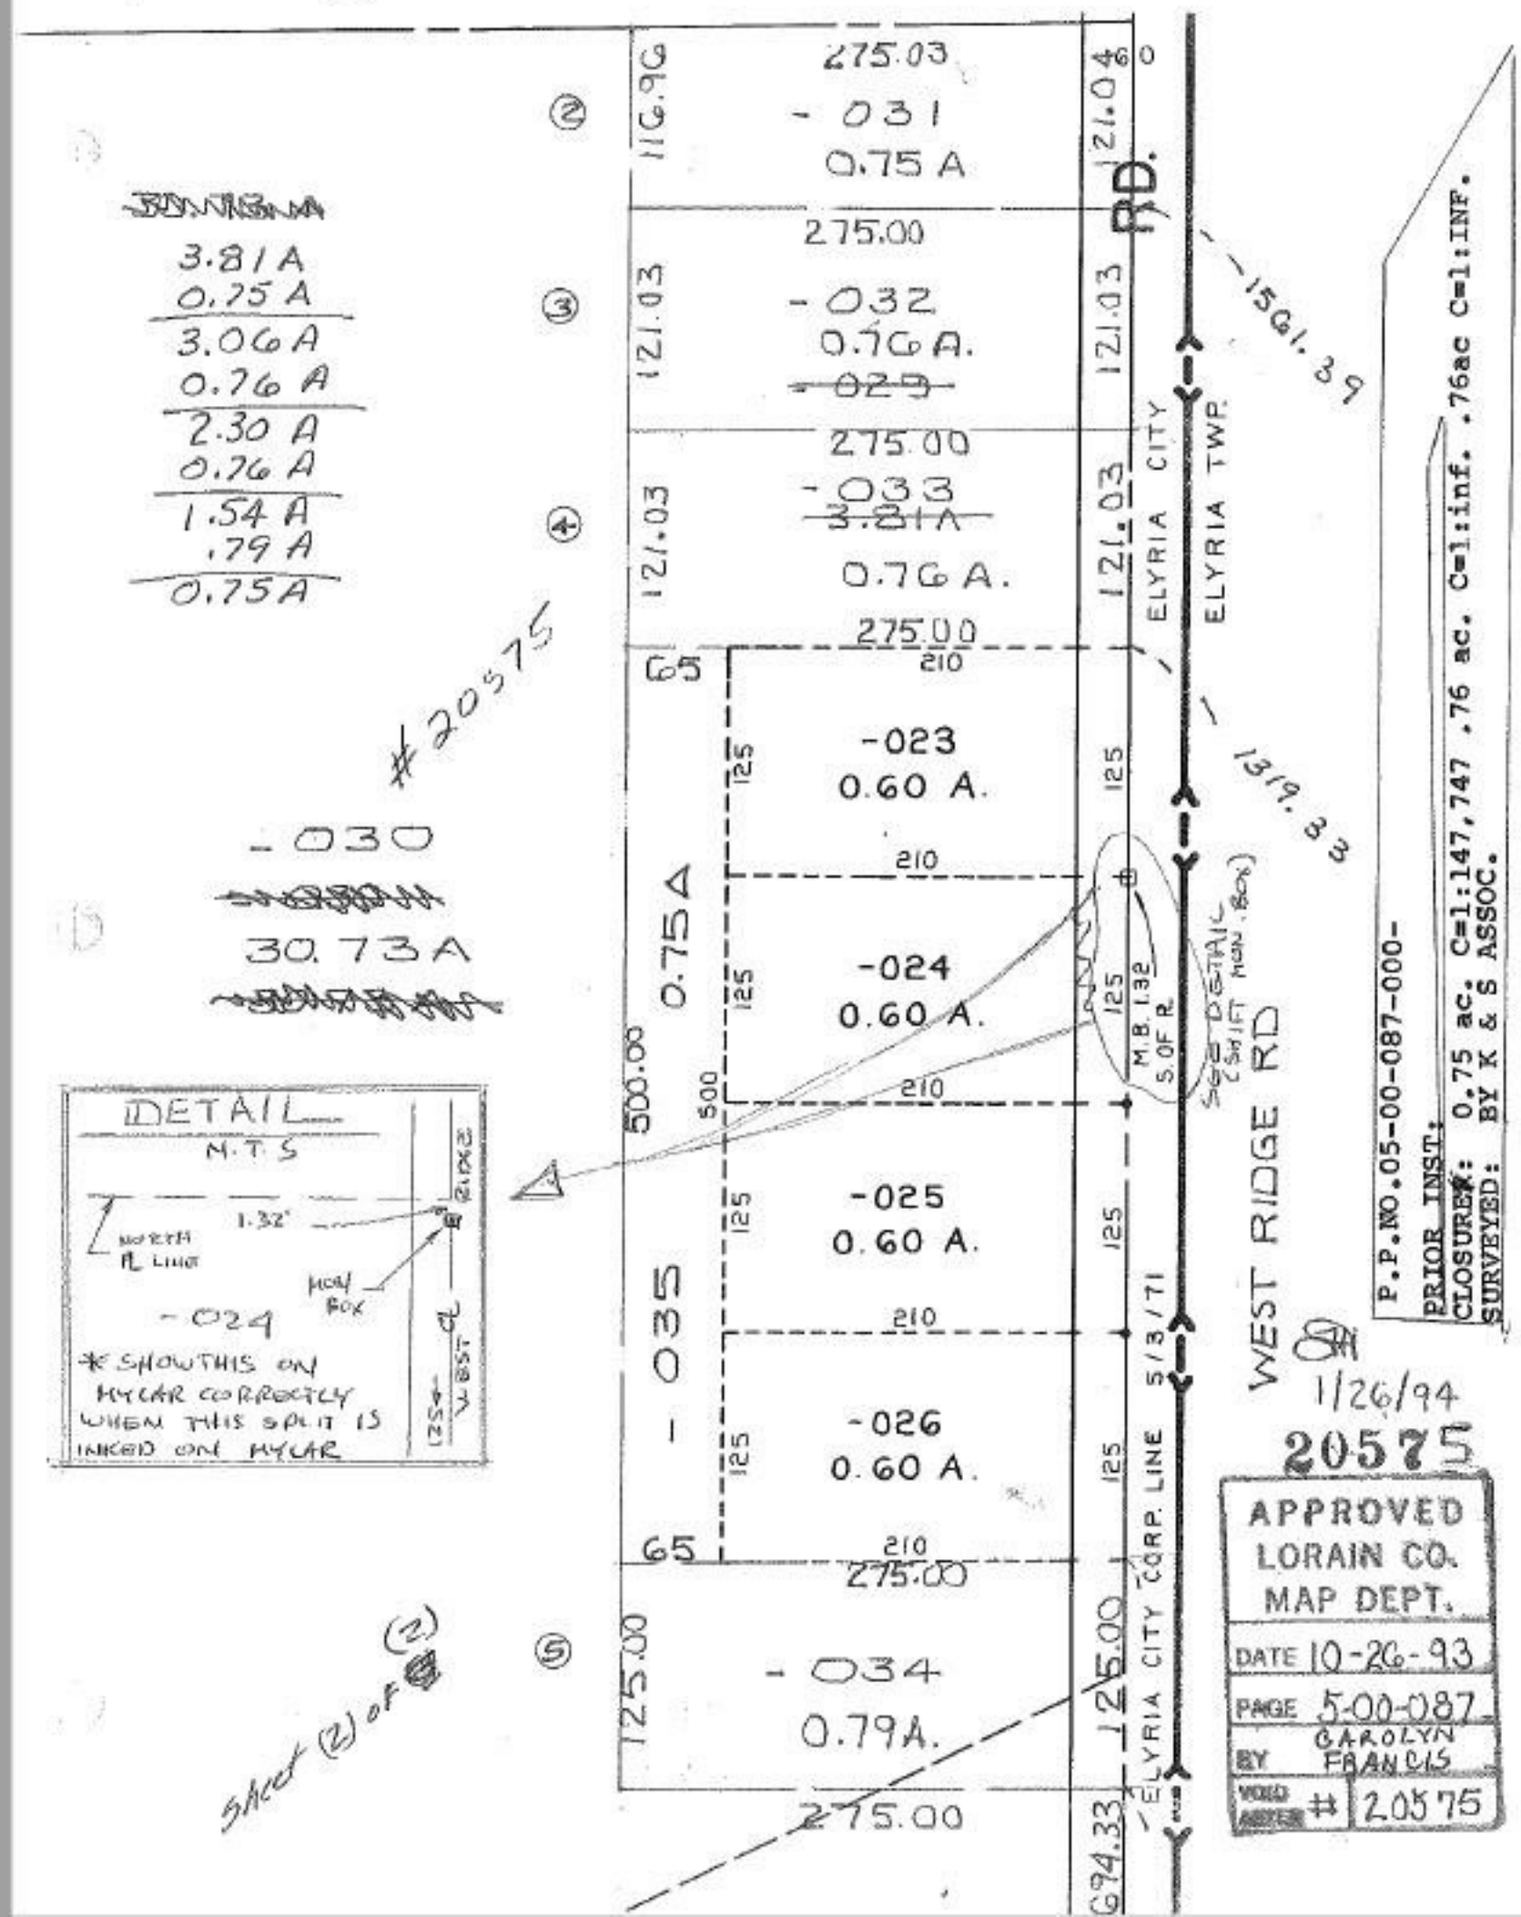

3.81 A
0.75 A
3.06 A
0.76 A
2.30 A
0.76 A
1.54 A
.79 A
0.75 A
#20575
-030
30.73 A
DETAIL
N.T.S
1.32'
NORTH PL LINE
MON BOX
-024
* SHOW THIS ON MYLAR CORRECTLY WHEN THIS SPLIT IS INKED ON MYLAR
Sheet (2) of (2)
275.03
-031
0.75 A
275.00
-032
0.76 A.
275.00
-033
0.76 A.
275.00
-023
0.60 A.
-024
0.60 A.
-025
0.60 A.
-026
0.60 A.
-034
0.79 A.
275.00
116.96
121.03
121.03
121.03
121.04
500.00
125.00
125.00
694.33
65
210
125
500
RD.
ELYRIA CITY
ELYRIA TWP.
1561.39
1319.33
M.B. 1.32 S. OF R.
SEE DETAIL (SHIFT MON. BOX)
WEST RIDGE RD
ELYRIA CITY CORP. LINE 5/3/71
P.P.NO.05-00-087-000-
PRIOR INST:
CLOSURE: 0.75 ac. C=1:147,747 .76 ac. C=1:inf. .76ac C=1:INF.
SURVEYED: BY K & S ASSOC.
1/26/94
20575
APPROVED
LORAIN CO.
MAP DEPT.
DATE 10-26-93
PAGE 5-00-087
BY CAROLYN FRANCIS
VOID AFTER # 20575