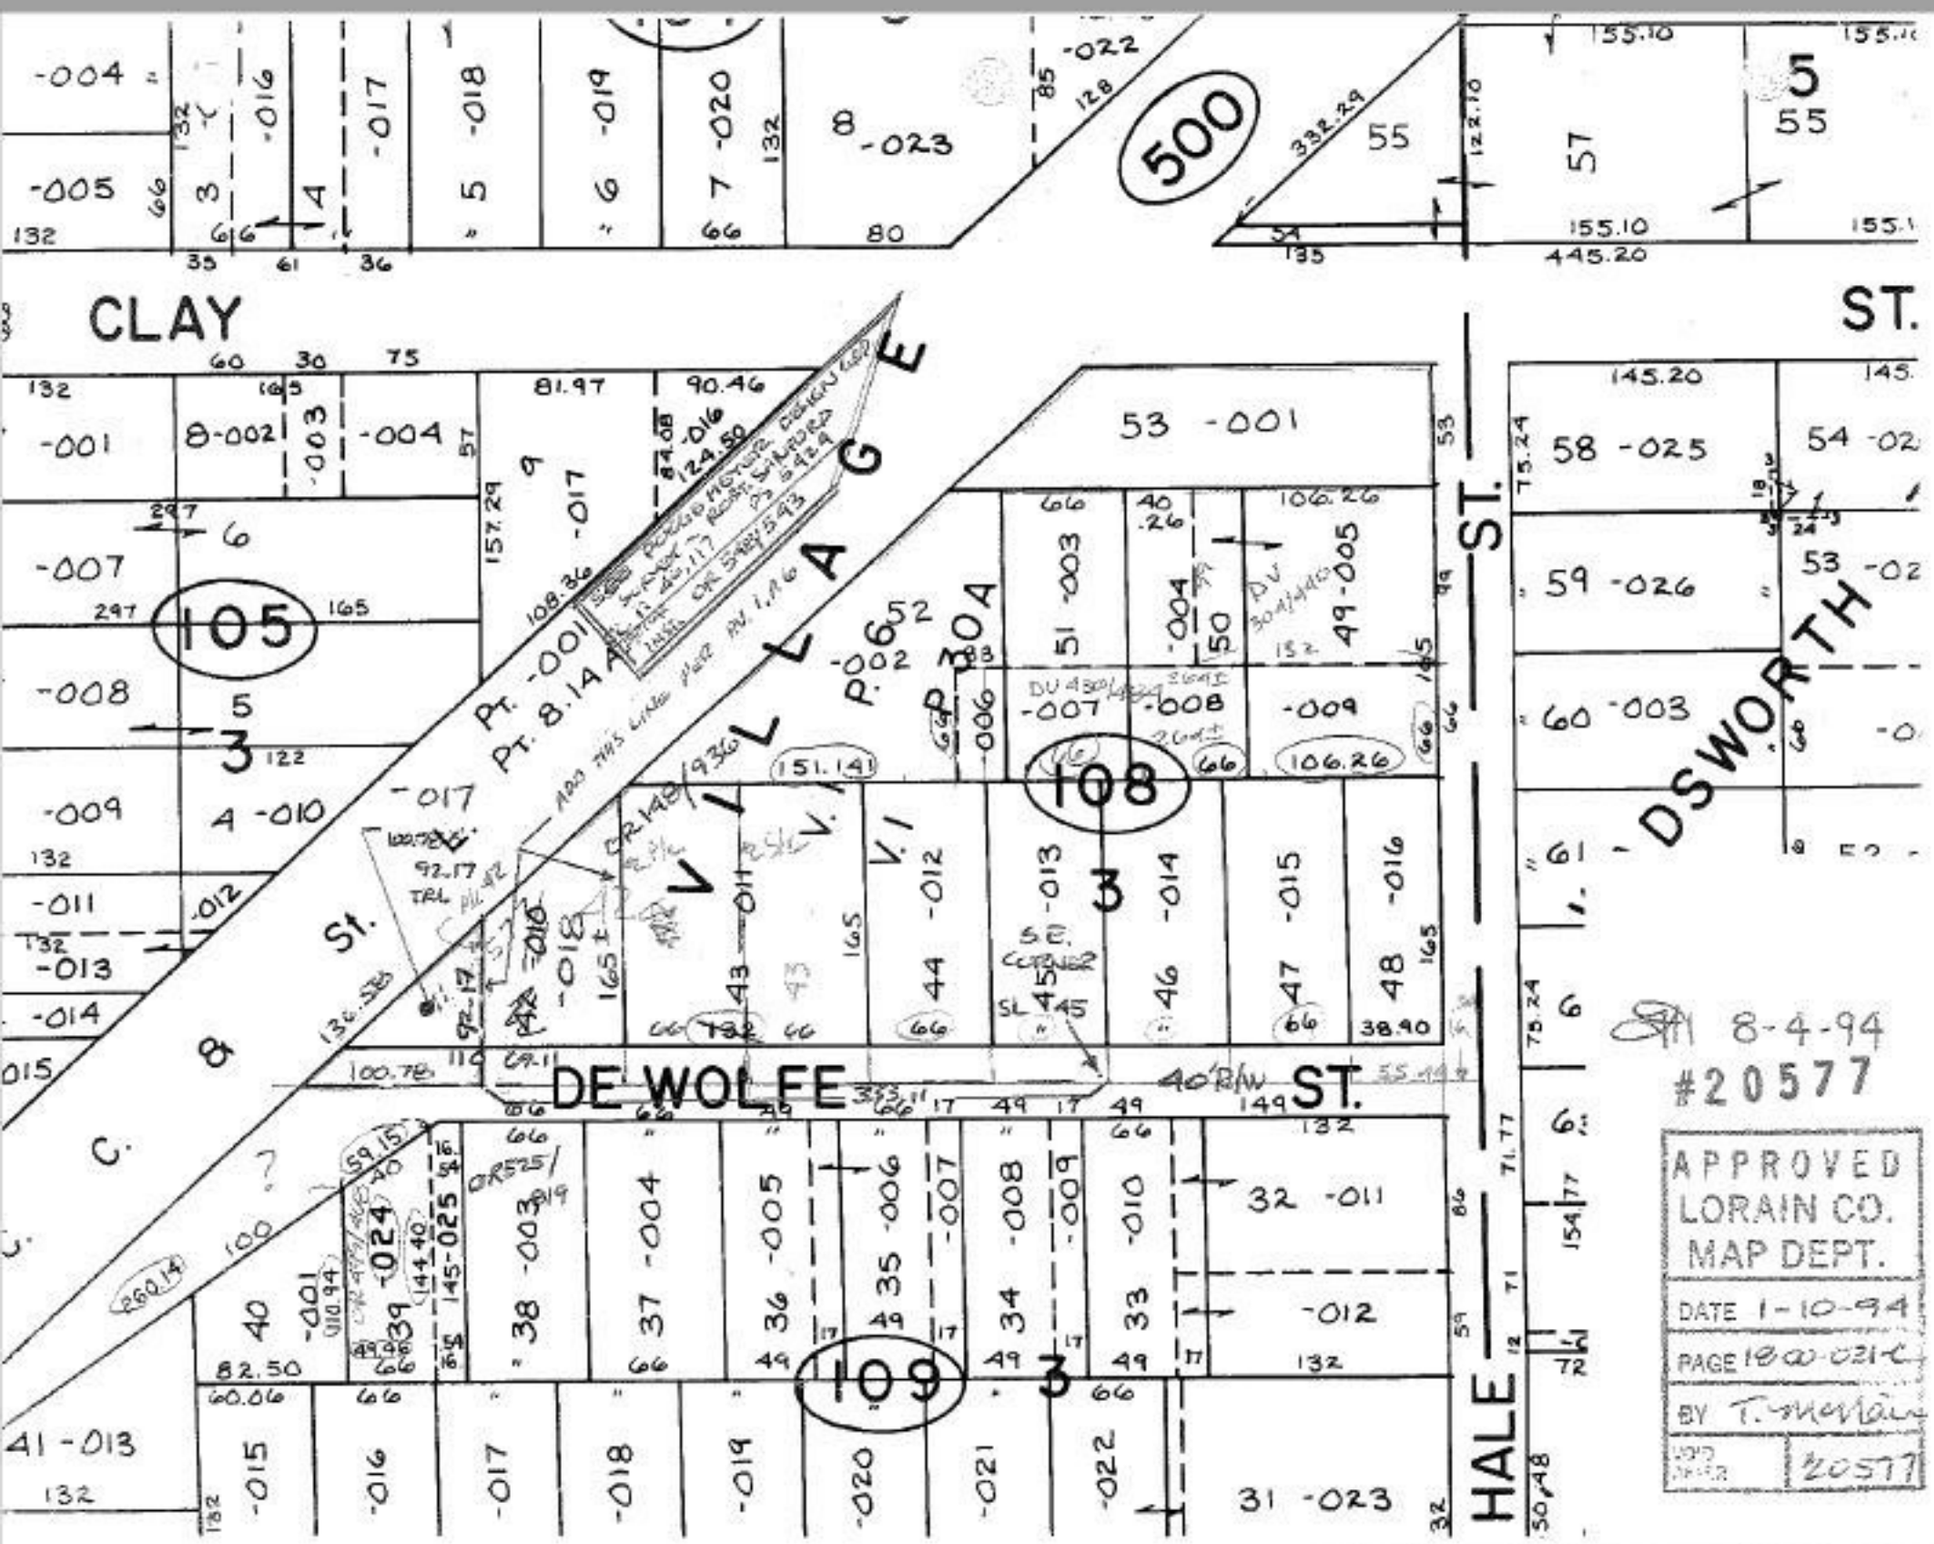
CLAY
ST.
DE WOLFE
ST.
HALE
ST.
DSWORTH
VILLAGE
105
108
109
500
Pt. -001
Pt. 8.14A
P. 6.52
P. 30A
40' R/W
S.E. CORNER
8-4-94
#20577
APPROVED
LORAIN CO.
MAP DEPT.
DATE 1-10-94
PAGE 18-00-021-C
BY T. McNair
VOID AFTER 20577